


LAKE COUNTY  
 ASHTABULA COUNTY  
 LAK-1-12.89  
 ATB-1-0.00

NOTE:  
 SEE SHEET 32 FOR INTERCHANGE QUANTITIES.

RAMP	FROM	TO	DELINATOR LOCATION	
			POST	MTD.
			C-2 (*2)	C-3 (*3)
A	403+08	67+85	75	
	57+55	11+55	X20	
B	1+05	7+65	X	
	77+05	444+98	X23	
C	8+95	77+85	X	
	402+85	403+85	X23	
D	445+49	67+50	75	
	57+56	11+50	X20	

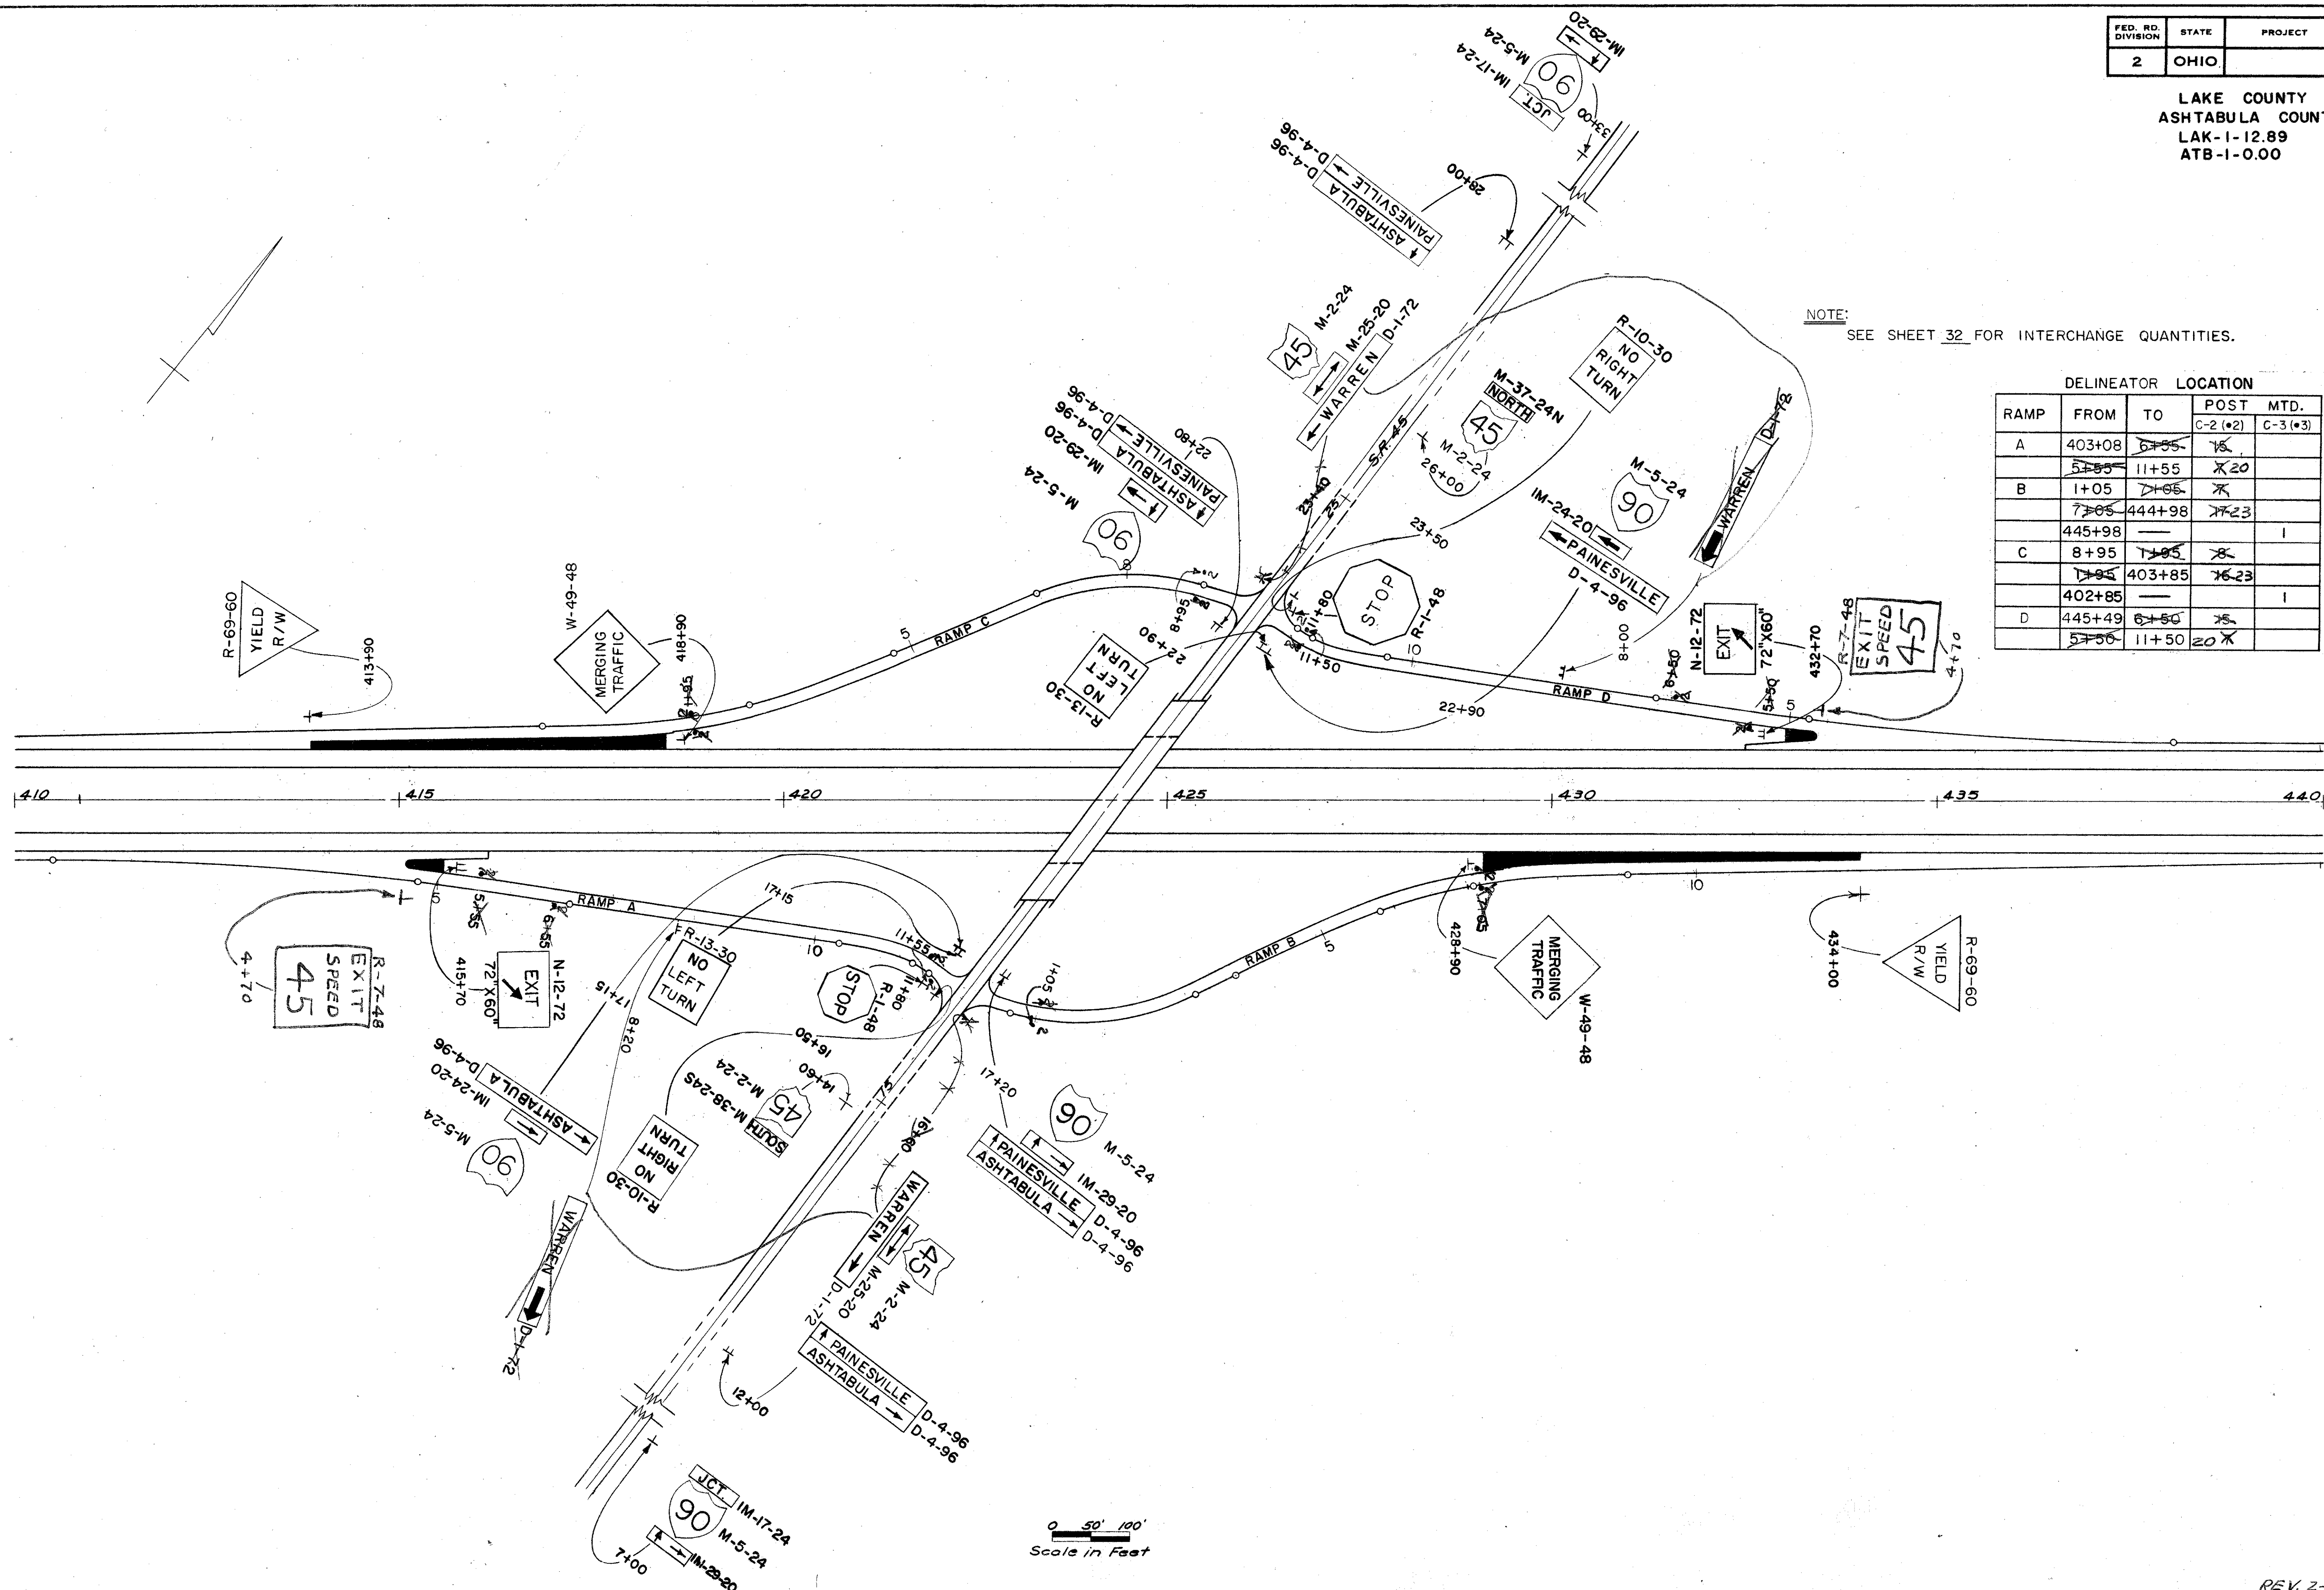

REV. 2-11-60

**S.R. 45 INTERCHANGE**