

1-0


SEEDING
5% P. 98.

280 260 240 220 200 180 160 140 120 100 80 60 40

DATE	BY	SCALE	NO.
2	DM10	ACI-1103 (21)	38
			488

This sheet supersedes sheet no. 38 of the original plan.

LAKE COUNTY
90 LAK-1-12.89
LAK-13.88-17.54

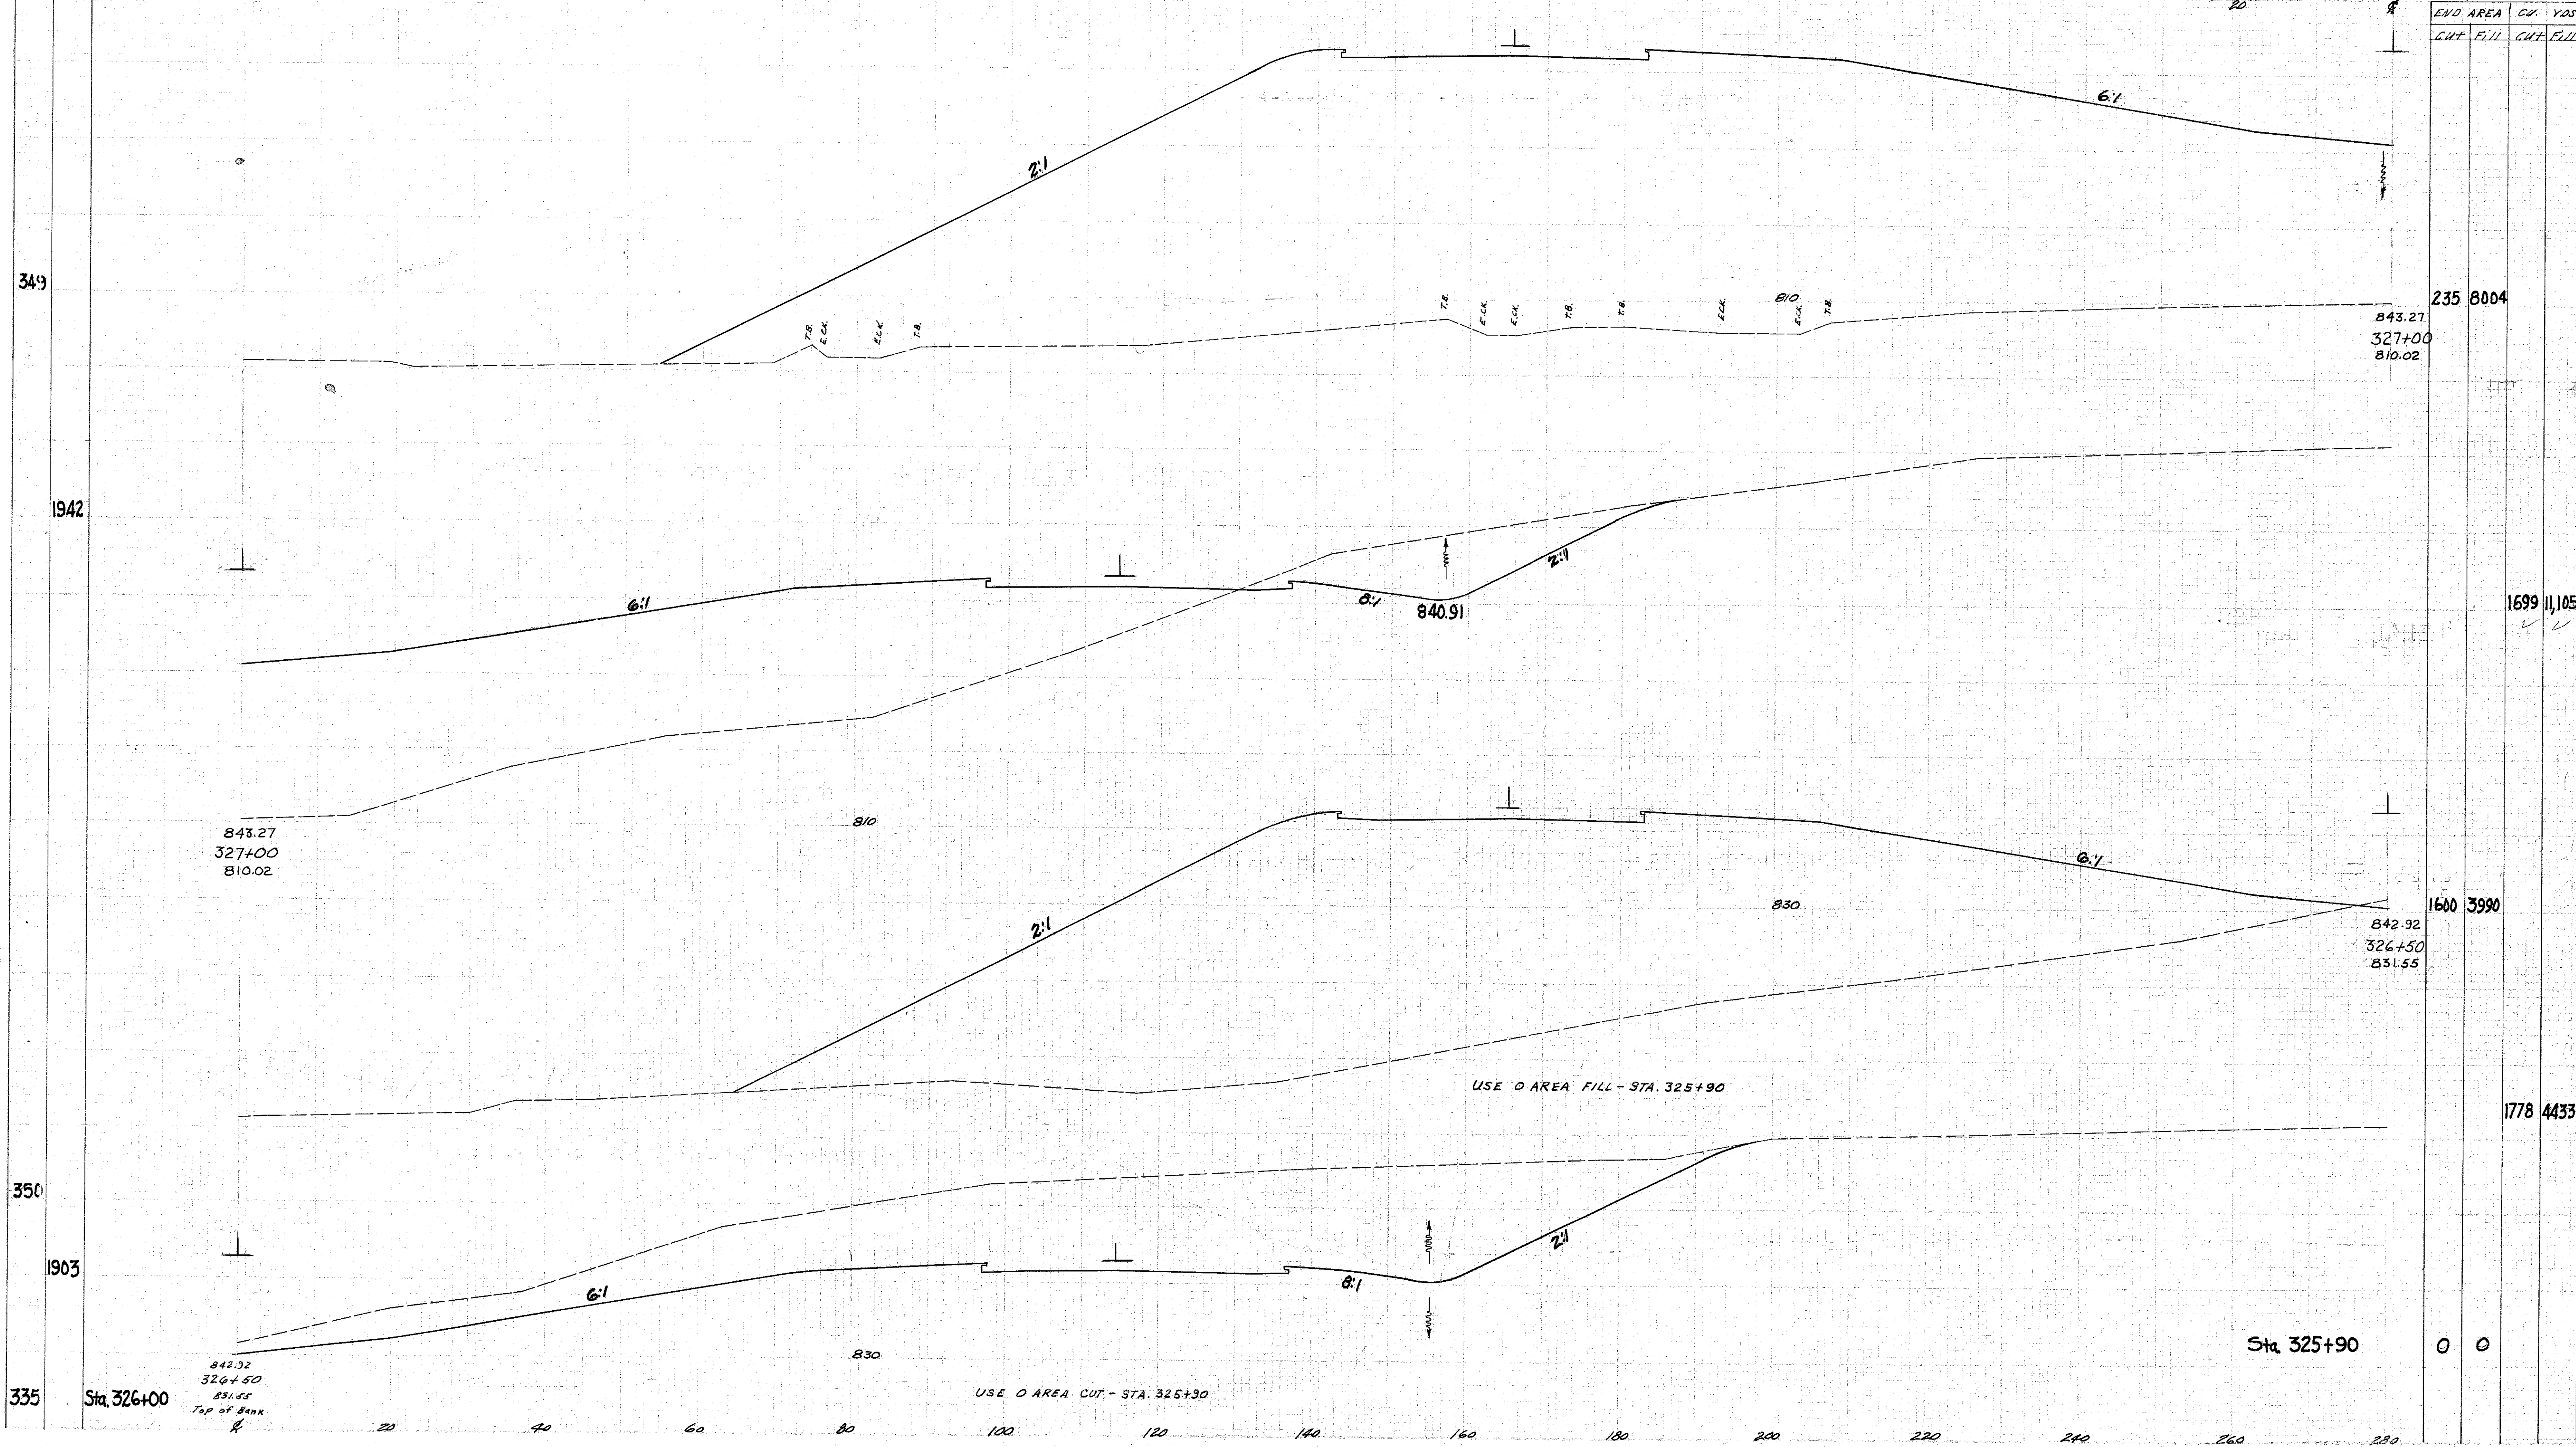

END AREA		CU. YDS.	
CUT	FILL	CUT	FILL
235	8004		
		1699	11,105
		1600	3990
		1778	4433
		0	0

349

1942

350

350

1903

335

235

1699

1600

1778

0

Sta. 326+00

842.92
326+50
831.55
Top of Bank

USE O AREA CUT - STA. 325+30

USE O AREA FILL - STA. 325+90

Sta. 325+90

27 Oct. '58
Sta. 326+50 To 327+00