

SEEDING
FND. WIDTH 36.00


280 260 240 220 200 180 160 140 120 100 80 60 40

JOB NO.	STATE	PROJECT	51 488
2	OHIO	ACI-1103 (21)	

This sheet supersedes sheet no. 51 of the original plan.

LAKE COUNTY
LAK-1-12.89

END AREA		CU.		YDS.	
CUT	FILL	CUT	FILL	CUT	FILL

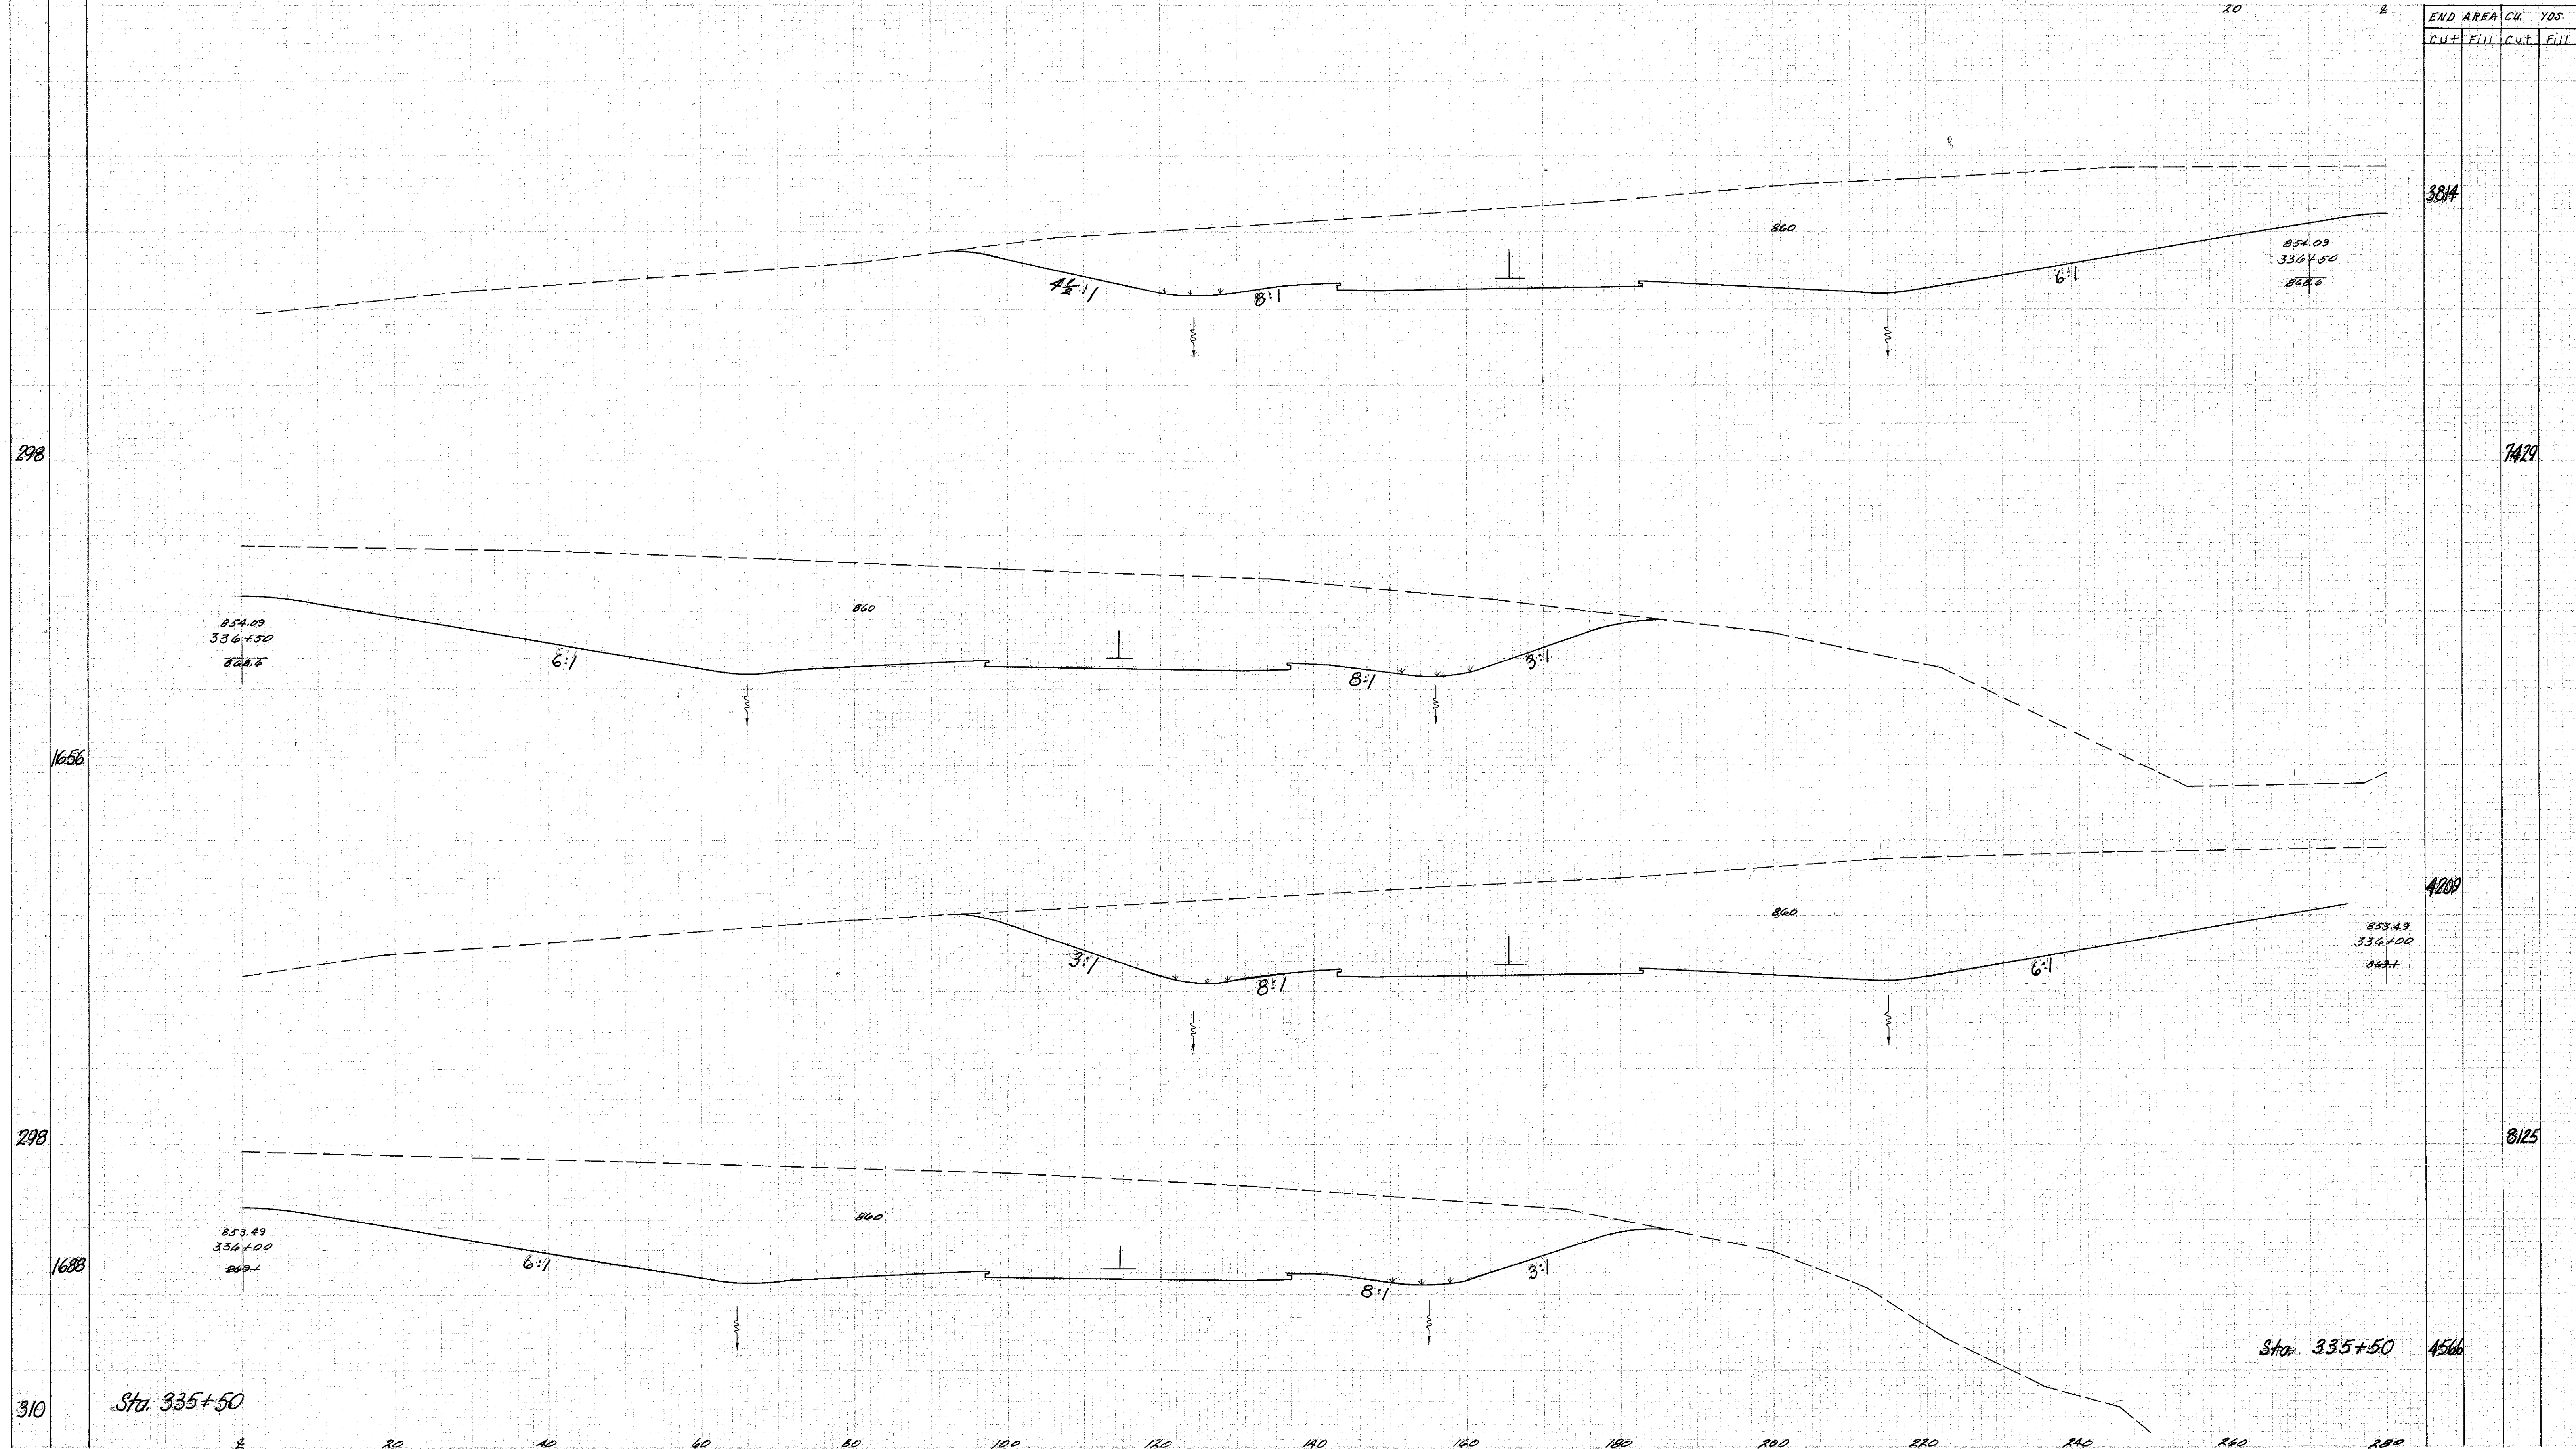

3814

7429

4209

8125

4566

Sta. 335+50

27 Oct. '58 G.M. Sta. 334+00 TO 336+50