


SEEDING 280 260 240 220 200 180 160 140 120 100 80 60 40

NO. OF ADVISORY	STATE	PROJECT	52
2	OHIO	ACI-1103 (21)	488

This sheet supersedes sheet no. 52 of the original plan.

LAKE COUNTY
LAK-1-12.89

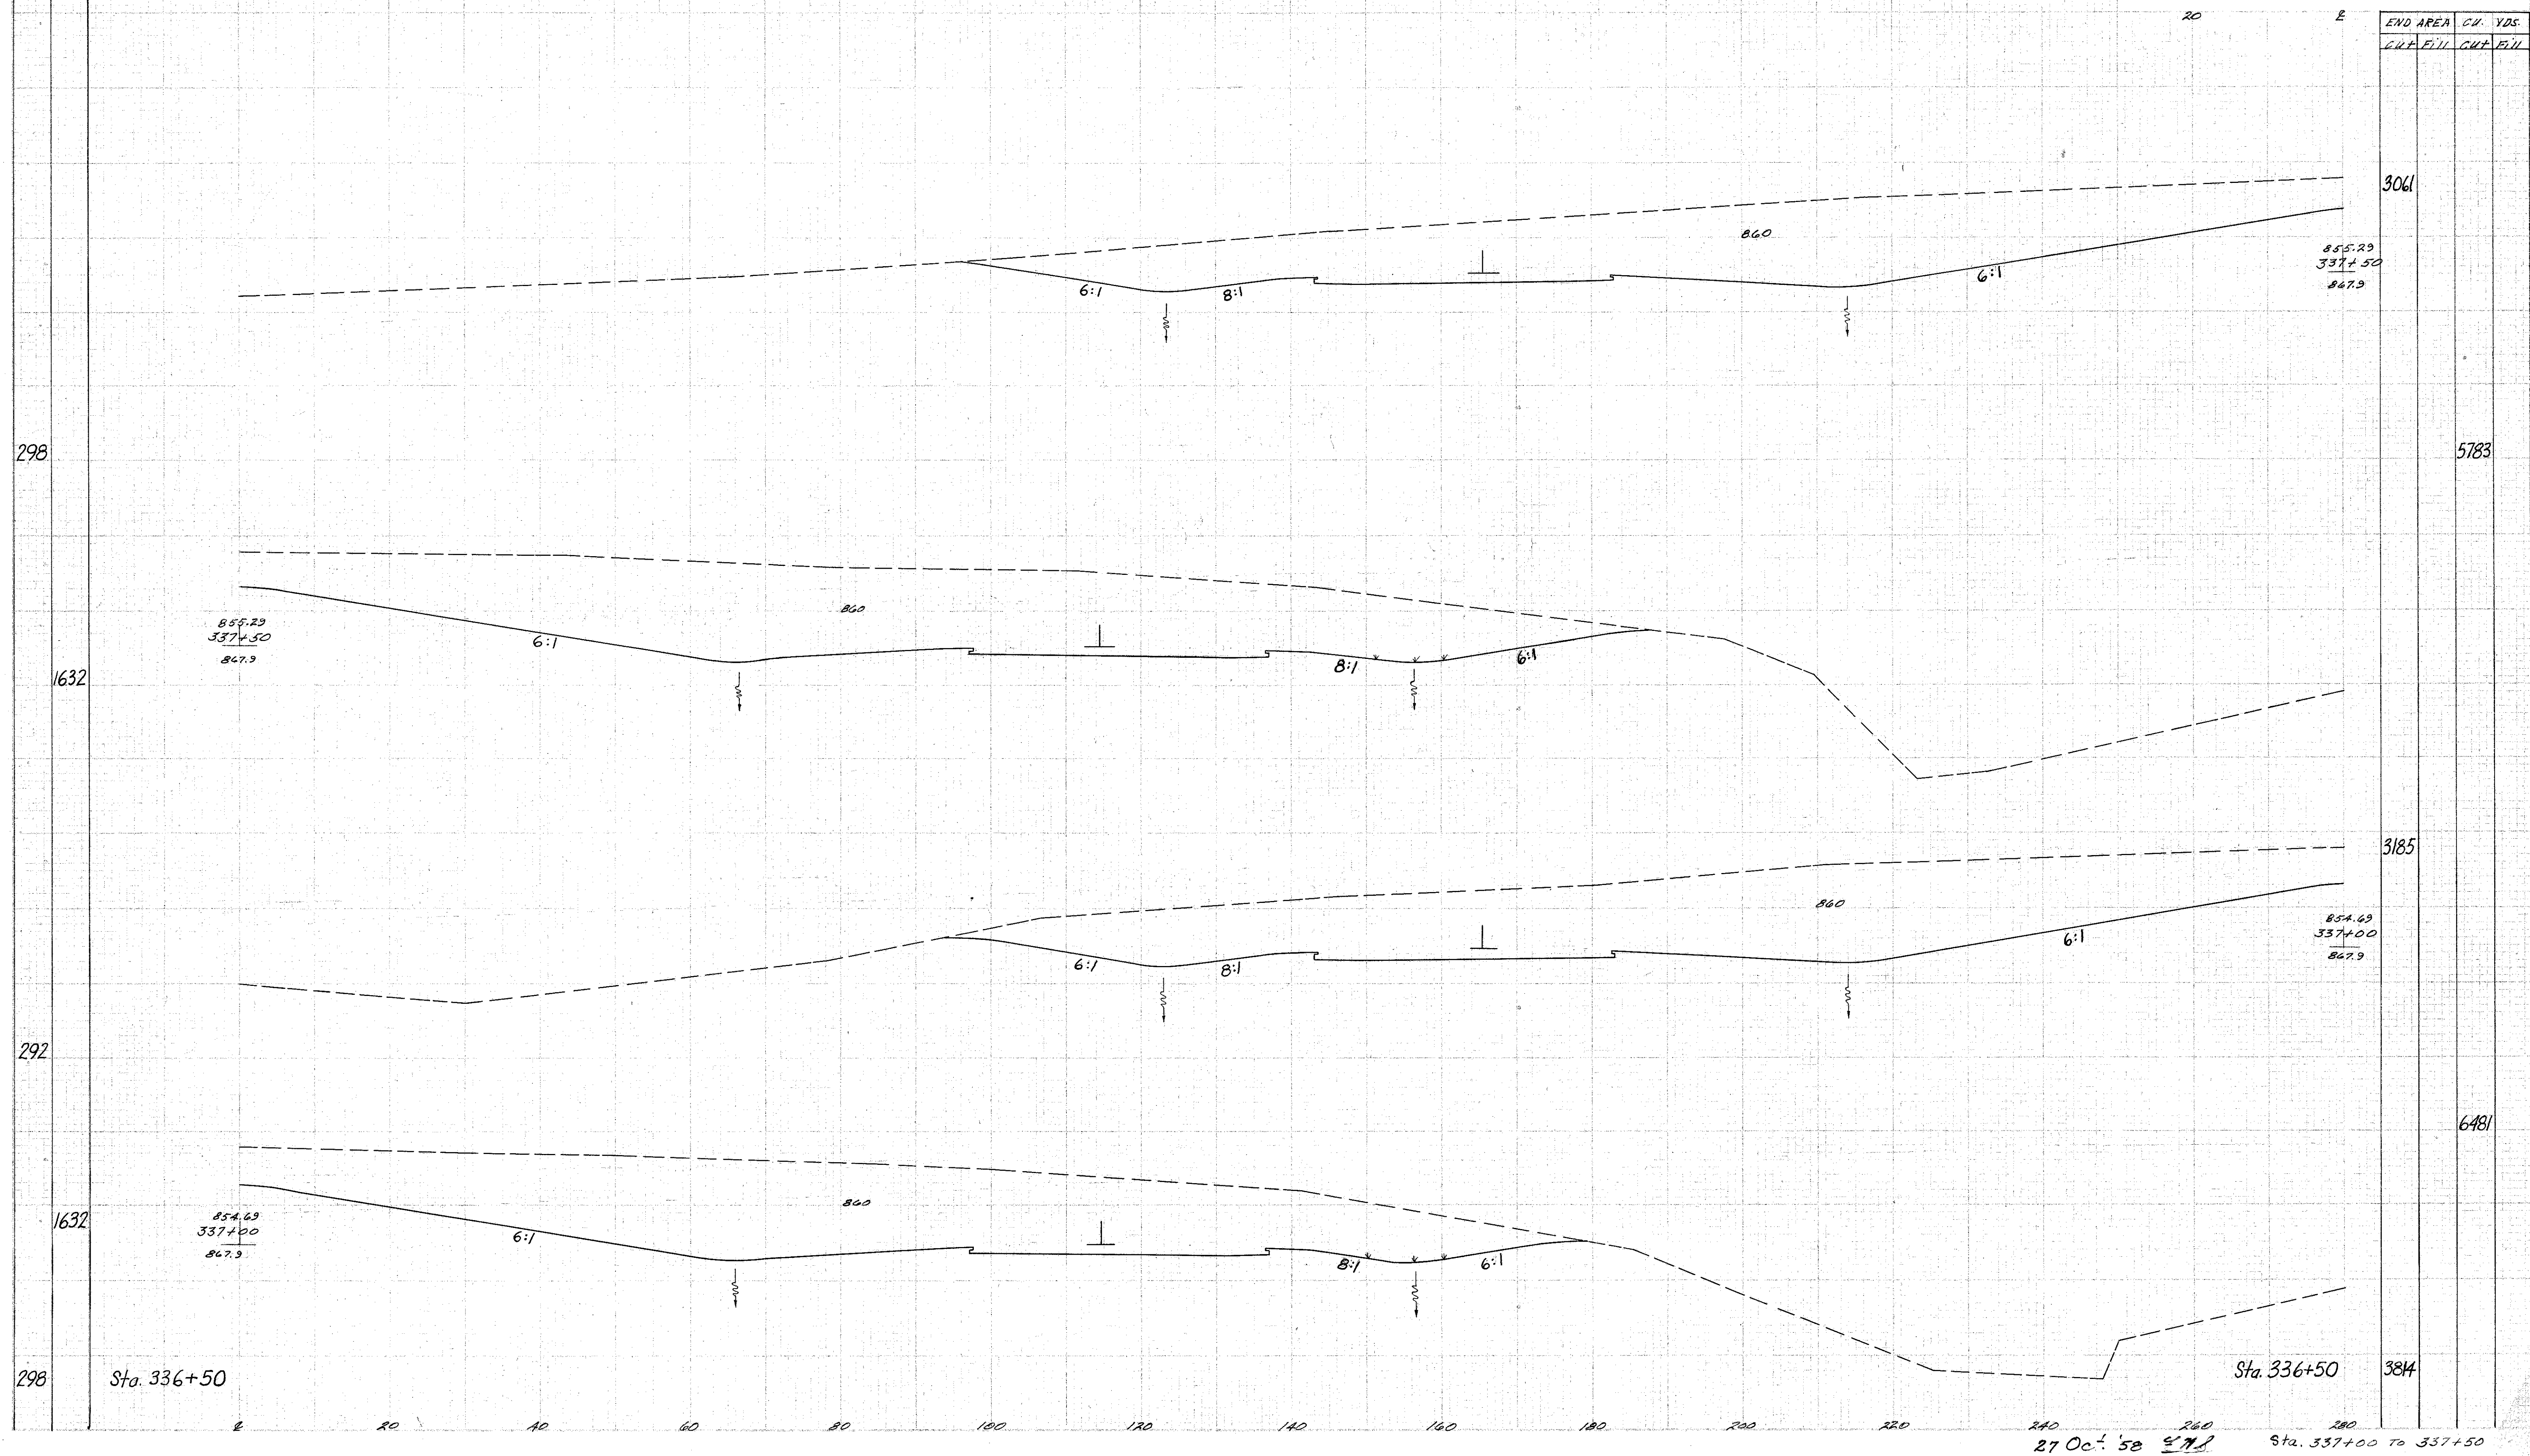

855.29
337+50
847.9

855.29
337+50
847.9

854.69
337+00
847.9

854.69
337+00
847.9

Sta. 336+50

Sta. 336+50

27 Oct '58 270 Sta. 337+00 To 337+50