

SEEDING

EXP. 58


280 260 240 220 200 180 160 140 120 100 80 60 40

FED. DIST. DISTRICT	STATE	PROJECT
2	OHIO	ACI-1103 (21)

57  
488

This sheet supersedes sheet no. 57 of the original plan.

LAKE COUNTY  
LAK-1-12.89

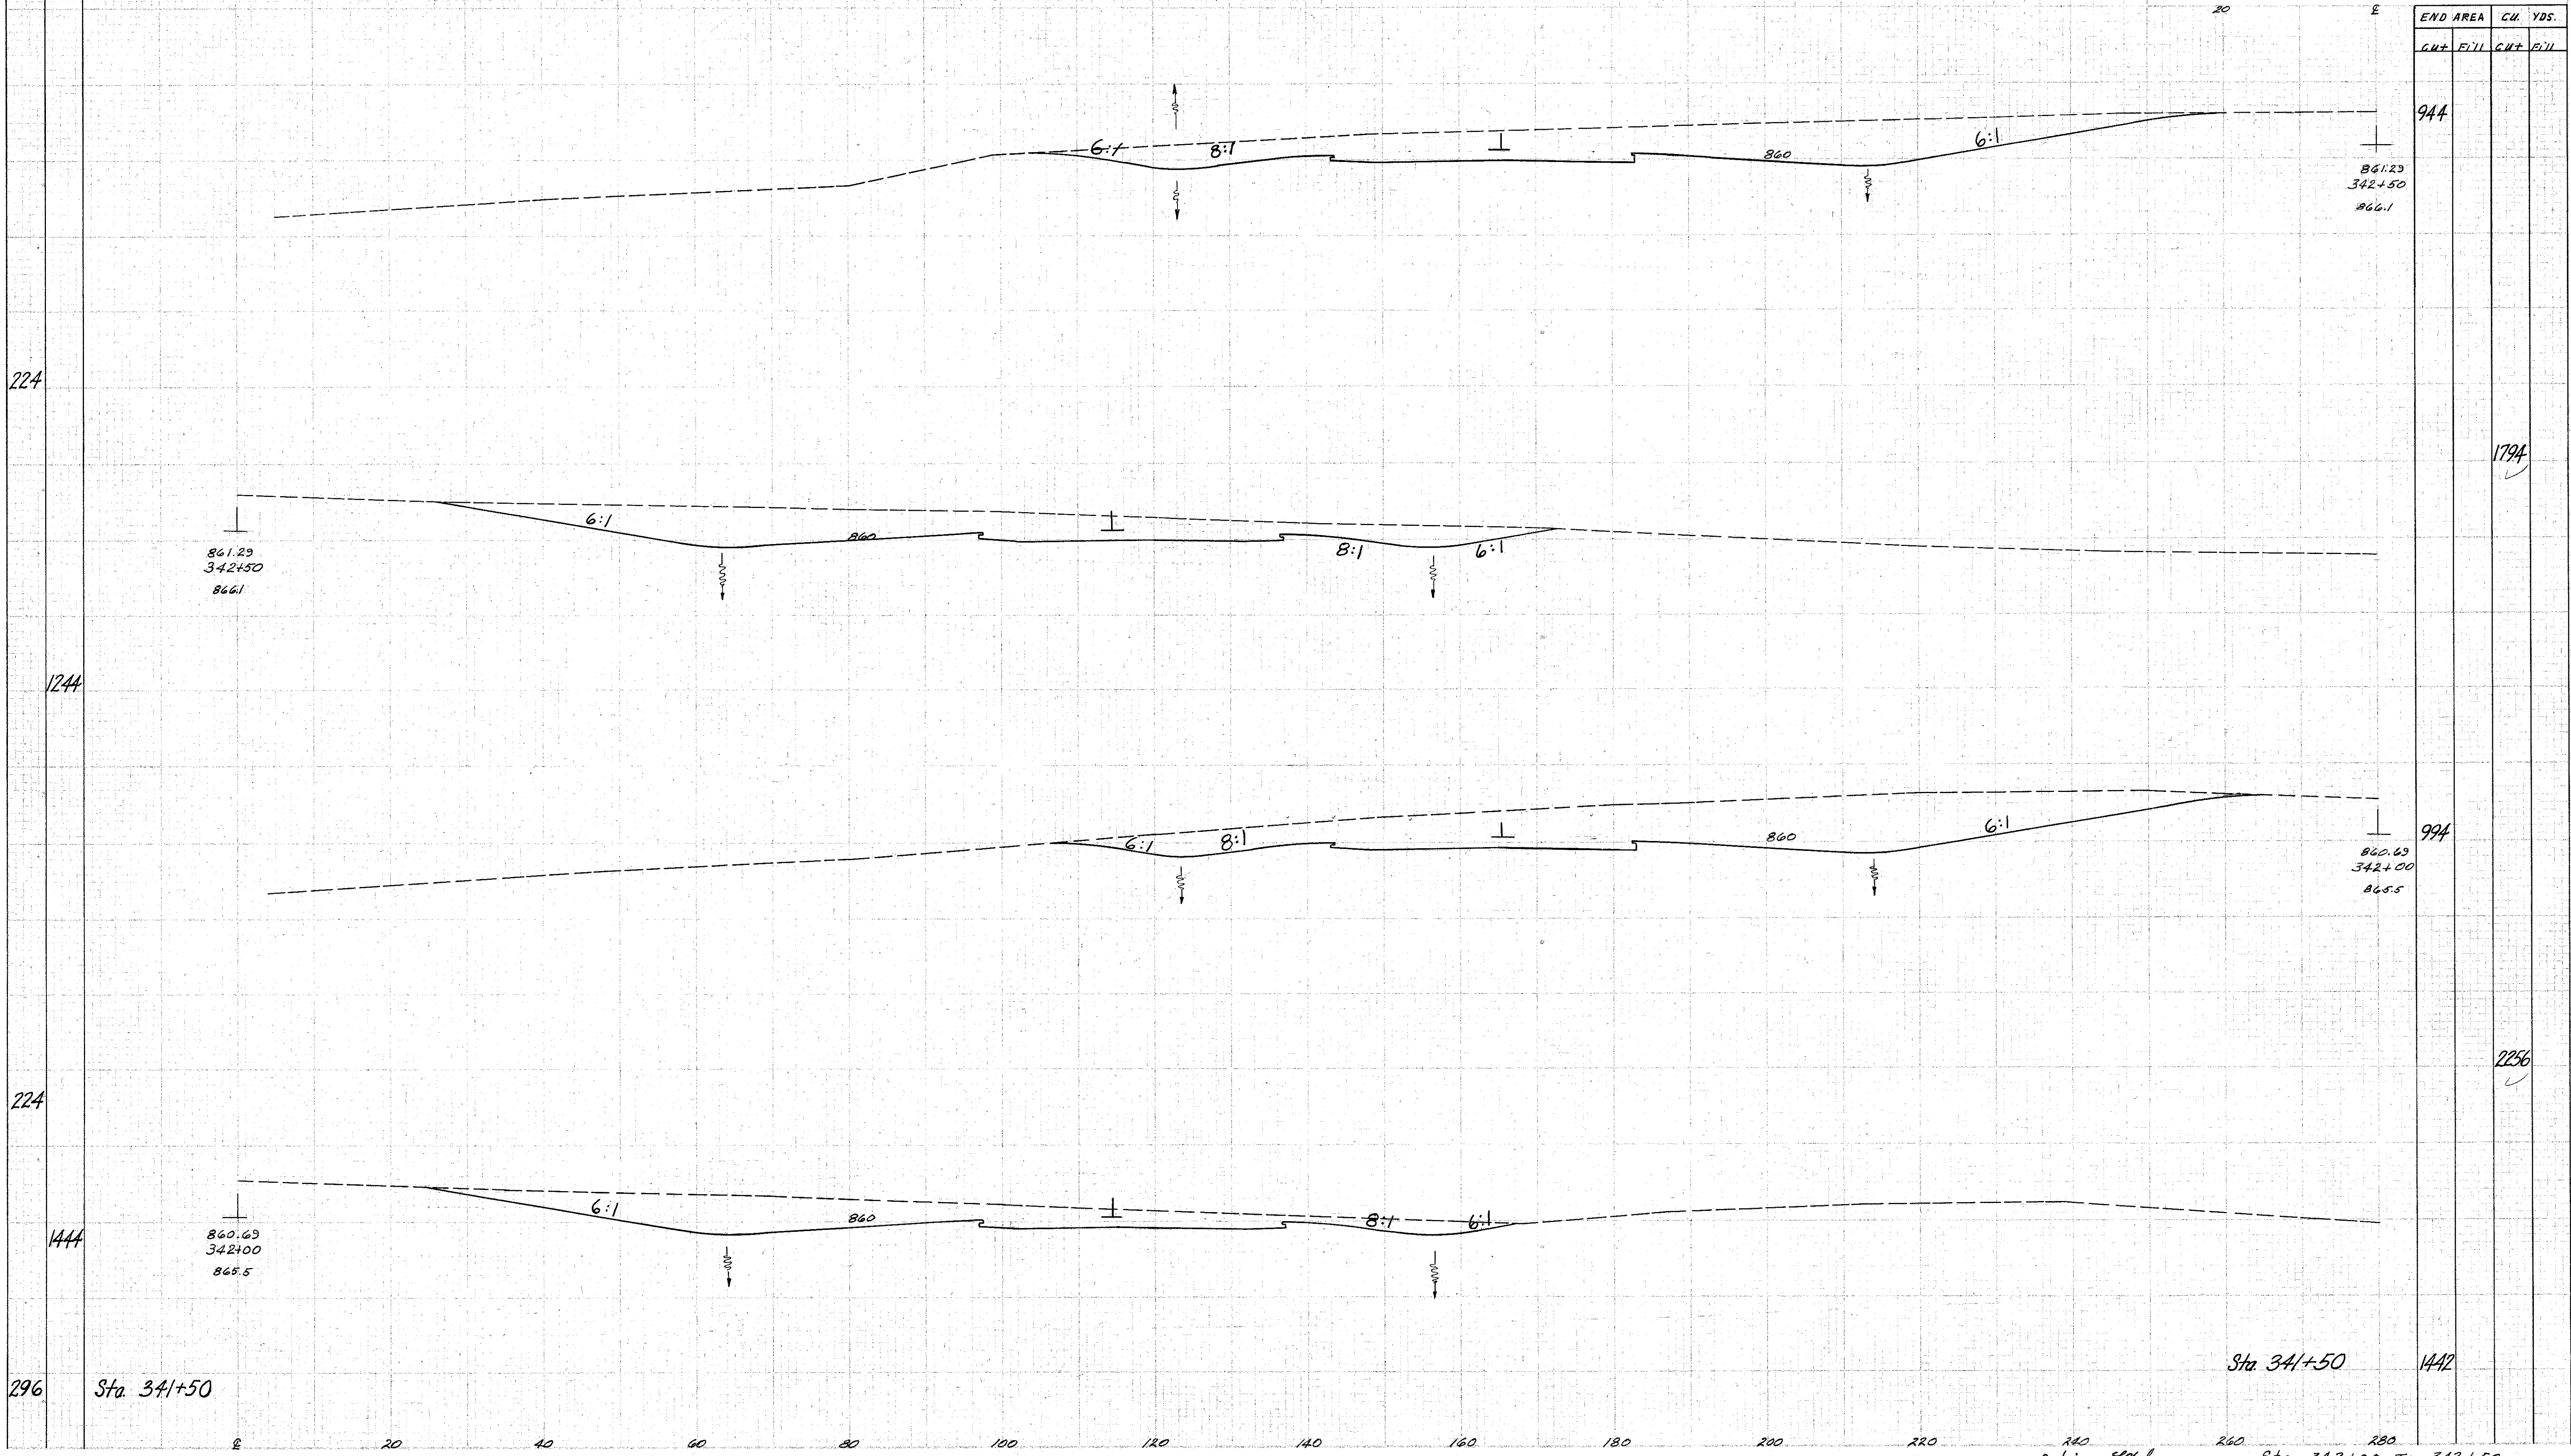

224

1244

224

1444

296

Sta. 341+50

Sta. 341+50

1442

27 Oct. '58

Sta. 342+00 TO 342+50