


SEEDING 280 260 240 220 200 180 160 140 120 100 80 60 40

2	OHIO	ACI-1103 (21)
---	------	---------------

66  
488

This sheet supersedes sheet no. 66  
of the original plan.

LAKE COUNTY  
LAK-1-12.89

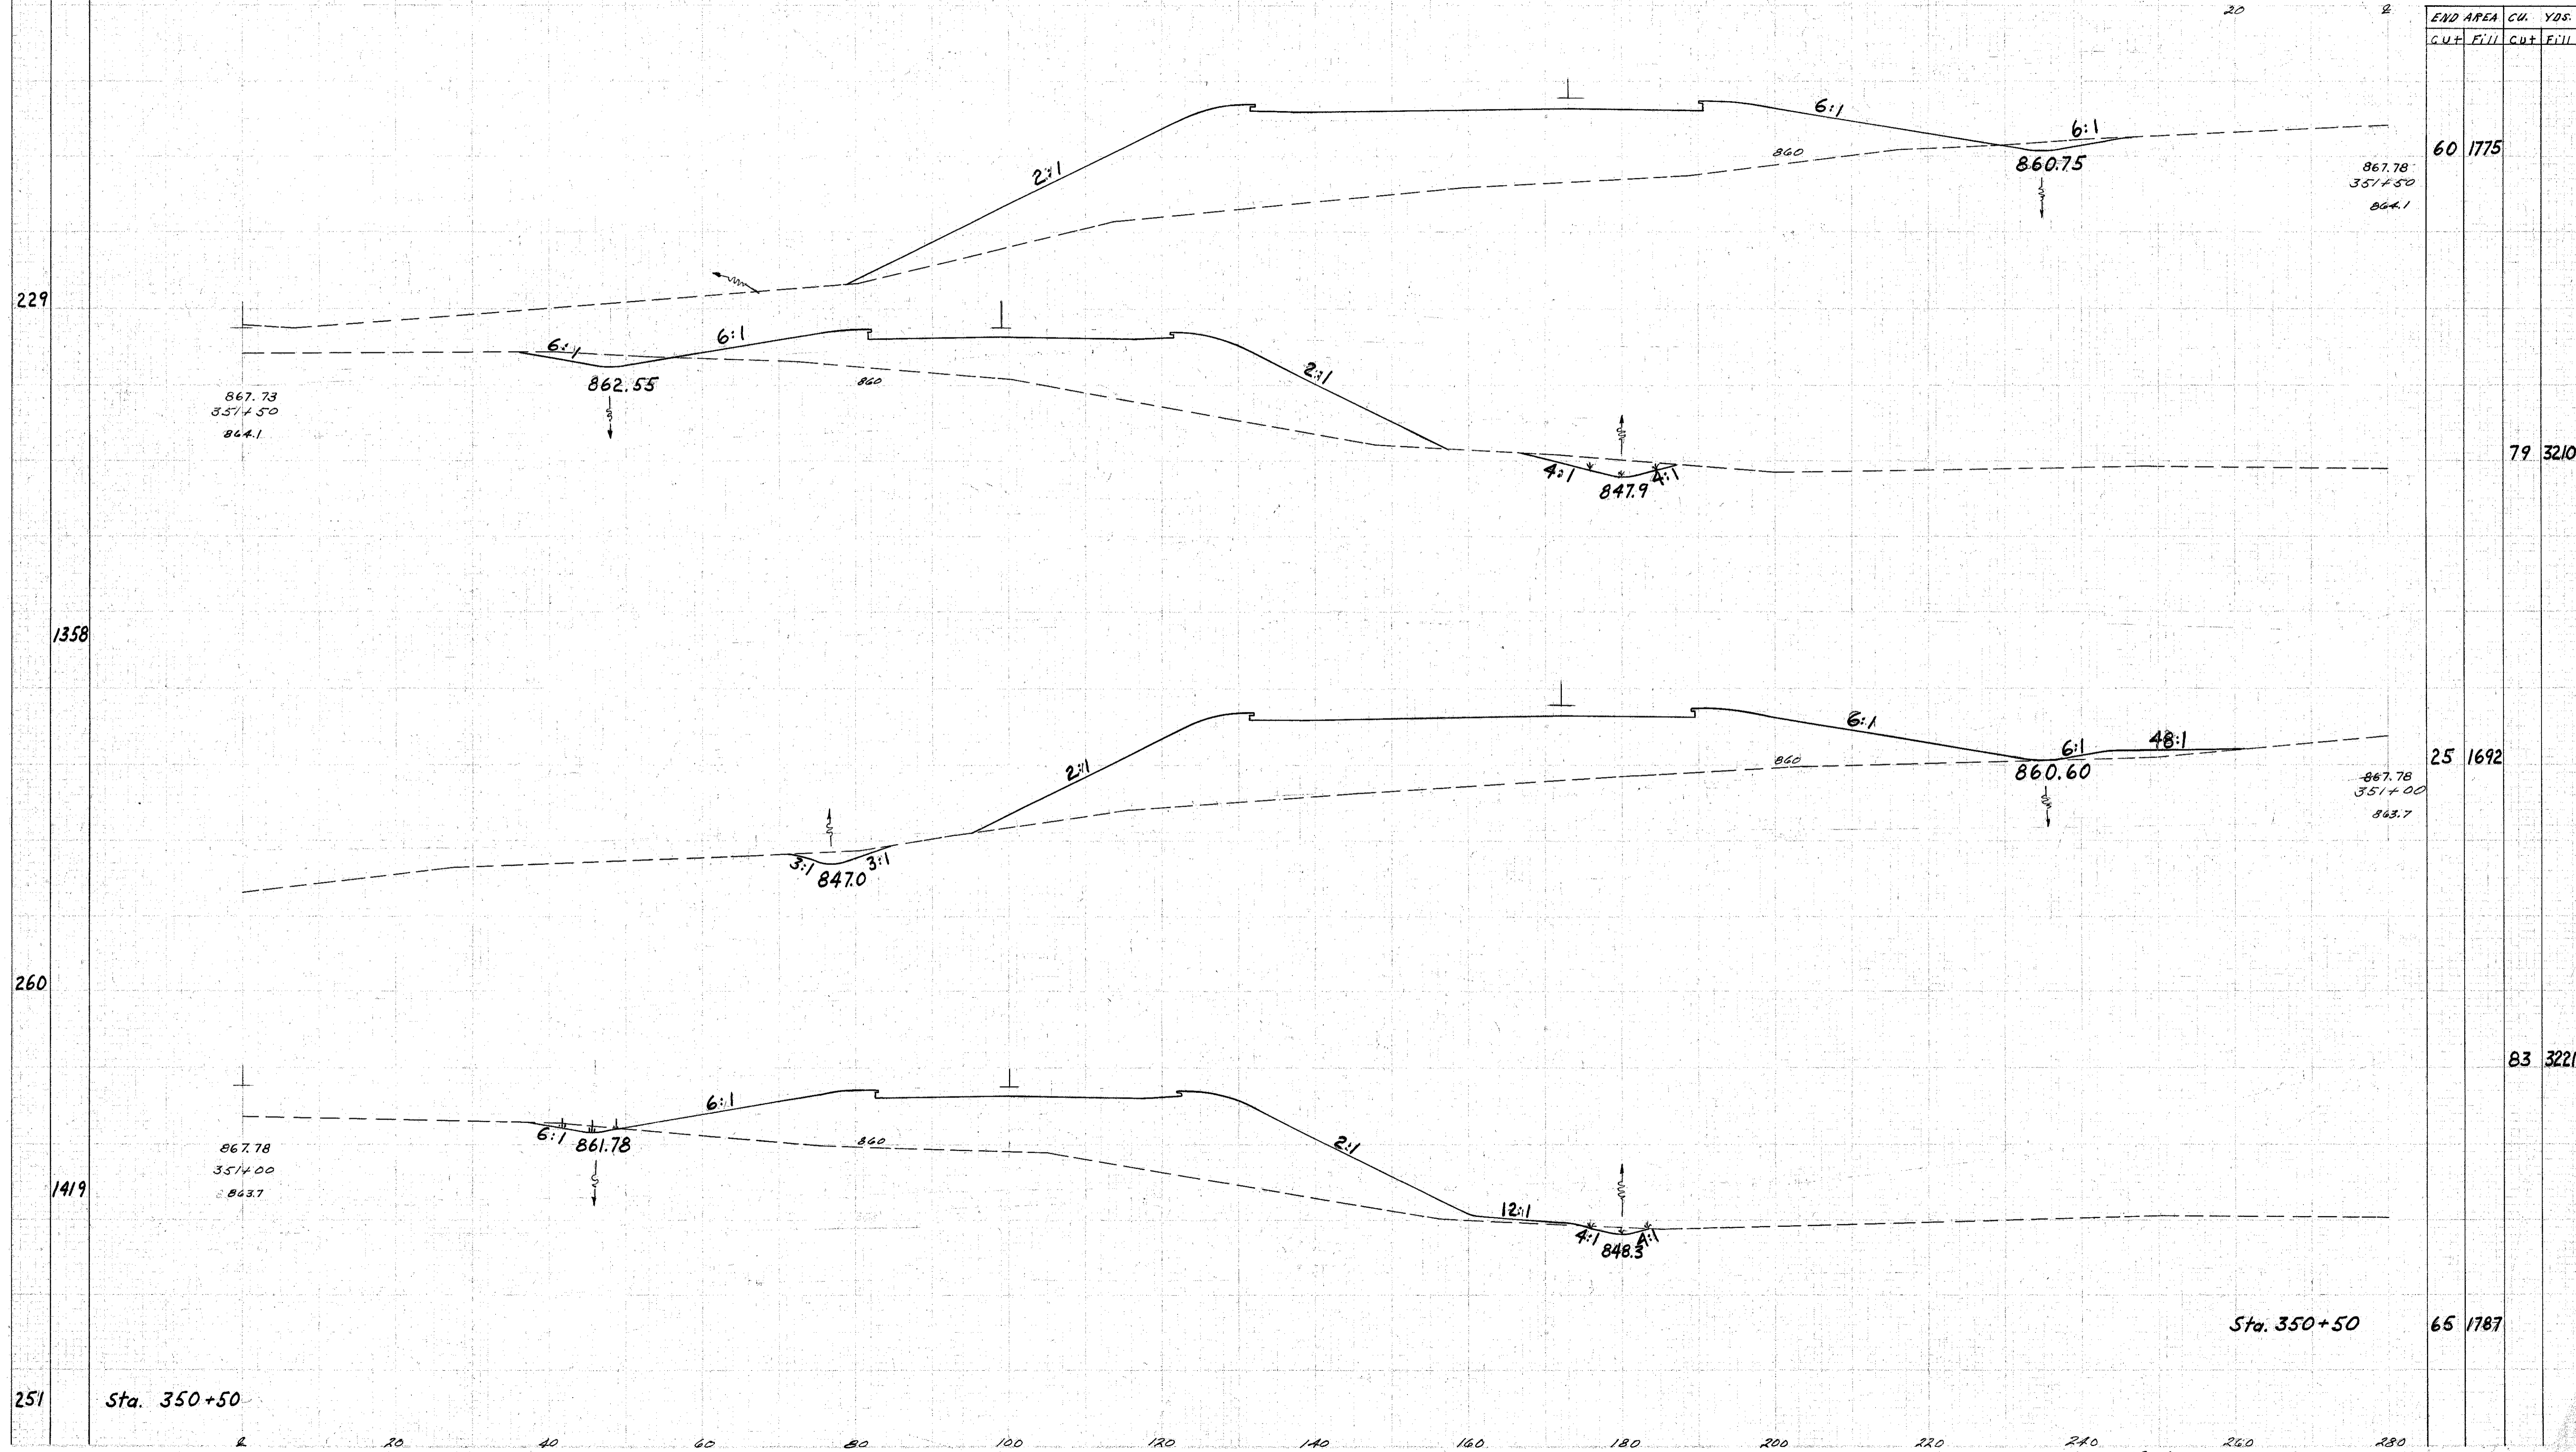

END AREA		CU. YDS.	
CUT	FILL	CUT	FILL
60	1775		
79	3210		
25	1692		
83	3221		
65	1787		

27 Oct. '58 *[Signature]* Sta. 351+00 to 351+50