

SEALING
END AREA
SQ. YDS.


280 260 240 220 200 180 160 140 120 100 80 60 40

ACI-1103 (21)

69
488

This sheet supersedes sheet no. 69
of the original plan.

LAKE COUNTY
LAK-1-12.89

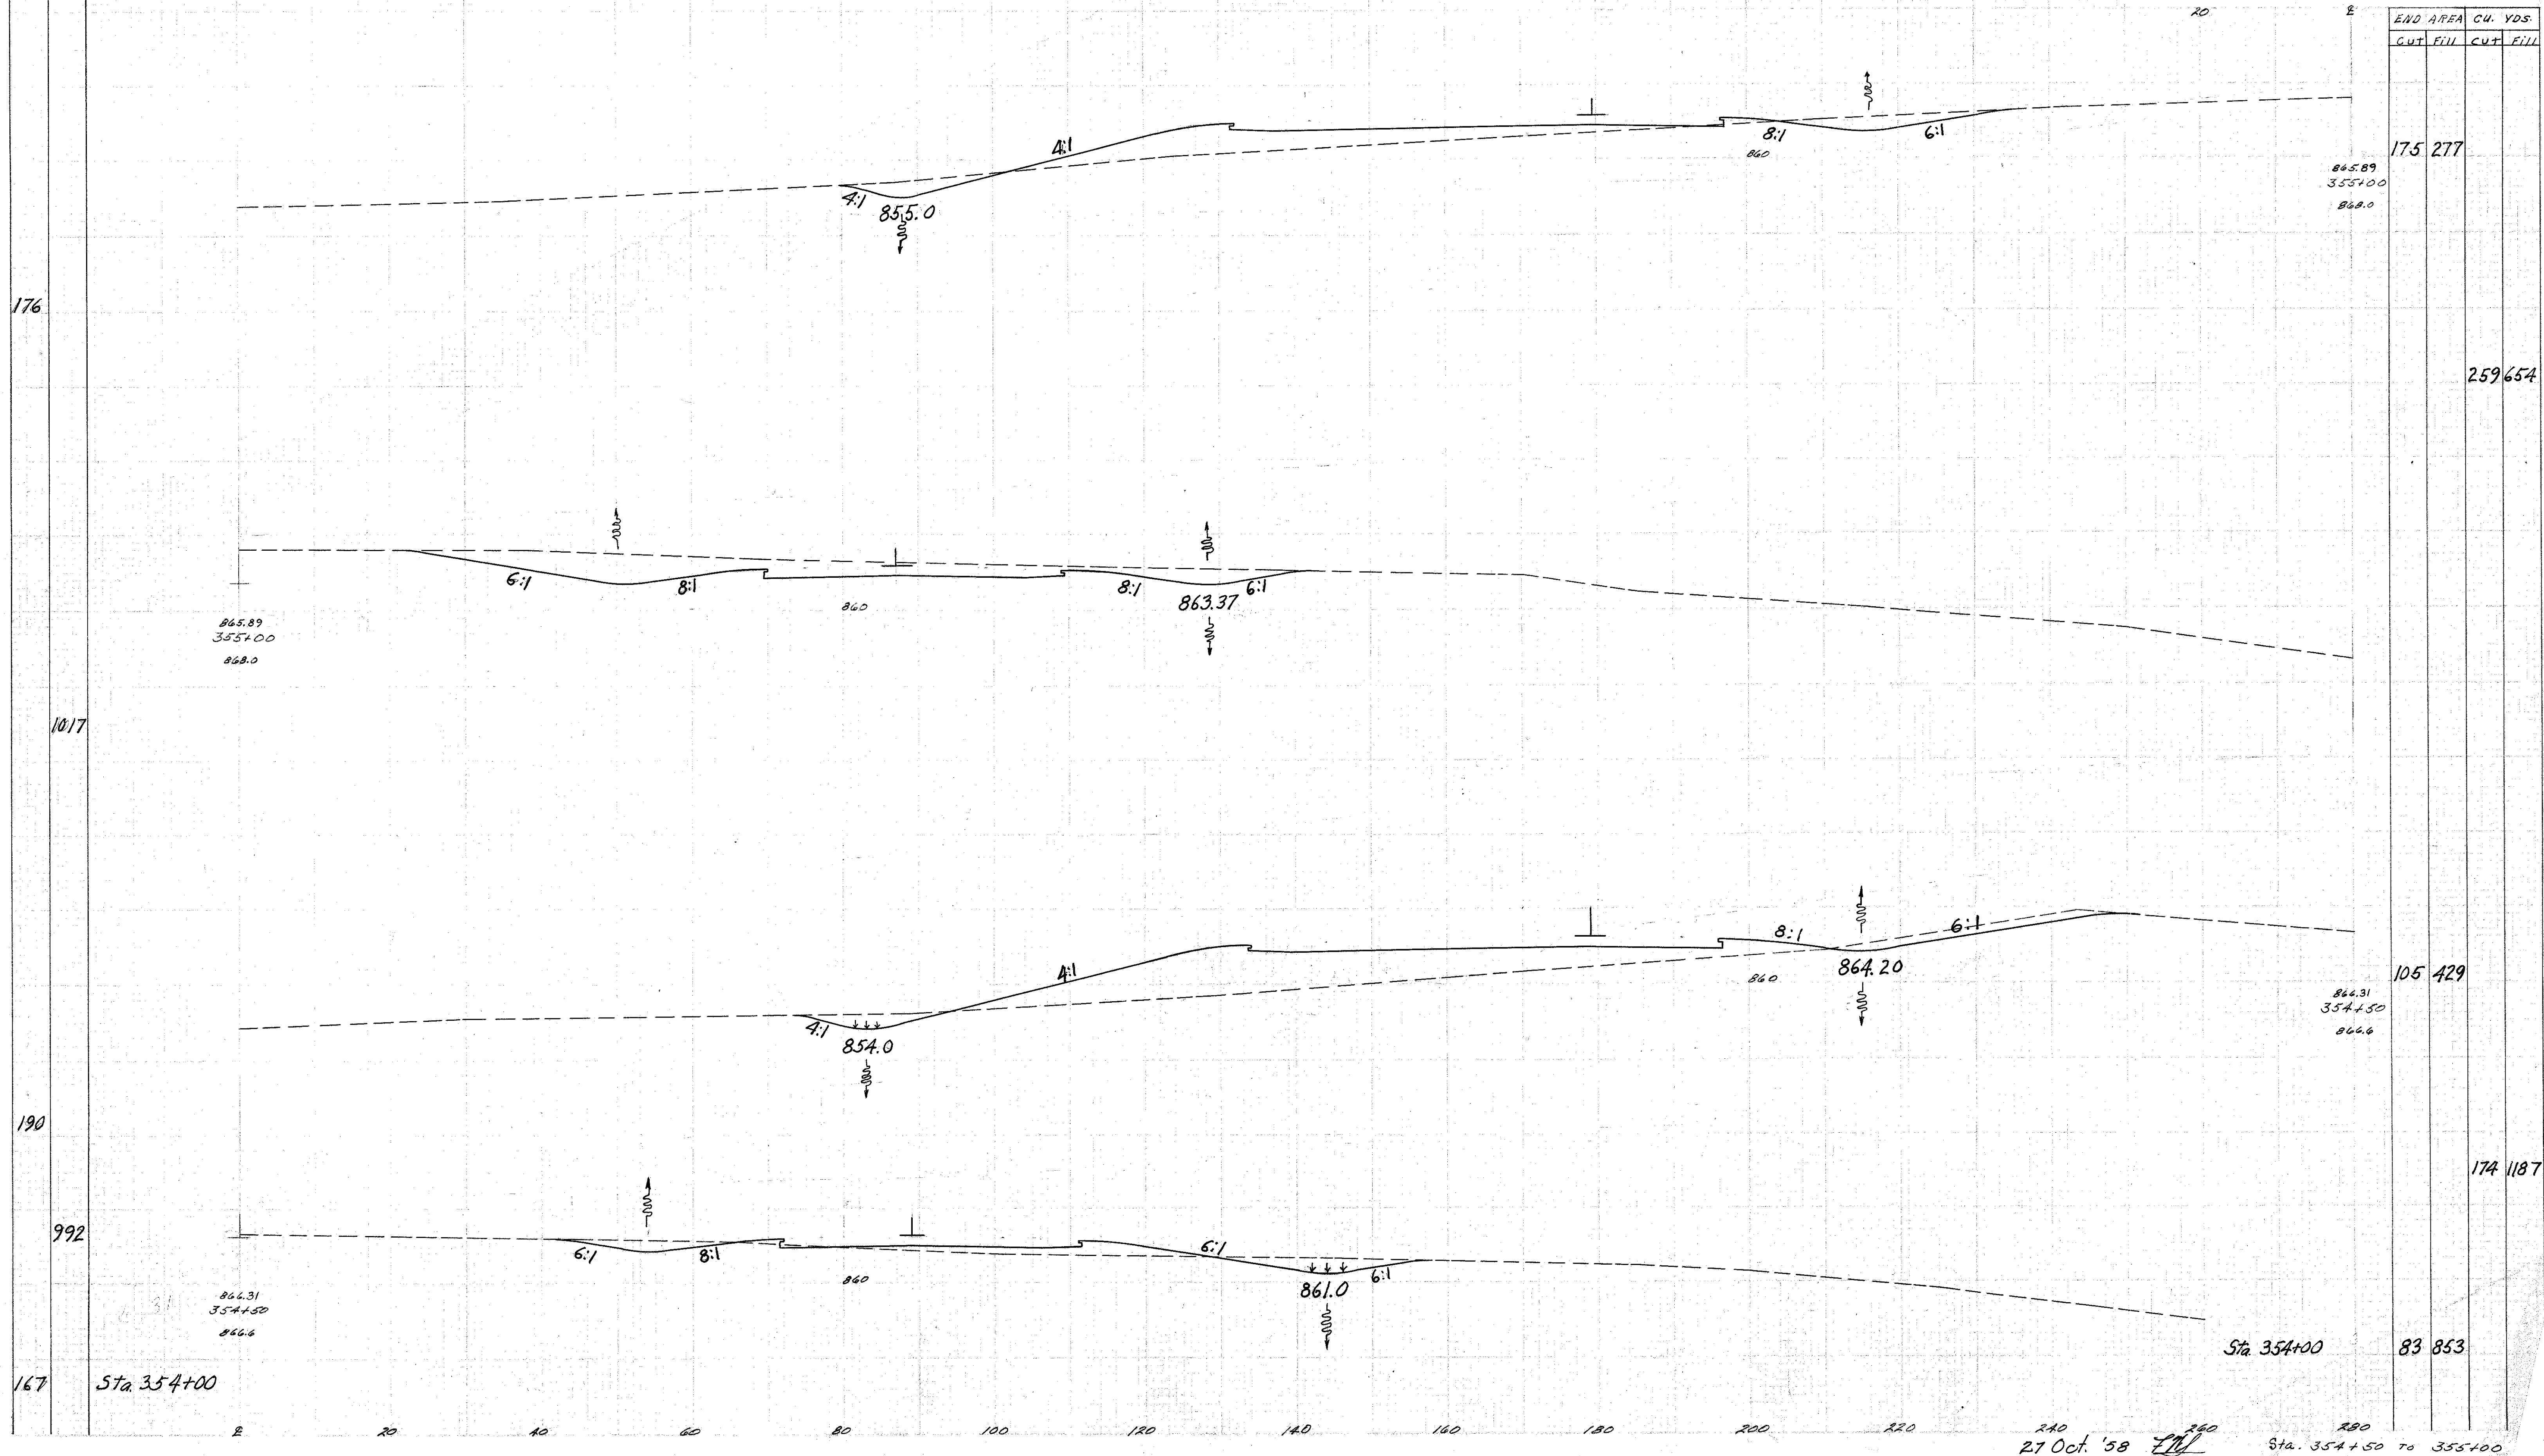

END AREA		CU. YDS.	
CUT	FILL	CUT	FILL
175	277		
259	654		
105	429		
174	1187		
83	853		

27 Oct. '58
Sta. 354+50 to 355+00