


SEEDING  
END WIDTH SQ. YDS.

|   |      |               |           |
|---|------|---------------|-----------|
| 2 | OHIO | ACI-1103 (21) | 70<br>488 |
|---|------|---------------|-----------|

This sheet supersedes sheet no. 70 of the original plan.

LAKE COUNTY  
LAK-1 - 12.89

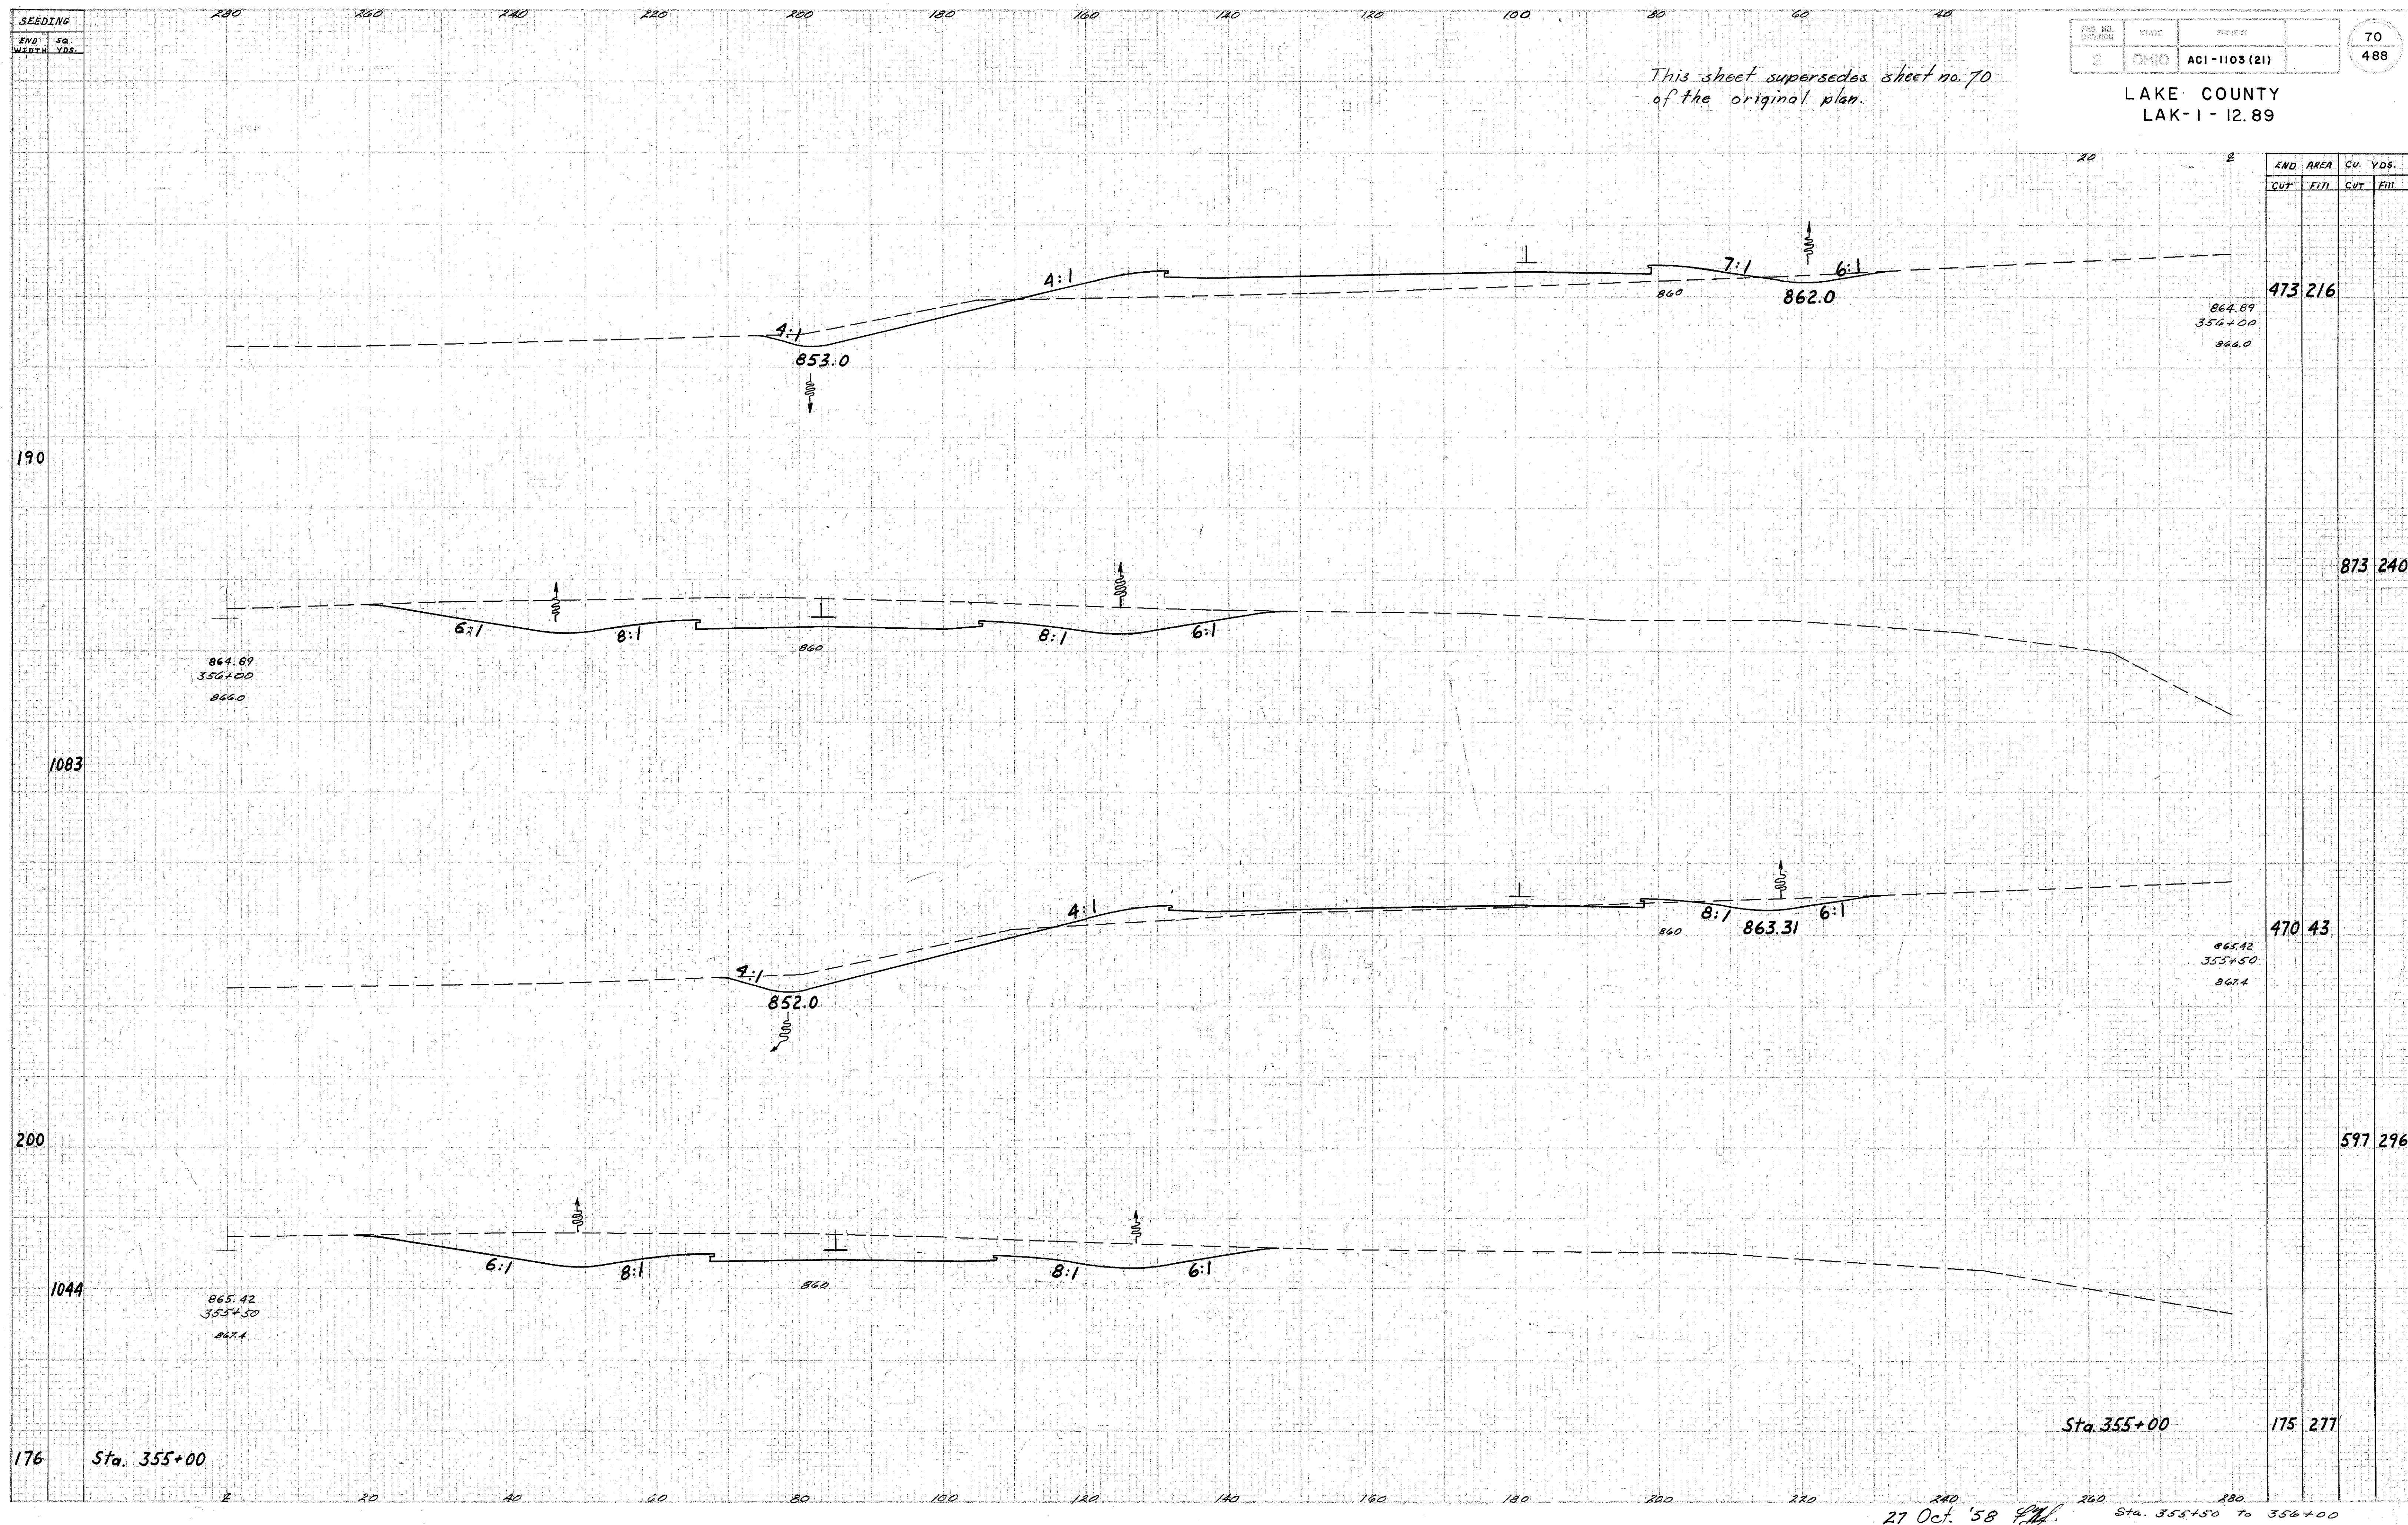

27 Oct. '58 *[Signature]*  
Sta. 355+50 To 356+00