


SEEDING: 280 260 240 220 200 180 160 140 120 100 80 60 40

DES. DIV. DEPARTMENT	STATE	PROJECT	72 488
2	OHIO	ACI-1103(21)	

This sheet supersedes sheet no. 72
of the original plan.

LAKE COUNTY
LAK-1-12.89

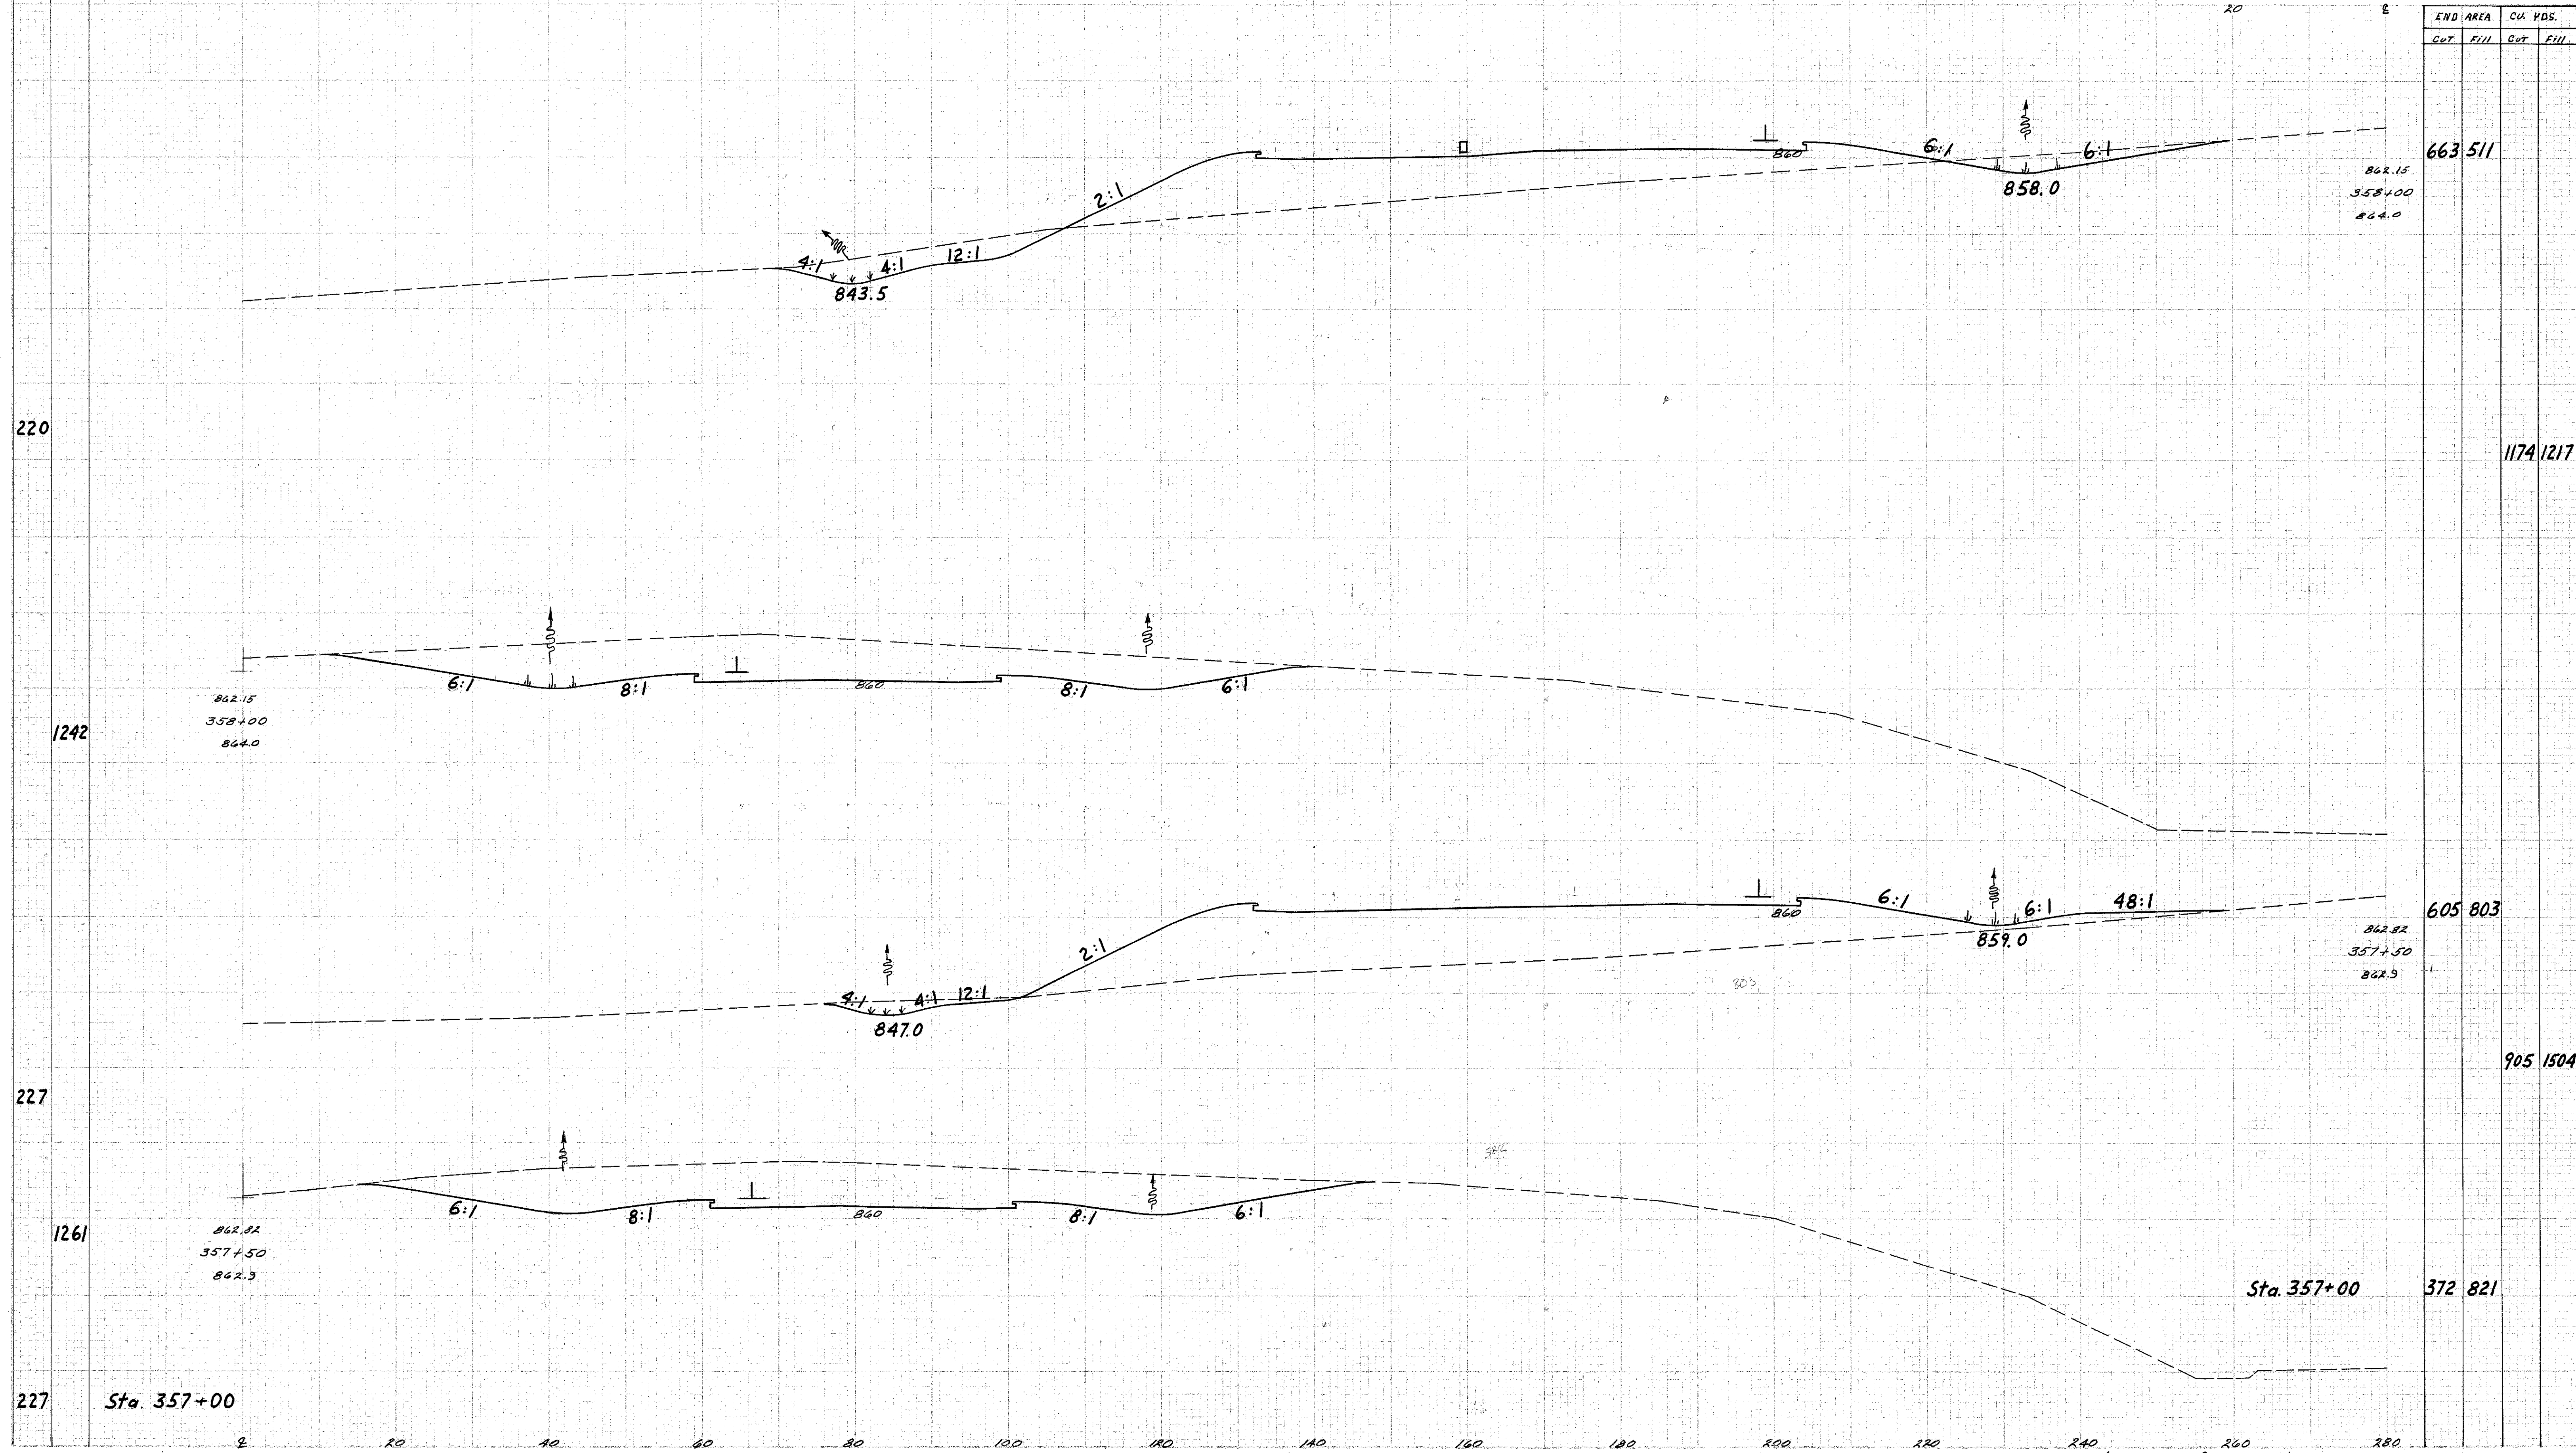

END AREA		CU. YDS.	
Cut	Fill	Cut	Fill
		663	511
		862.15	
		358+00	
		864.0	
		1174	1217
		605	803
		862.82	
		357+50	
		862.9	
		905	1504
		372	821

27 Oct. '58 *[Signature]* Sta. 357+50 to 358+00