


SEEDING  
END STA.  
WIDTH YDS.

JOB NO. DIVISION	STATE	PROJECT	79 488
2	OHIO	ACI-1103 (21)	

This sheet supersedes sheet no. 19  
of the original plan.

LAKE COUNTY  
LAK-1-12.89

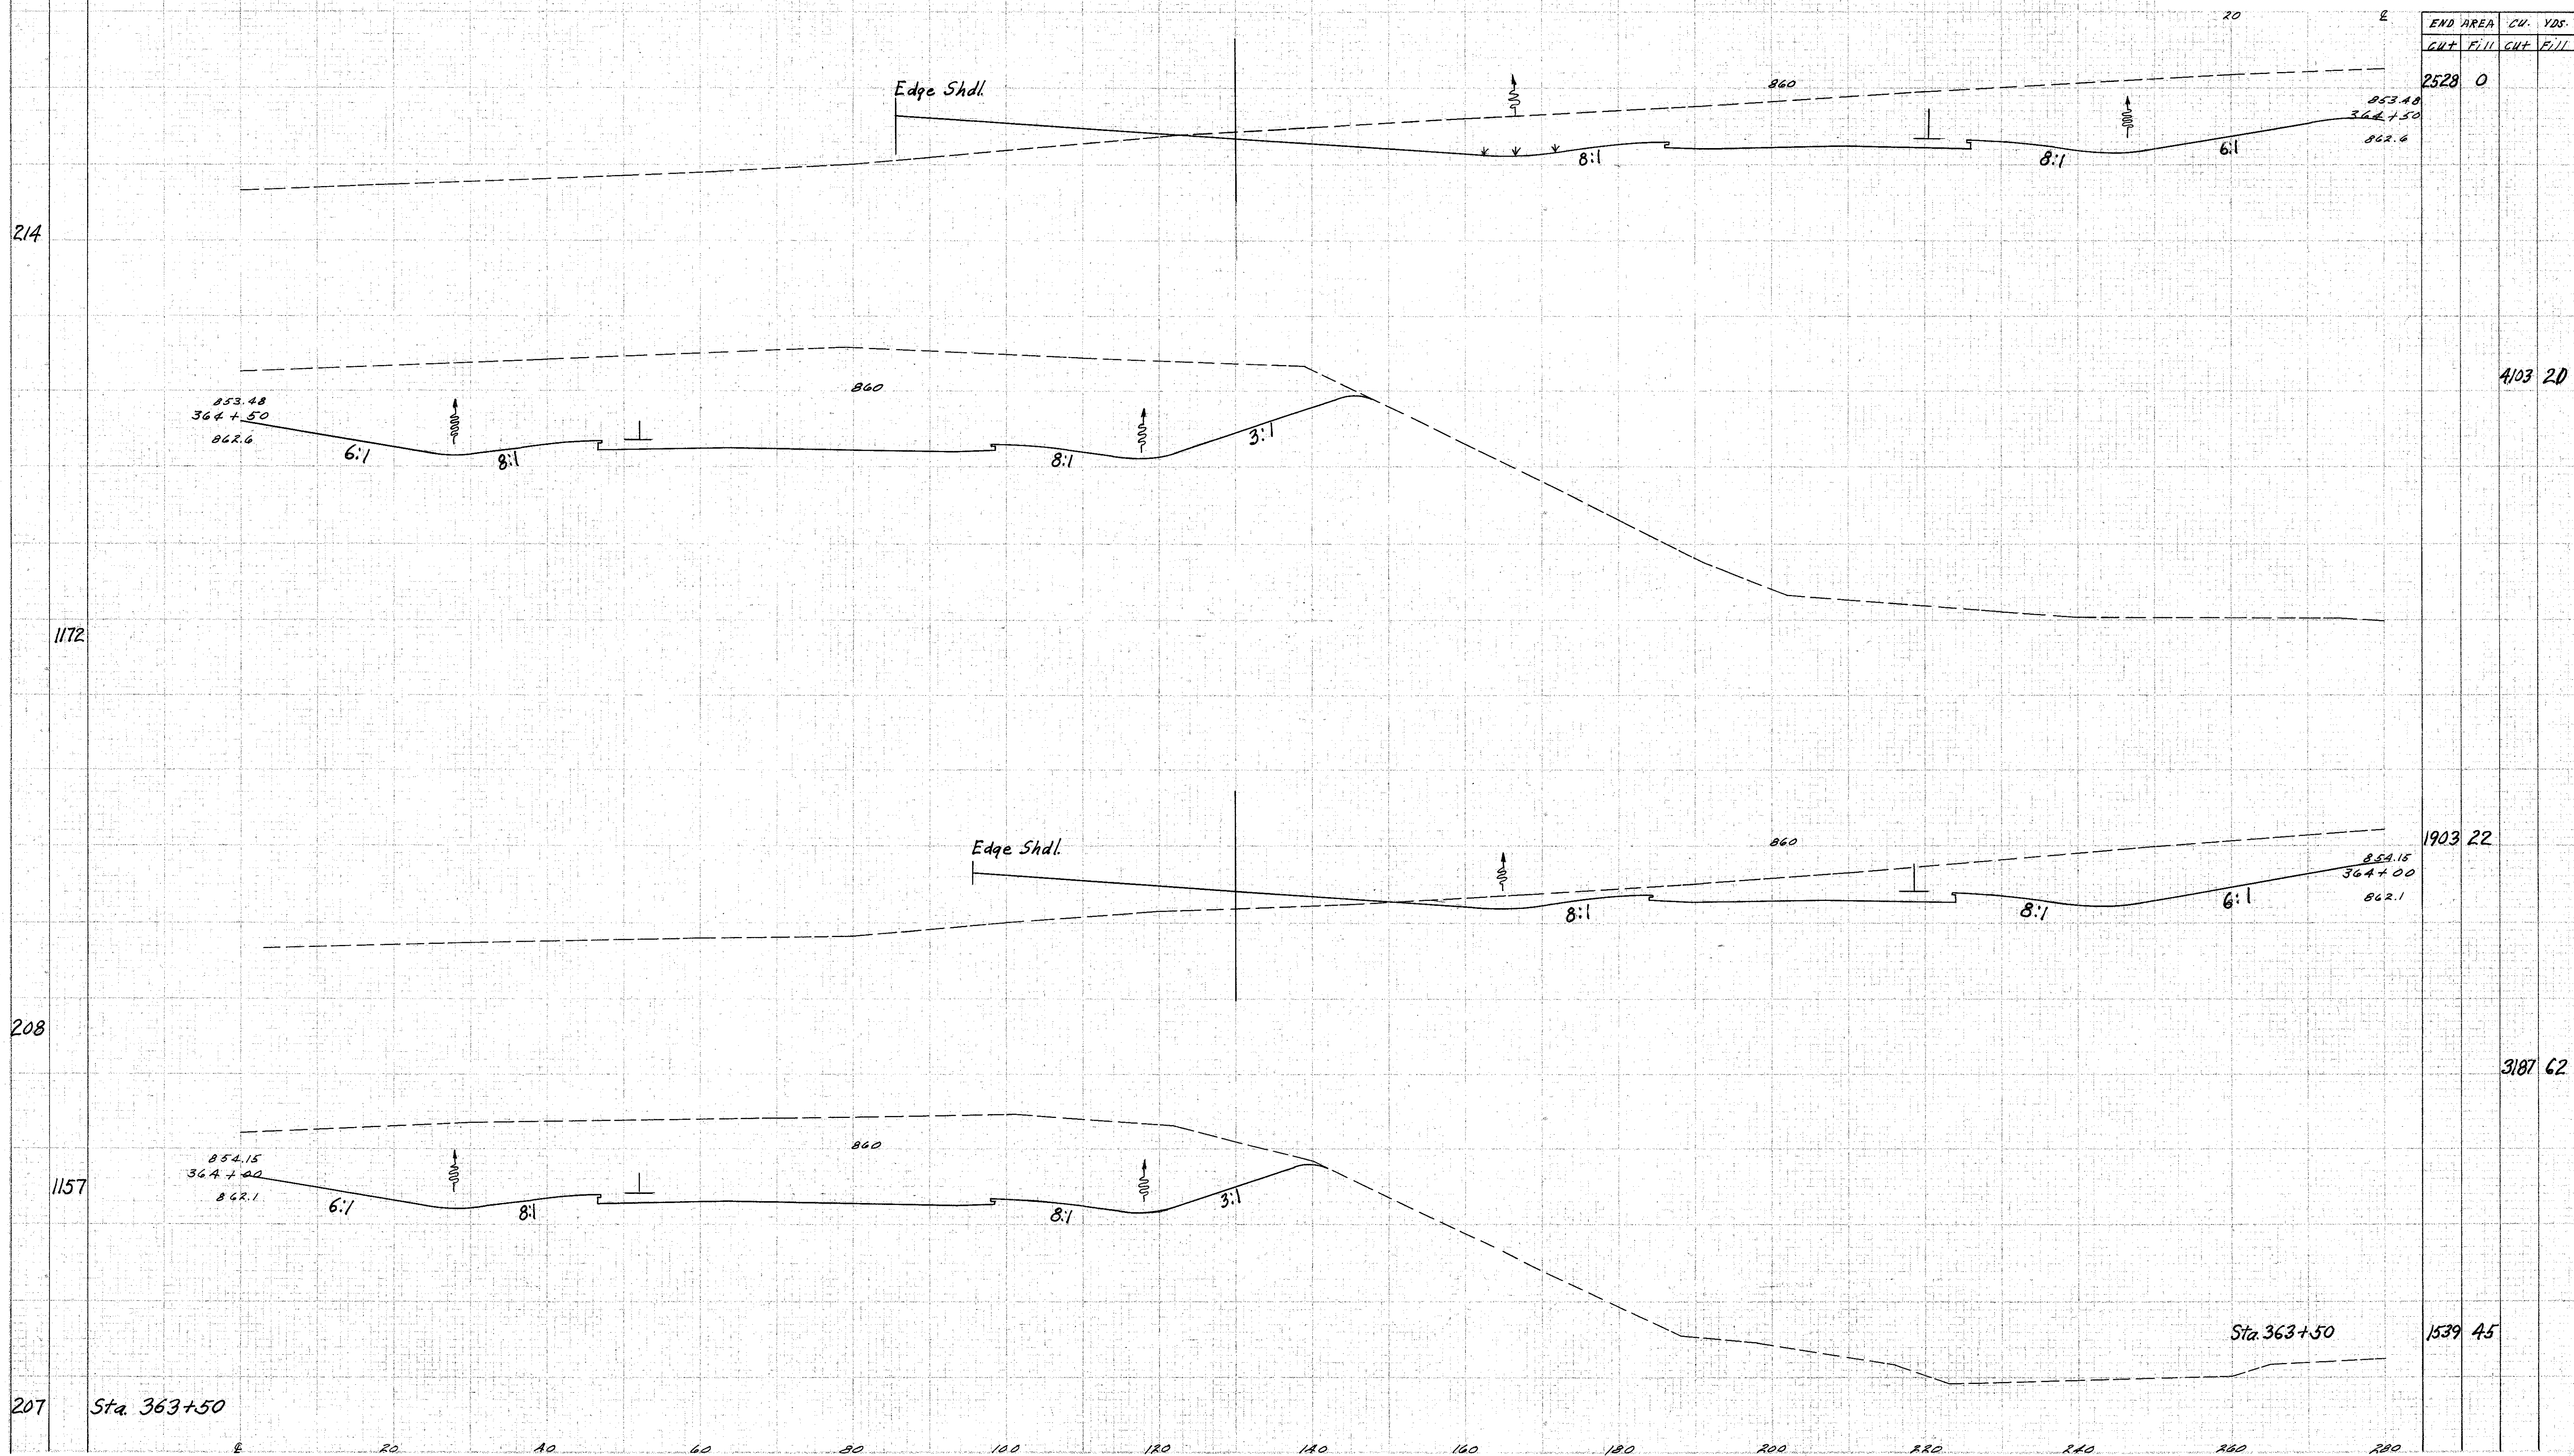

END AREA		CU. YDS.	
CUT	FILL	CUT	FILL
2528	0		

4103 20

END AREA		CU. YDS.	
CUT	FILL	CUT	FILL
1903	22		

3187 62

END AREA		CU. YDS.	
CUT	FILL	CUT	FILL
1539	45		

27 C.C.'56 776 Sta. 364+00 To 364+50