


SEEDING
END STA.
WIDTH 120

280 260 240 220 200 180 160 140 120 100 80 60 40

PLAT NO. 2	STATE OHIO	PROJECT ACI-1103 (21)	84 488
---------------	---------------	--------------------------	-----------

This sheet supersedes sheet no. 84
of the original plan.

LAKE COUNTY
LAK-1-12.89

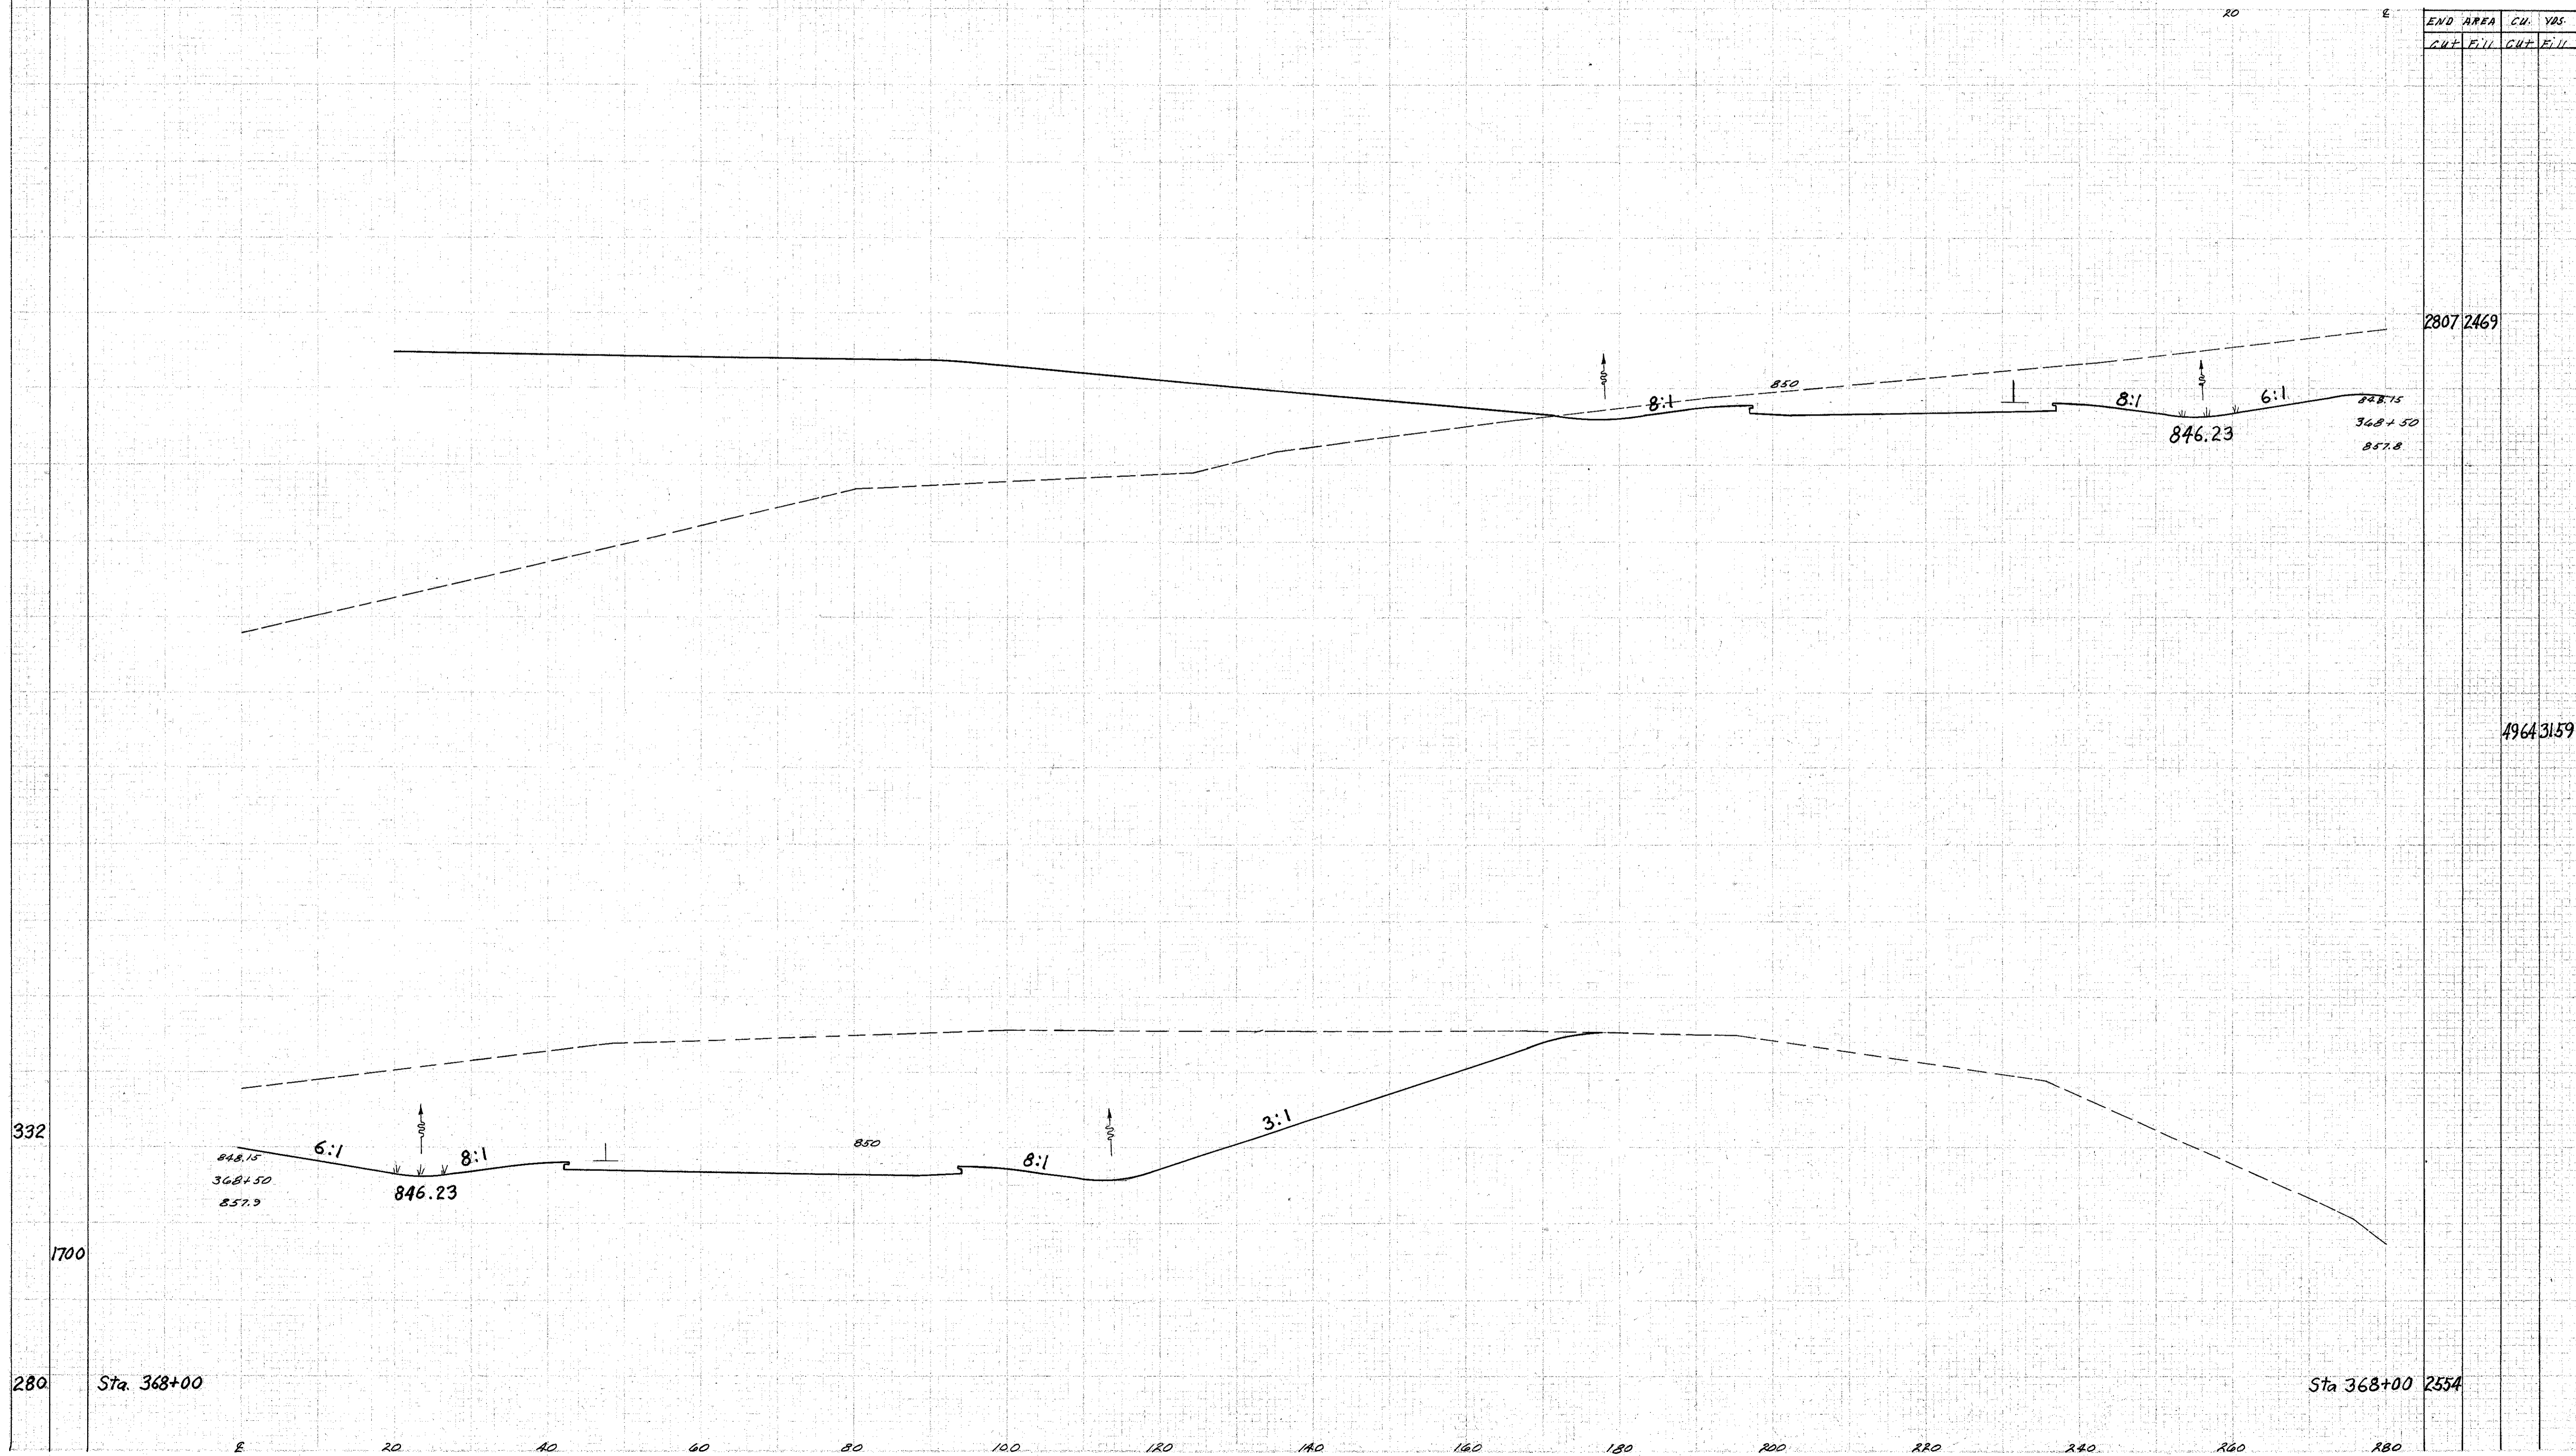

END AREA	CU. YDS.
CUT	FILL

2807 2469

4964 3159

332

1700

280

Sta. 368+00

Sta. 368+00 2554

20 40 60 80 100 120 140 160 180 200 220 240

27 Oct. '58 *J.M.J.*

Sta. 368+50