




LAKE COUNTY
1-12.89

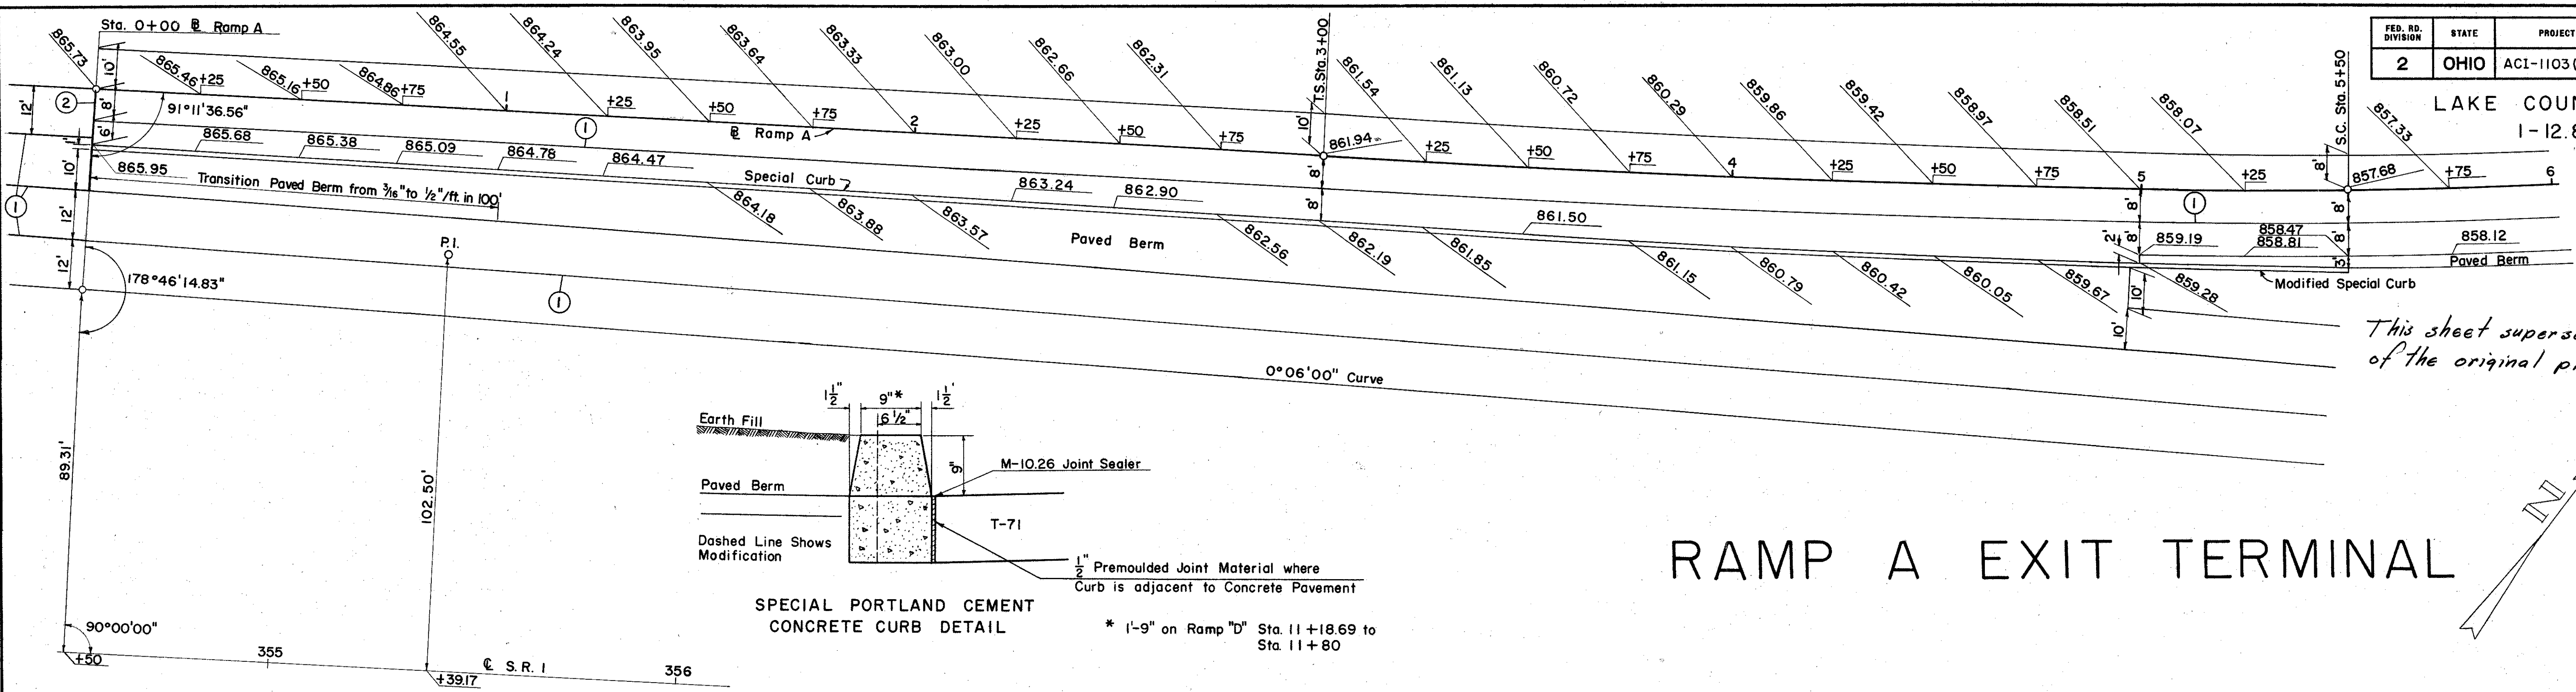

This sheet supersedes sheet no. 288 of the original plan.

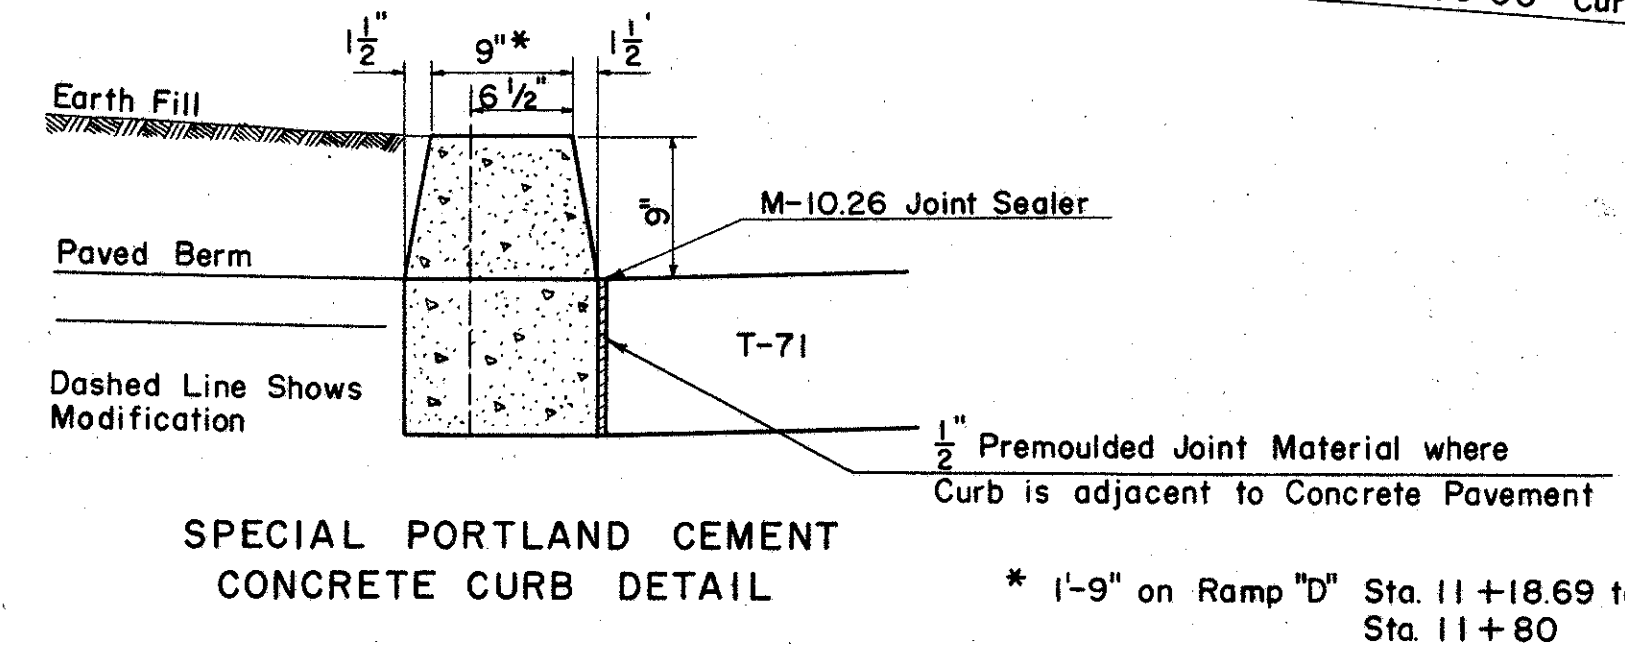

RAMP A EXIT TERMINAL

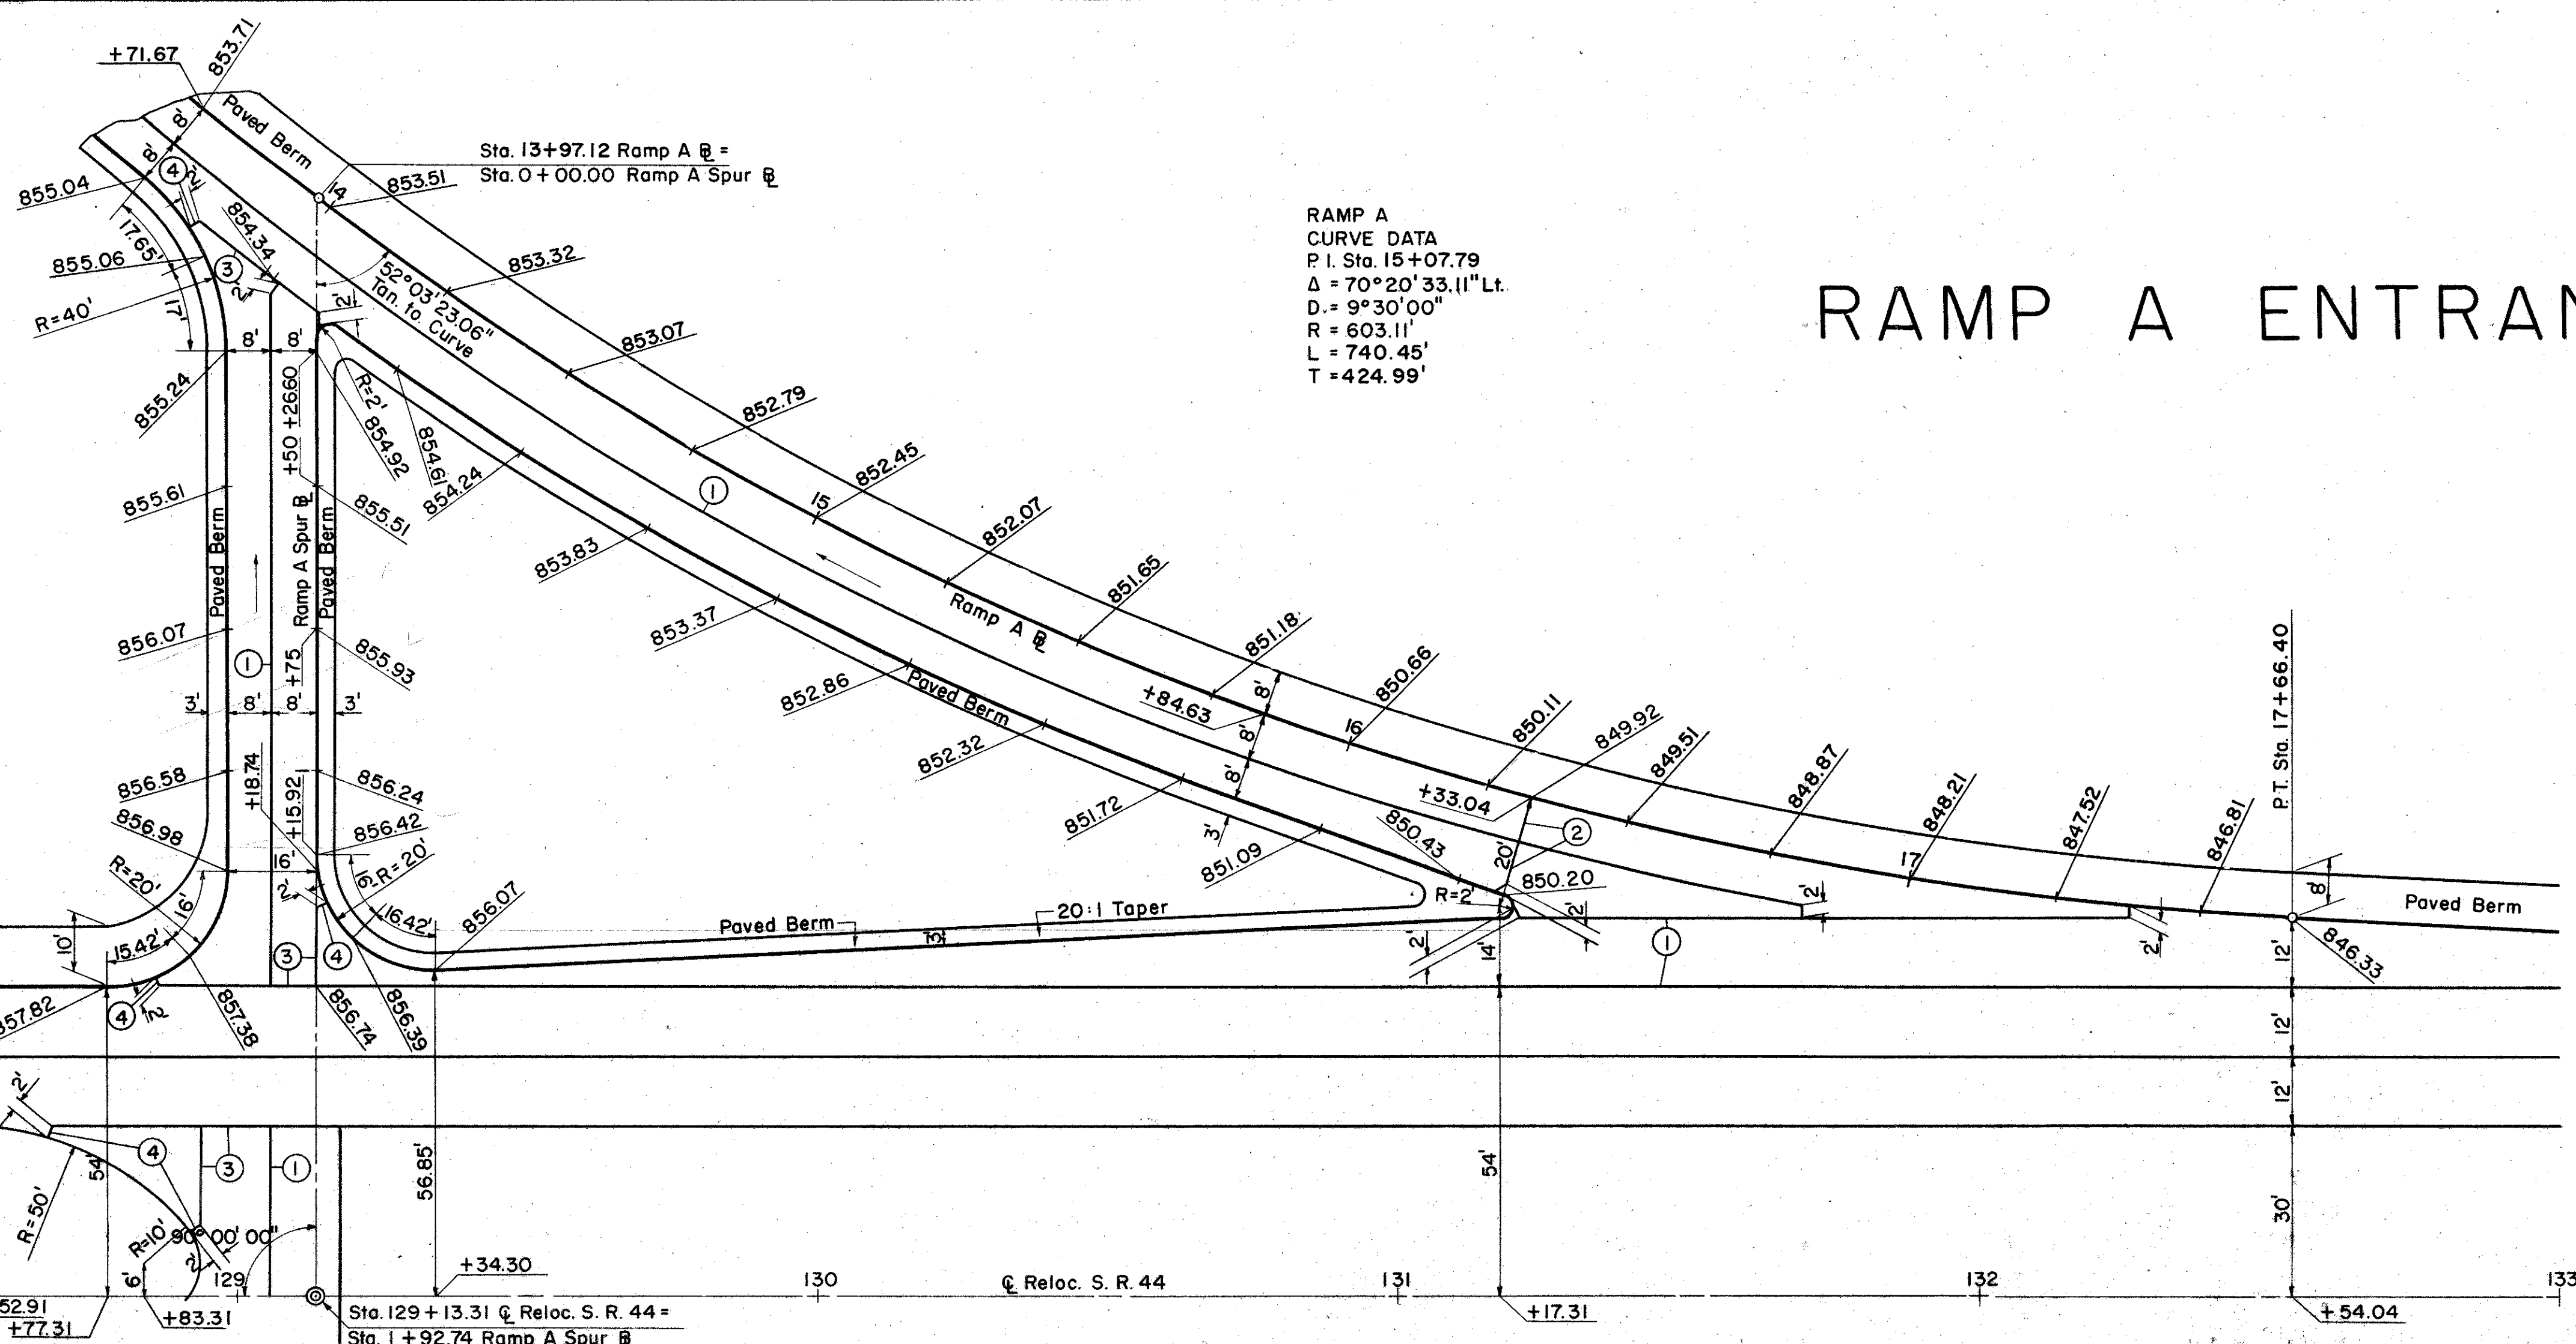

RAMP A
CURVE DATA
P.I. Sta. 15+07.79
Δ = 70°20'33.11" Lt.
D = 9°30'00"
R = 603.11'
L = 740.45'
T = 424.99'

RAMP A ENTRANCE TERMINAL

- CONSTRUCTION JOINT LEGEND
- ① Standard Longitudinal Joint
 - ② Standard Expansion Joint
 - ③ Standard Key Joint Without Tie Bars
 - ④ Expansion Joint Without Dowels

RELOC. S.R. 44 INTERCHANGE
INTERSECTION DETAILS-
RAMPS A & A SPUR

Scale 1" = 20'-0"

27 Oct. '58 *[Signature]*