


SEEDING
END WIDTH
SA YDS.

FED. RD. DIST.	STATE	PROJECT
2	OHIO	ACI-1103 (27)

105
413

LAKE COUNTY
LAK-1-16.55

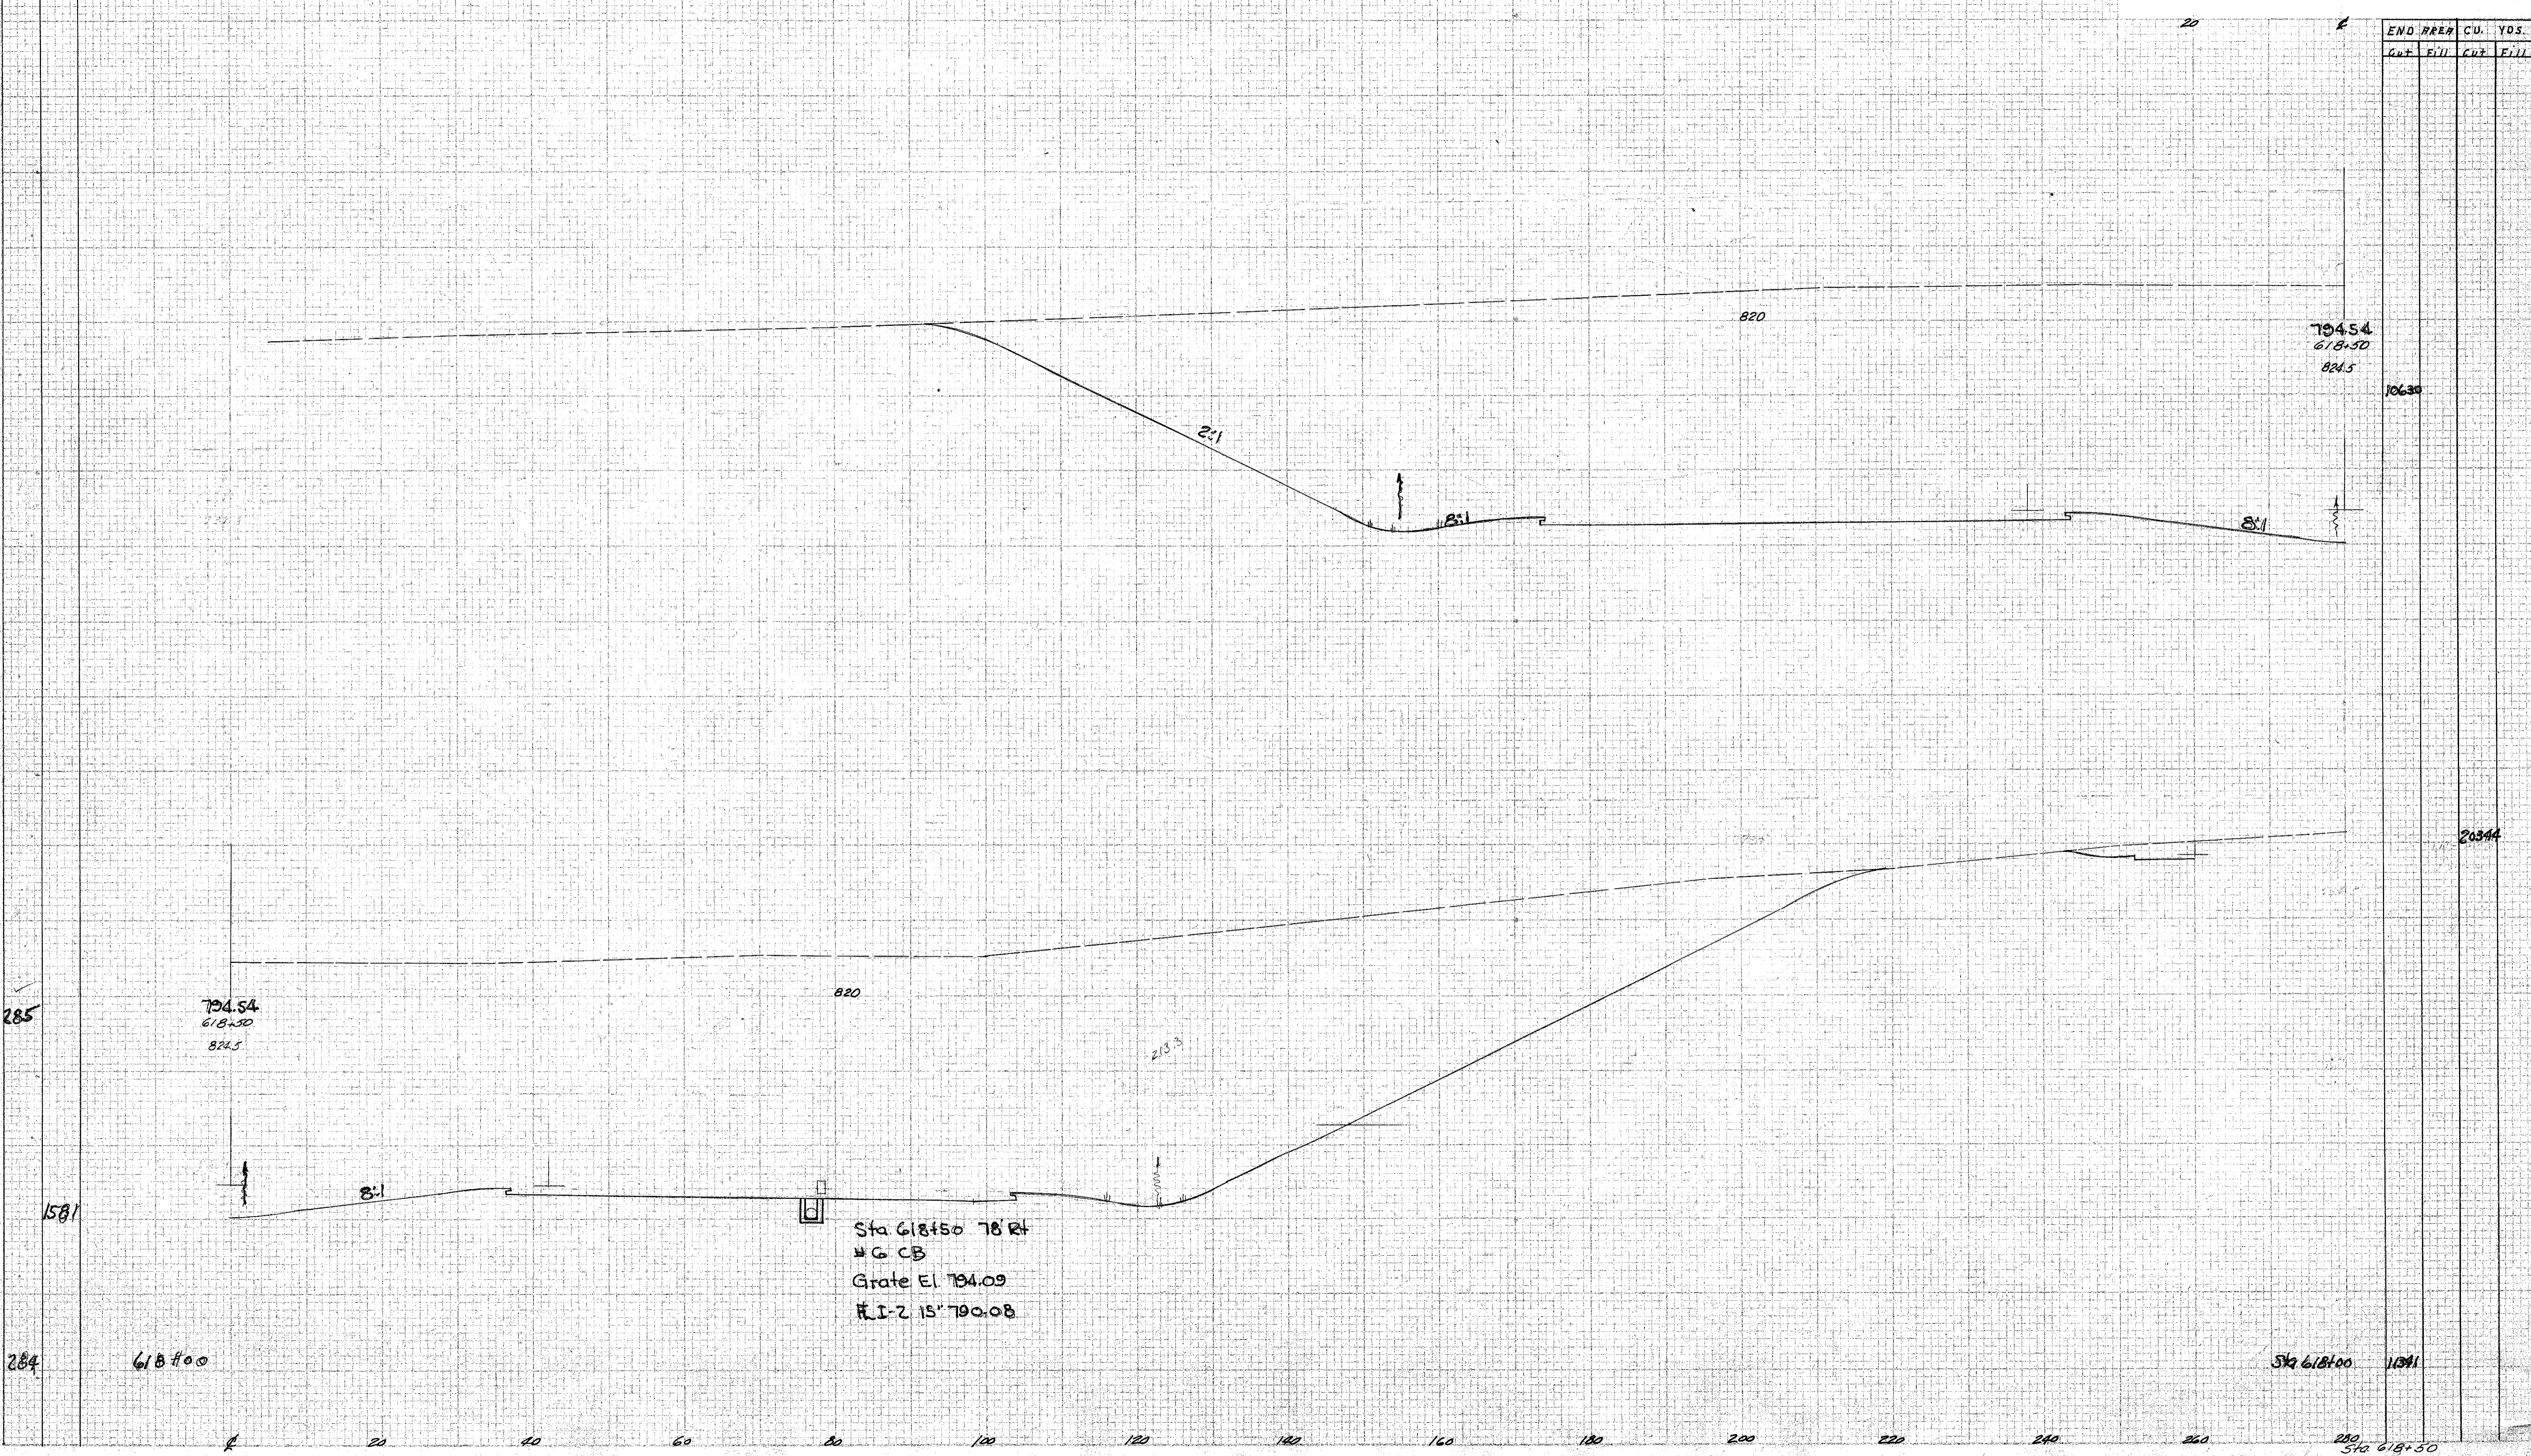

see Book 4-3-58
L 217-4-3-58

Sta 618+50 78 Rt
G CB
Grate El 794.09
I-2 15' 790.08

794.54
618+50
824.5

794.54
618+50
824.5

8:1

213.3

2:1

8:1

285

1581

284

618+00

Sta 618+00 1031

Sta 618+50