


- NOTES:
- FOR ADDITIONAL NOTES SEE SHEET 7/52.
 - FOR NEW BACKWALL AND CONCRETE PARAPET REPLACEMENT DETAILS, SEE SHEETS 11/52 AND 12/52.



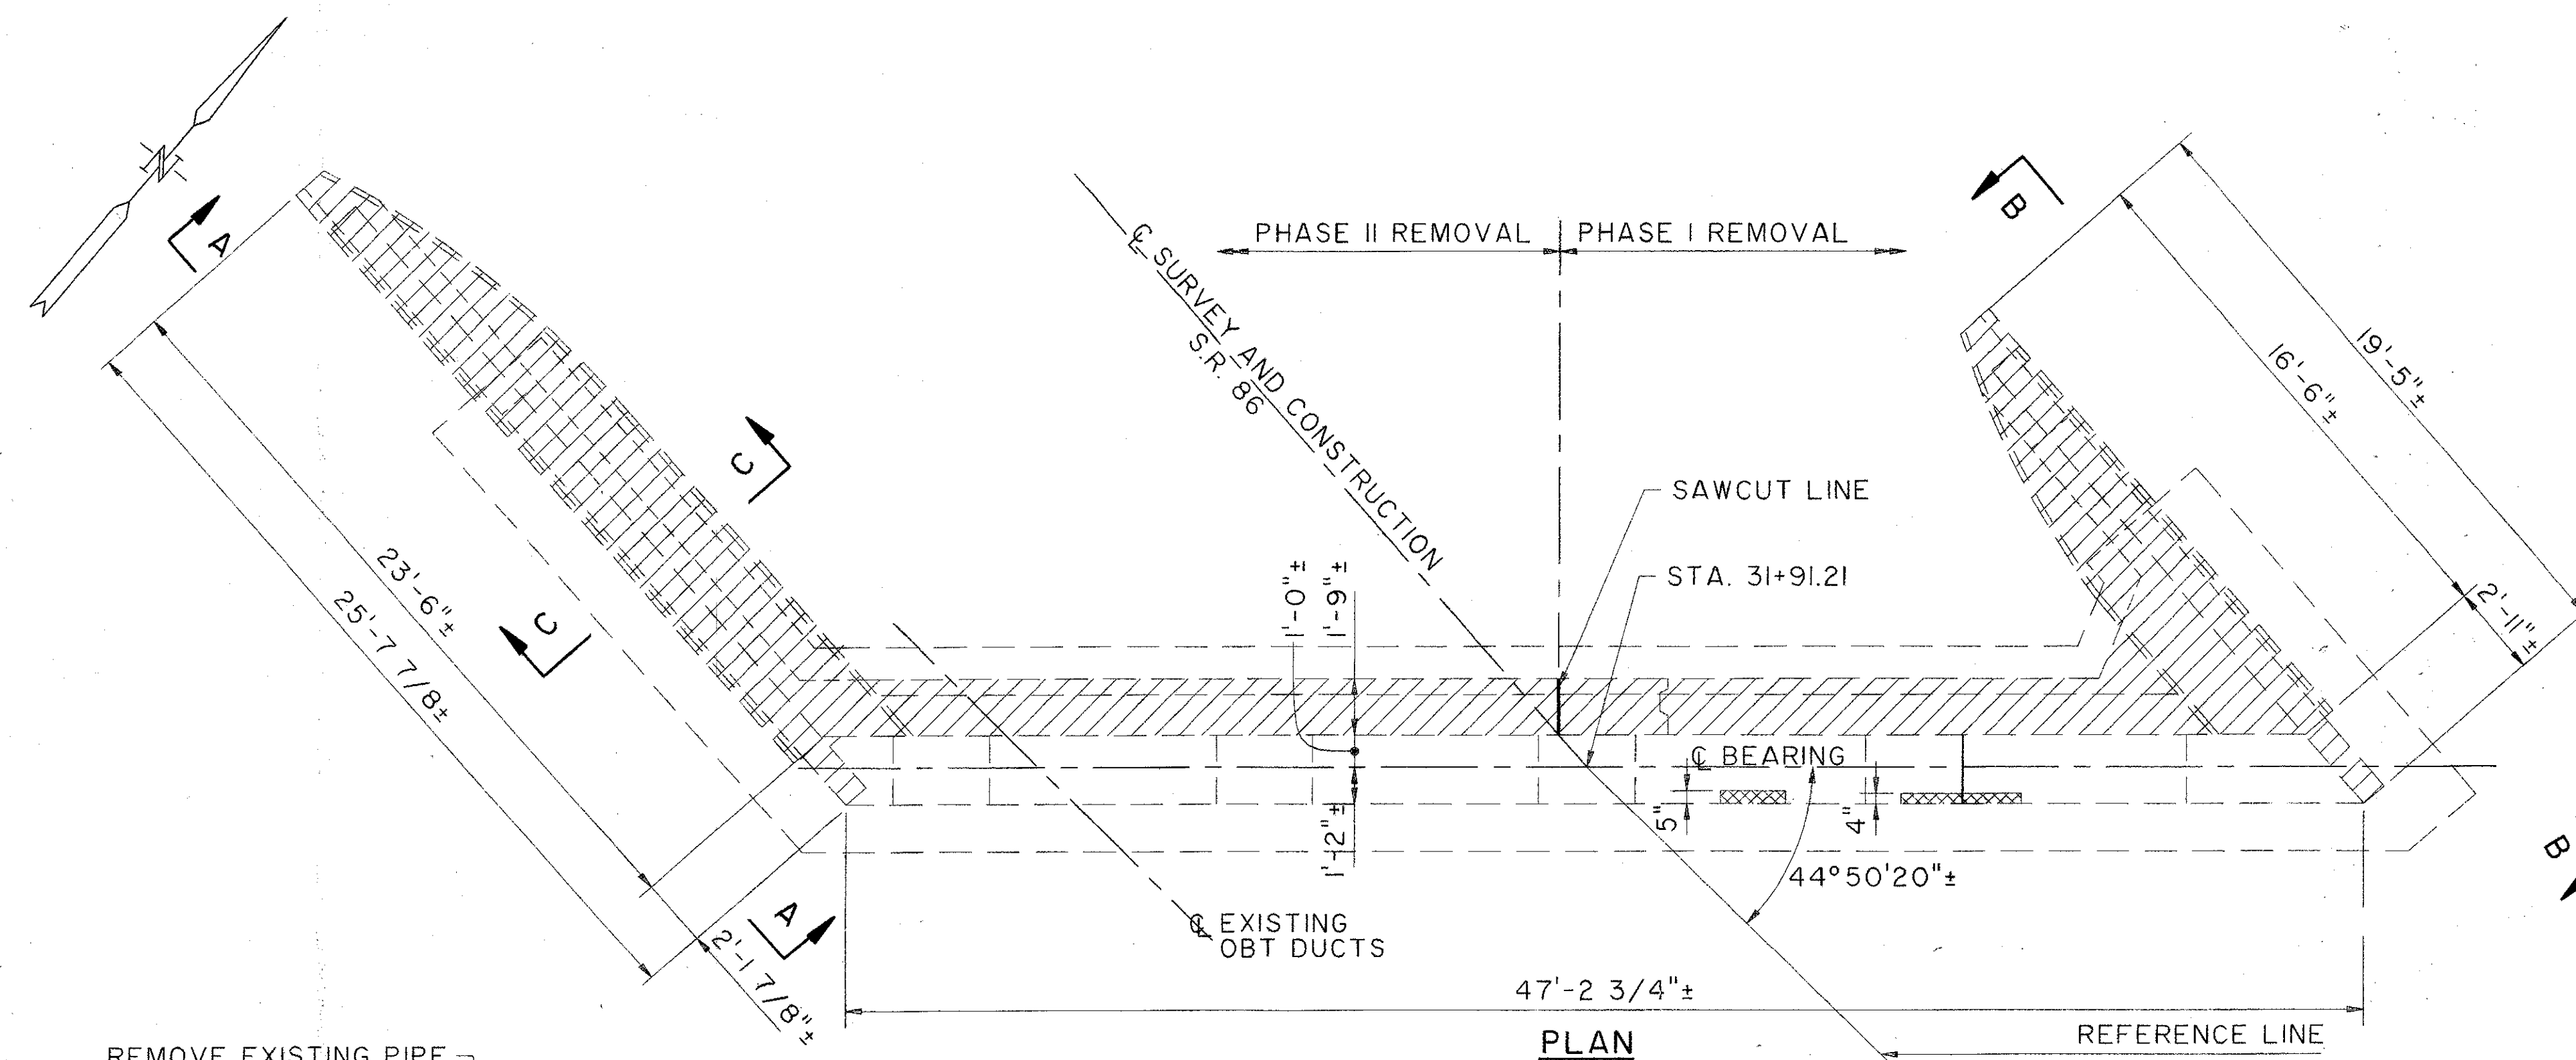


LEGEND

ITEM 202, PORTIONS OF STRUCTURE REMOVED, AS PER PLAN

ITEM 519, PATCHING CONCRETE STRUCTURE, AS PER PLAN

ESTIMATED QUANTITIES			
ITEM	DESCRIPTION	QUANTITY	
		MEASURED	ESTIMATED
.519	PATCHING CONCRETE STRUCTURE AS PER PLAN	6 SF	18 SF

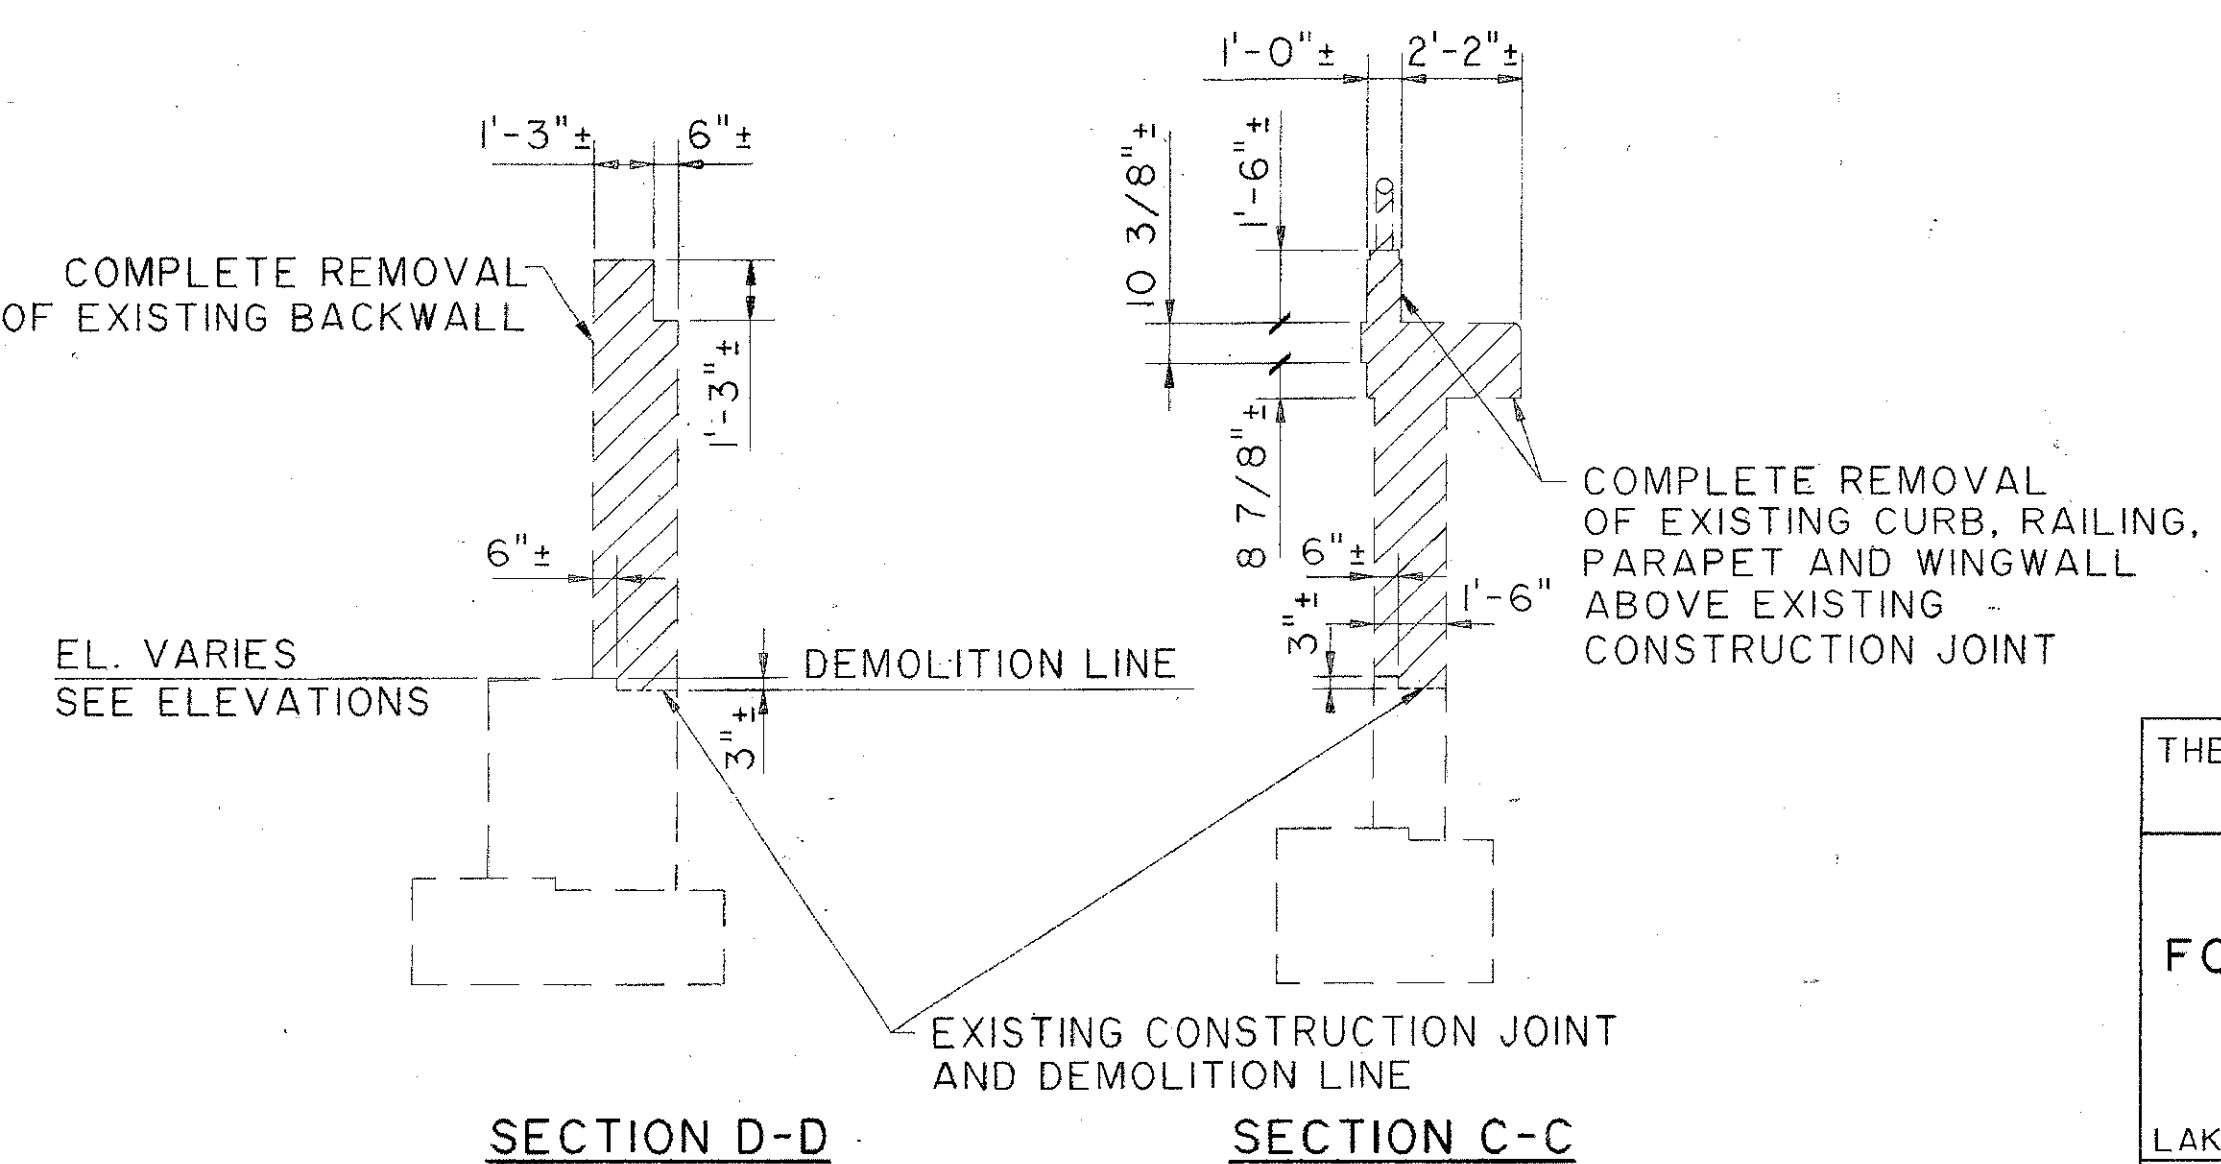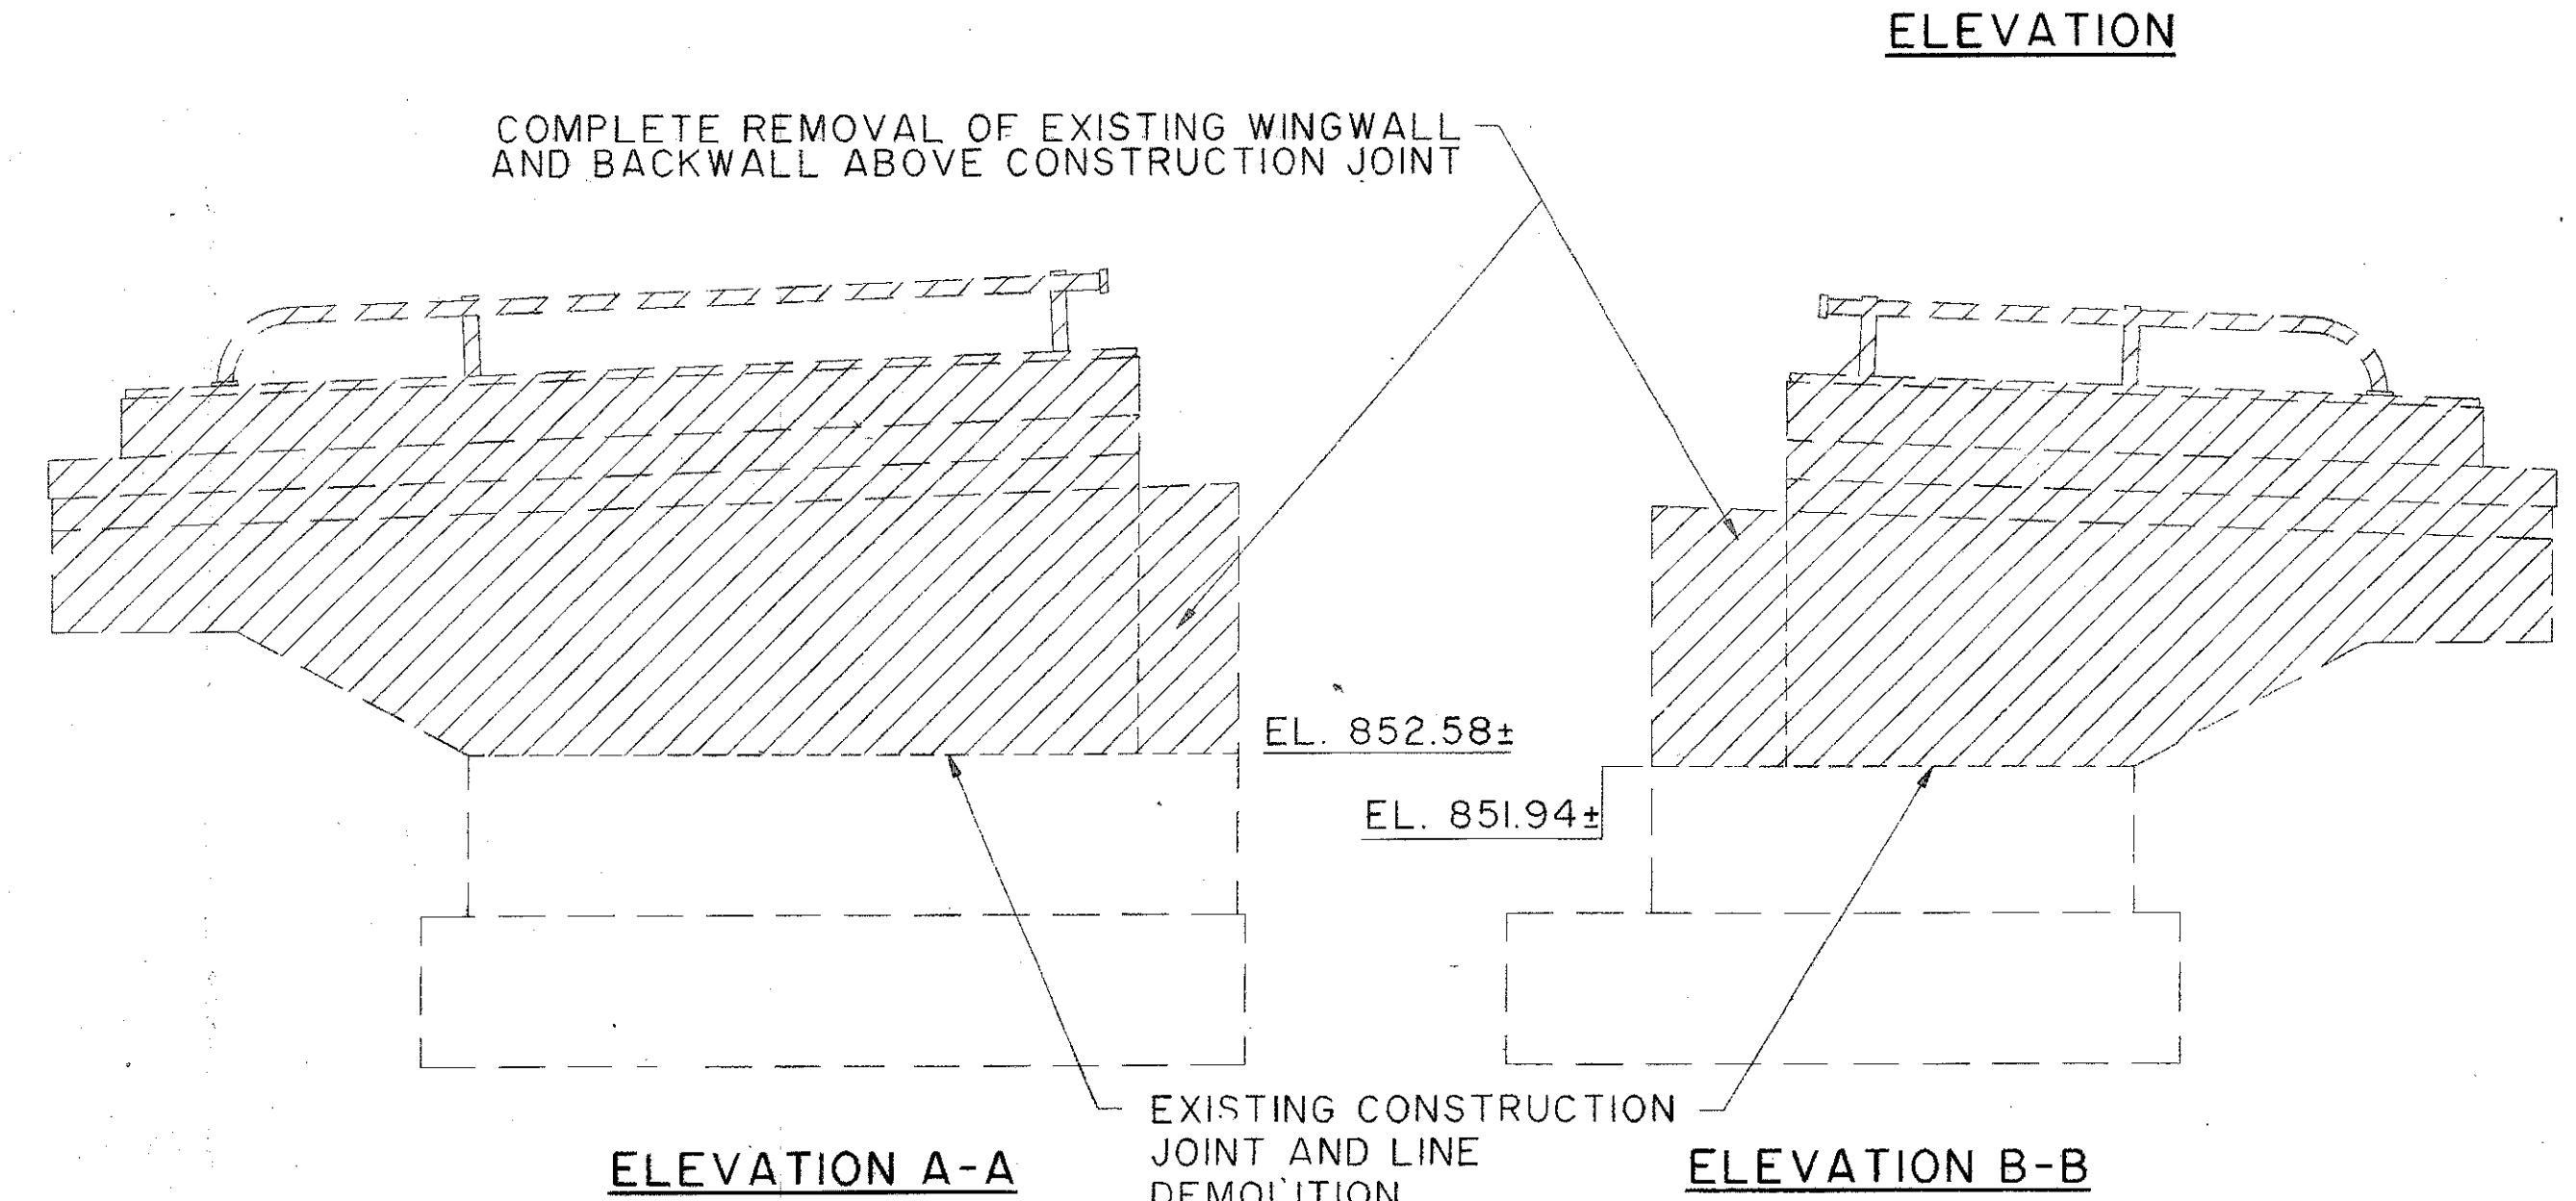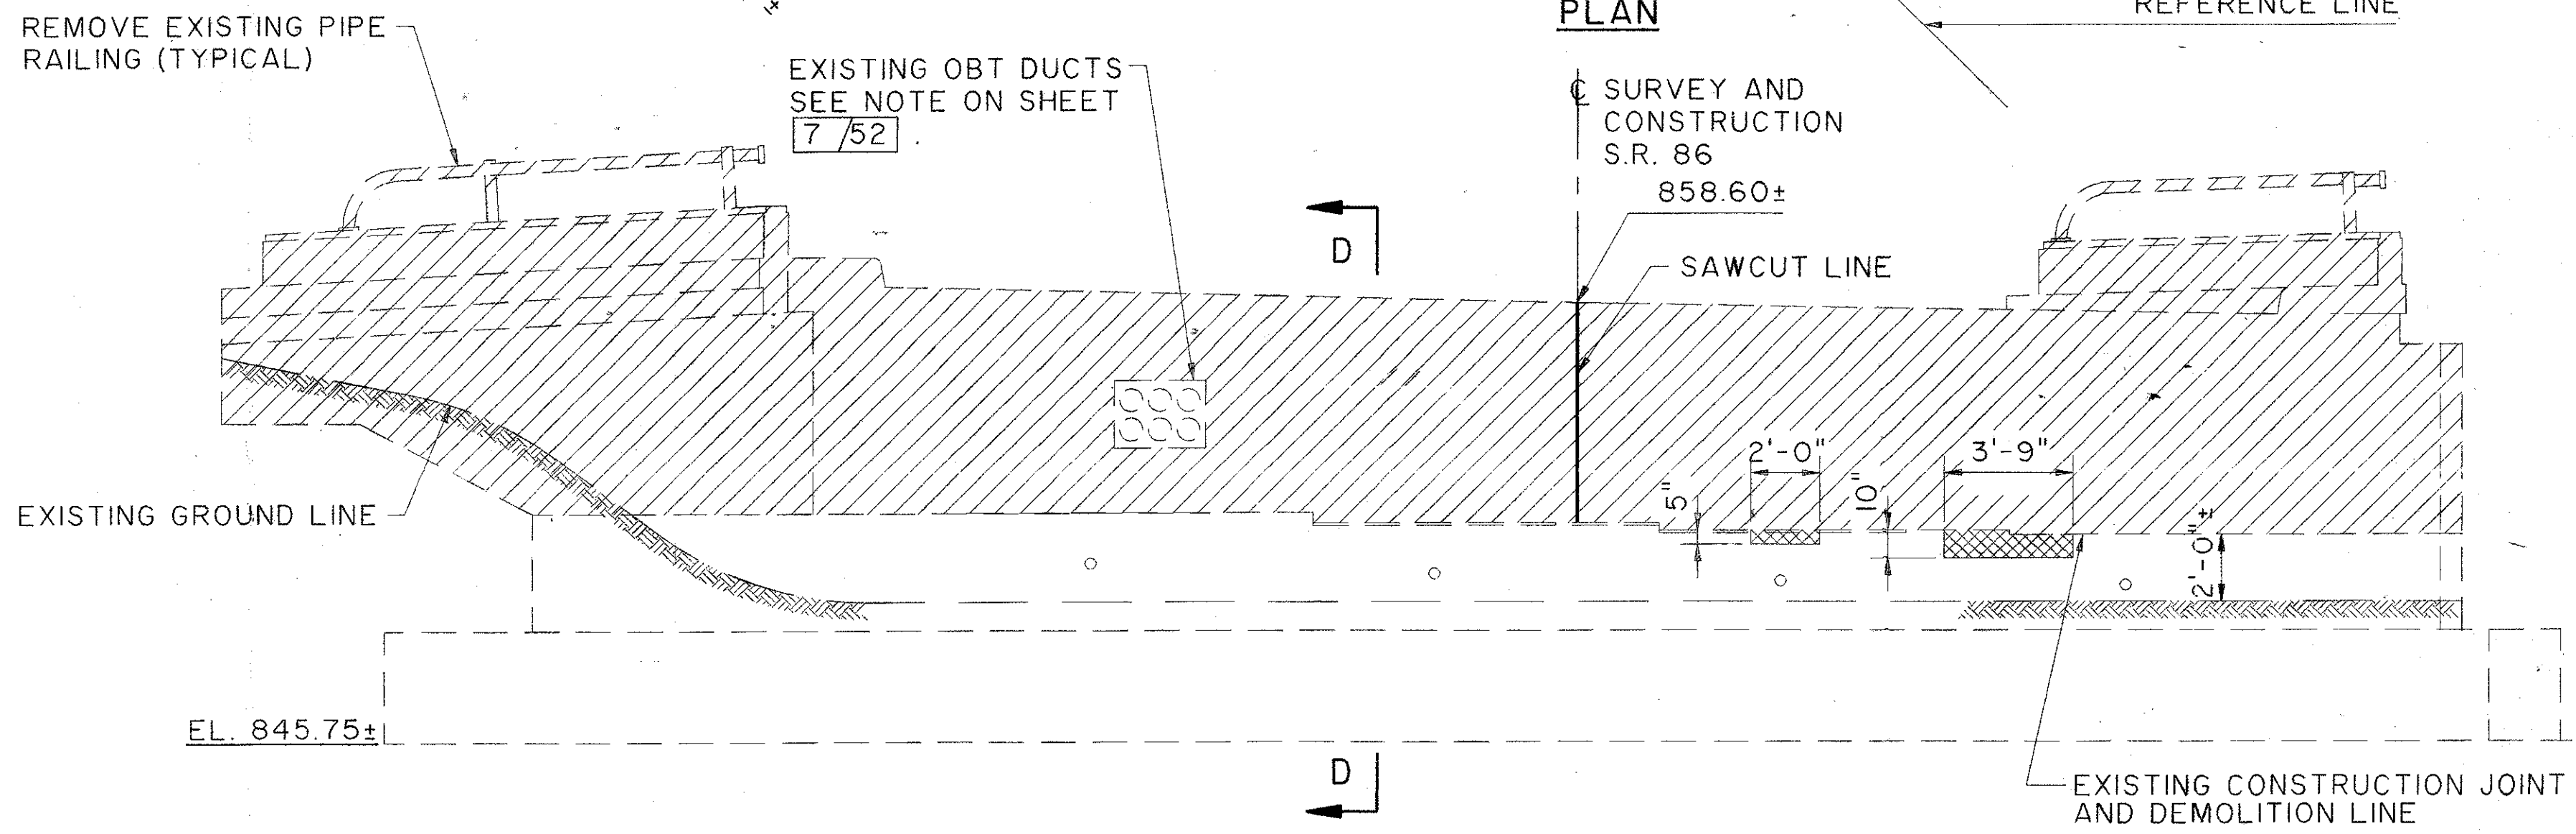

THE OSBORN ENGINEERING COMPANY 8/52
CONSULTING ENGINEERS
CLEVELAND, OHIO 44114

FORWARD ABUTMENT DEMOLITION
BRIDGE NO. LAK-90-1742
S.R. 86 OVER I-90

DESIGNED	DRAWN	TRACED	CHECKED	REVIEWED	DATE	OHIO
LYH	BFG		JRS	GA	2/94	OD.O.T. 6/17/94

File name: K:\VOL1\0001\0186\STRUCT\0186S5728
 Drawn By: BFG / 05-12-94 (1624)

S.R. 86