
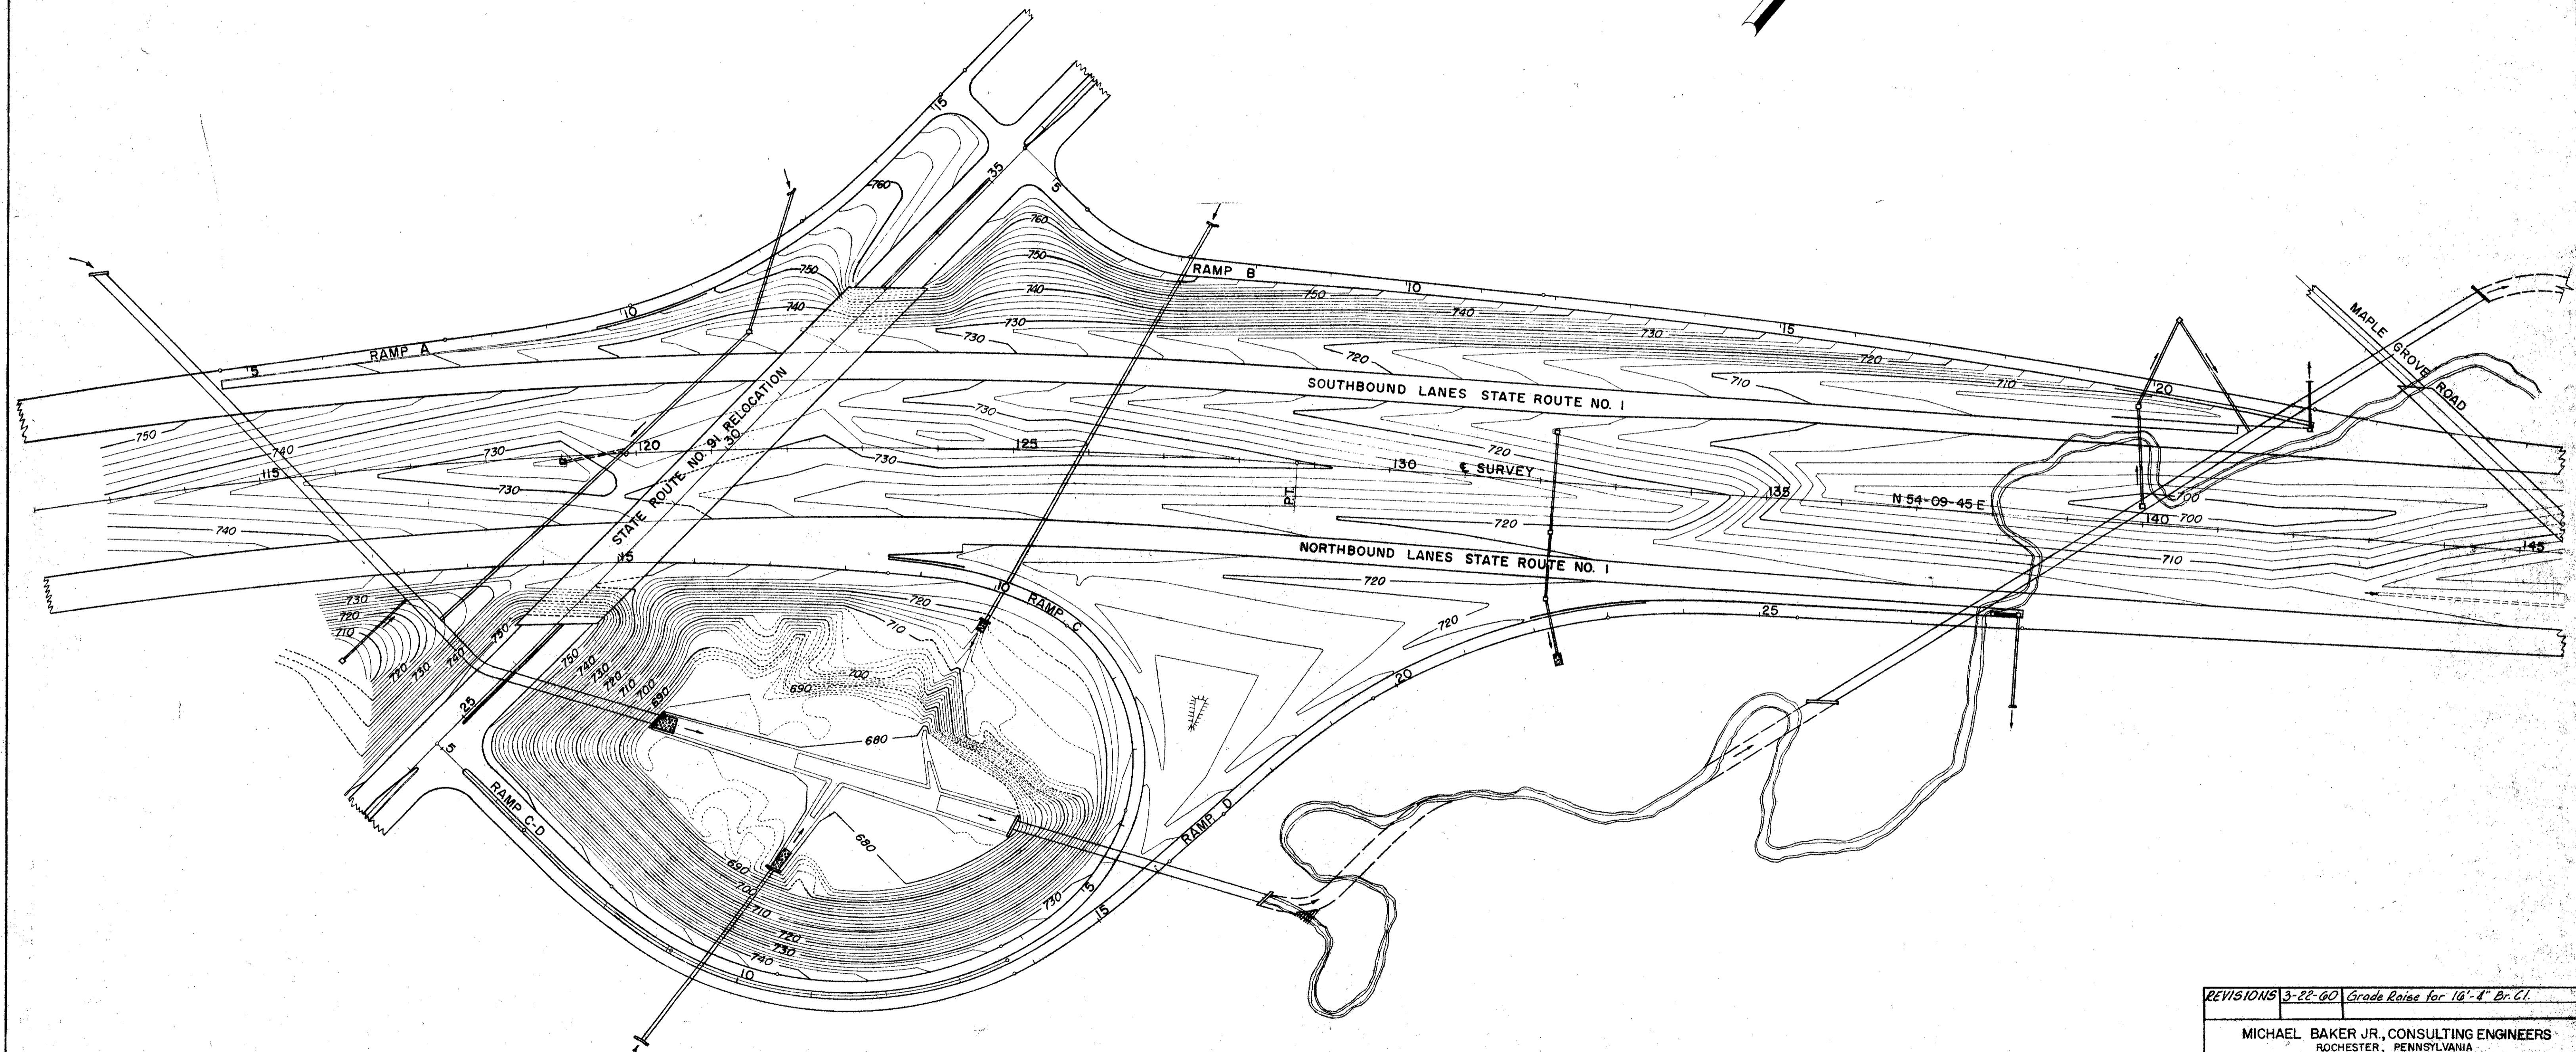


FED. RD. DIVISION	STATE	PROJECT	
2	OHIO	I-1103 (19)	

153-S
3/2

LAKE COUNTY
LAK-I-2.16

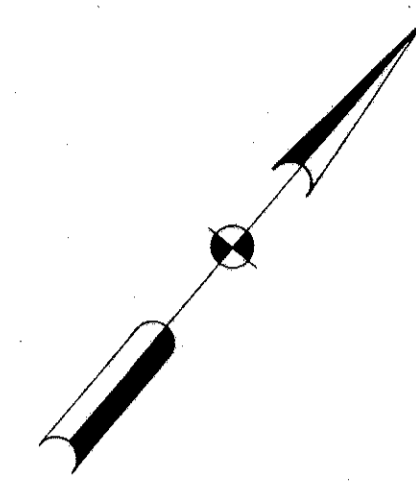

REVISIONS 3-22-60 Grade Raise for 16'-4" Br. C.I.

MICHAEL BAKER JR., CONSULTING ENGINEERS
ROCHESTER, PENNSYLVANIA

STATE OF OHIO
DEPARTMENT OF HIGHWAYS
STATE HIGHWAY NO. 1
C-43
STATE ROUTE NO. 91 INTERCHANGE
GRADING PLAN

Designed	Drawn	Traced	Checked	Reviewed Date	Revised
H. v. V.	J. S.	J. S. H.	B. P.		

This Sheet Supersedes sheet No 153 4-6-60 P.E.C.
GRADING PLAN S.R. NO. 91 INTERCHANGE