FED. RD. DIVISION	STATE	PROJECT	
2	OHIO	I-1103 (19)	

163-5 / 212

LAKE COUNTY
LAK-1-2.16

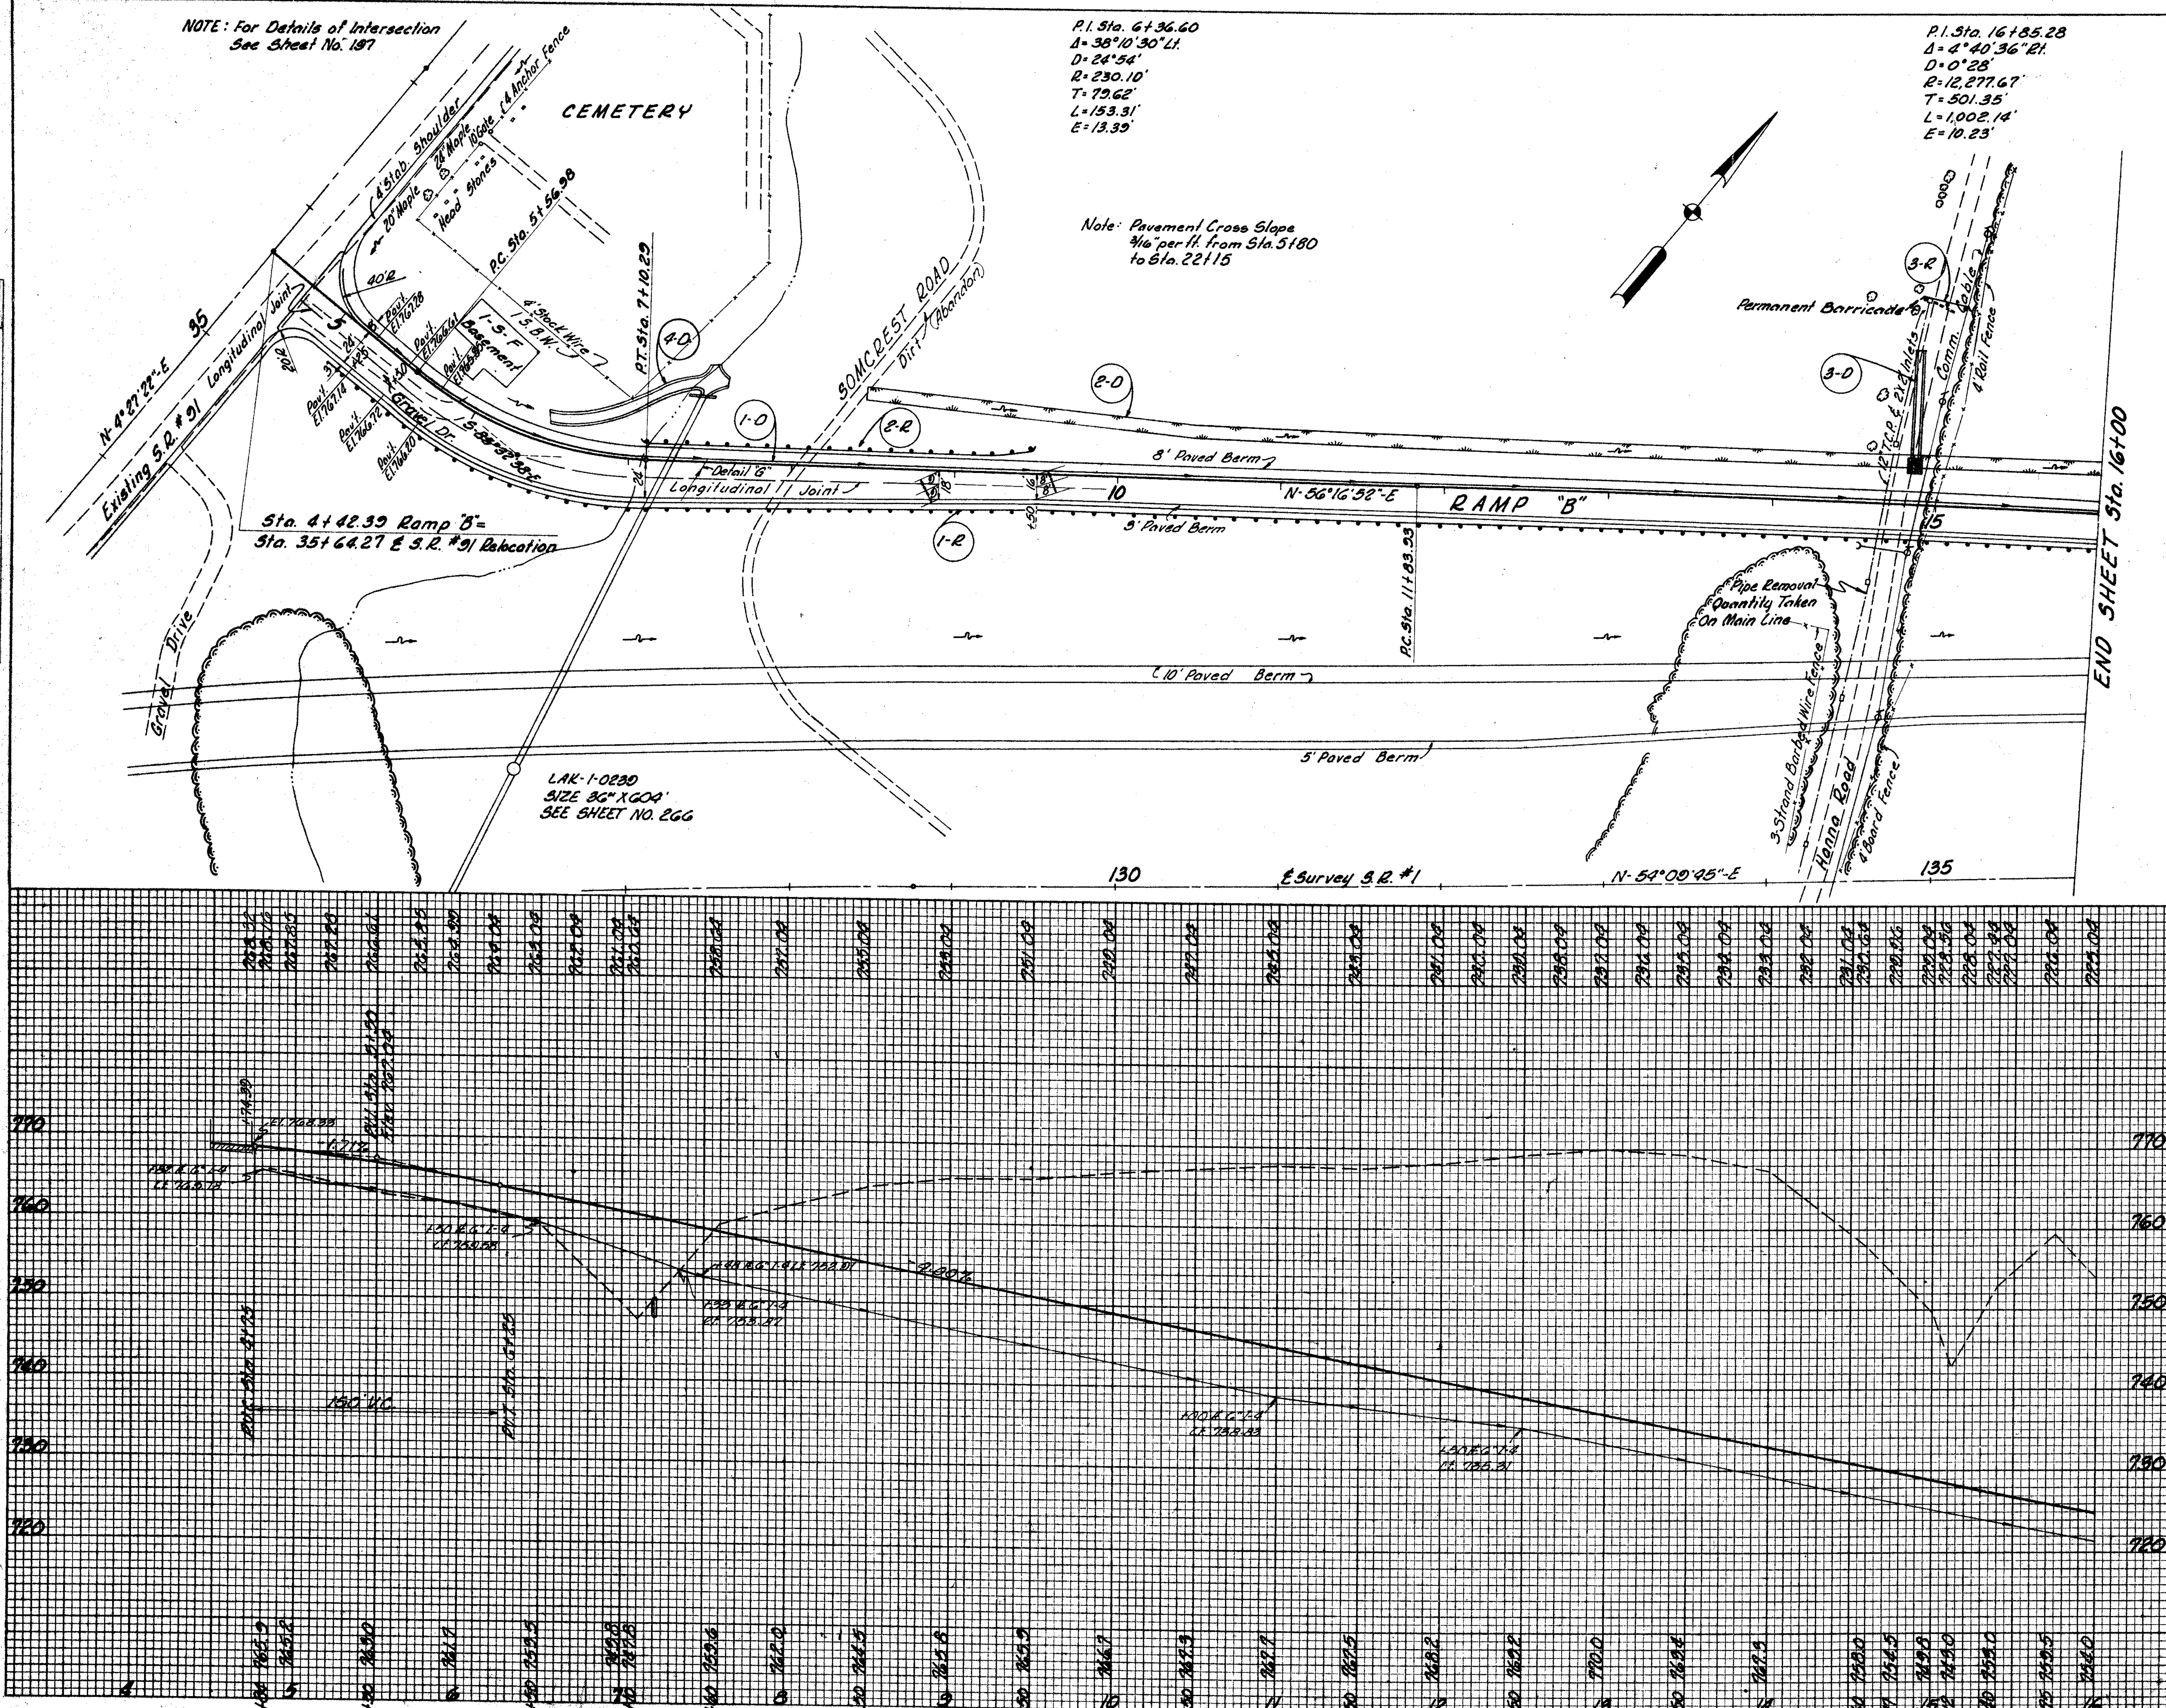

ROADWAY				
Ref. No.	Station From	Station To	Side ℄	I-15 Grd. Rail Dwg. 2-A Lin. Ft.
1-R	5+10.60	16+00	Rt.	1108.78
2-R	7+10.29	9+47.79	Lt.	237.50
3-R	134+98	135+23	Lt.	25.0
			Totals	1371.28

DRAINAGE

See Sh. No.	Ref. No.	Station From	Station To	Side ℄	I-4 Underdrain Shallow 6" Lin. Ft.	I-4 Underdrain Deep 6" Lin. Ft.	I-4 Underdrain Sec. M-6.4(h) 6" Lin. Ft.	I-5 Pipe Special Underdrain Each 6"x6"x6" Y Branch	I-10 Dumped Rock Channel Protection Cu. Yds.	I-14 Paved Gutter Std. Type 1 Lin. Ft.	I-14 Paved Gutter Type 1 (Mod.) 4' E.B. Lin. Ft.	L-10 Sodding Sq. Yds.
257	1-0	4+82	16+00	Lt.	200	631	350	1				
	2-0	8+50	16+00	Lt.								1167
170	3-0	14+85		Lt.					8	75		25
166	4-0	6+50	7+30								83	28
			Totals		200	631	350	1	8	75	83	1220

This Sheet Supersedes Sheet No 163 4-6-60 R.E.C.

REVISIONS: 3-22-60 Grade Raise for 16'-4" Br. Cl.

MICHAEL BAKER, JR., CONSULTING ENGINEERS
ROCHESTER, PENNSYLVANIA

STATE OF OHIO
DEPARTMENT OF HIGHWAYS

STATE HIGHWAY NO. 1
C-43
S.R. NO. 91 INTERCHANGE RAMP "B"
STA. 4+42.39 TO STA. 16+00

Designed	Drawn	Traced	Checked	Reviewed Date	Revised
H.v.V.	J.S.	A.L.H.	B.P.		