


Grading
and
and
width

FED. RD. DIVISION	STATE	PROJECT
2	OHIO	I-1103-(19)

165-9
312

LAKE COUNTY
LAK-1-2.16

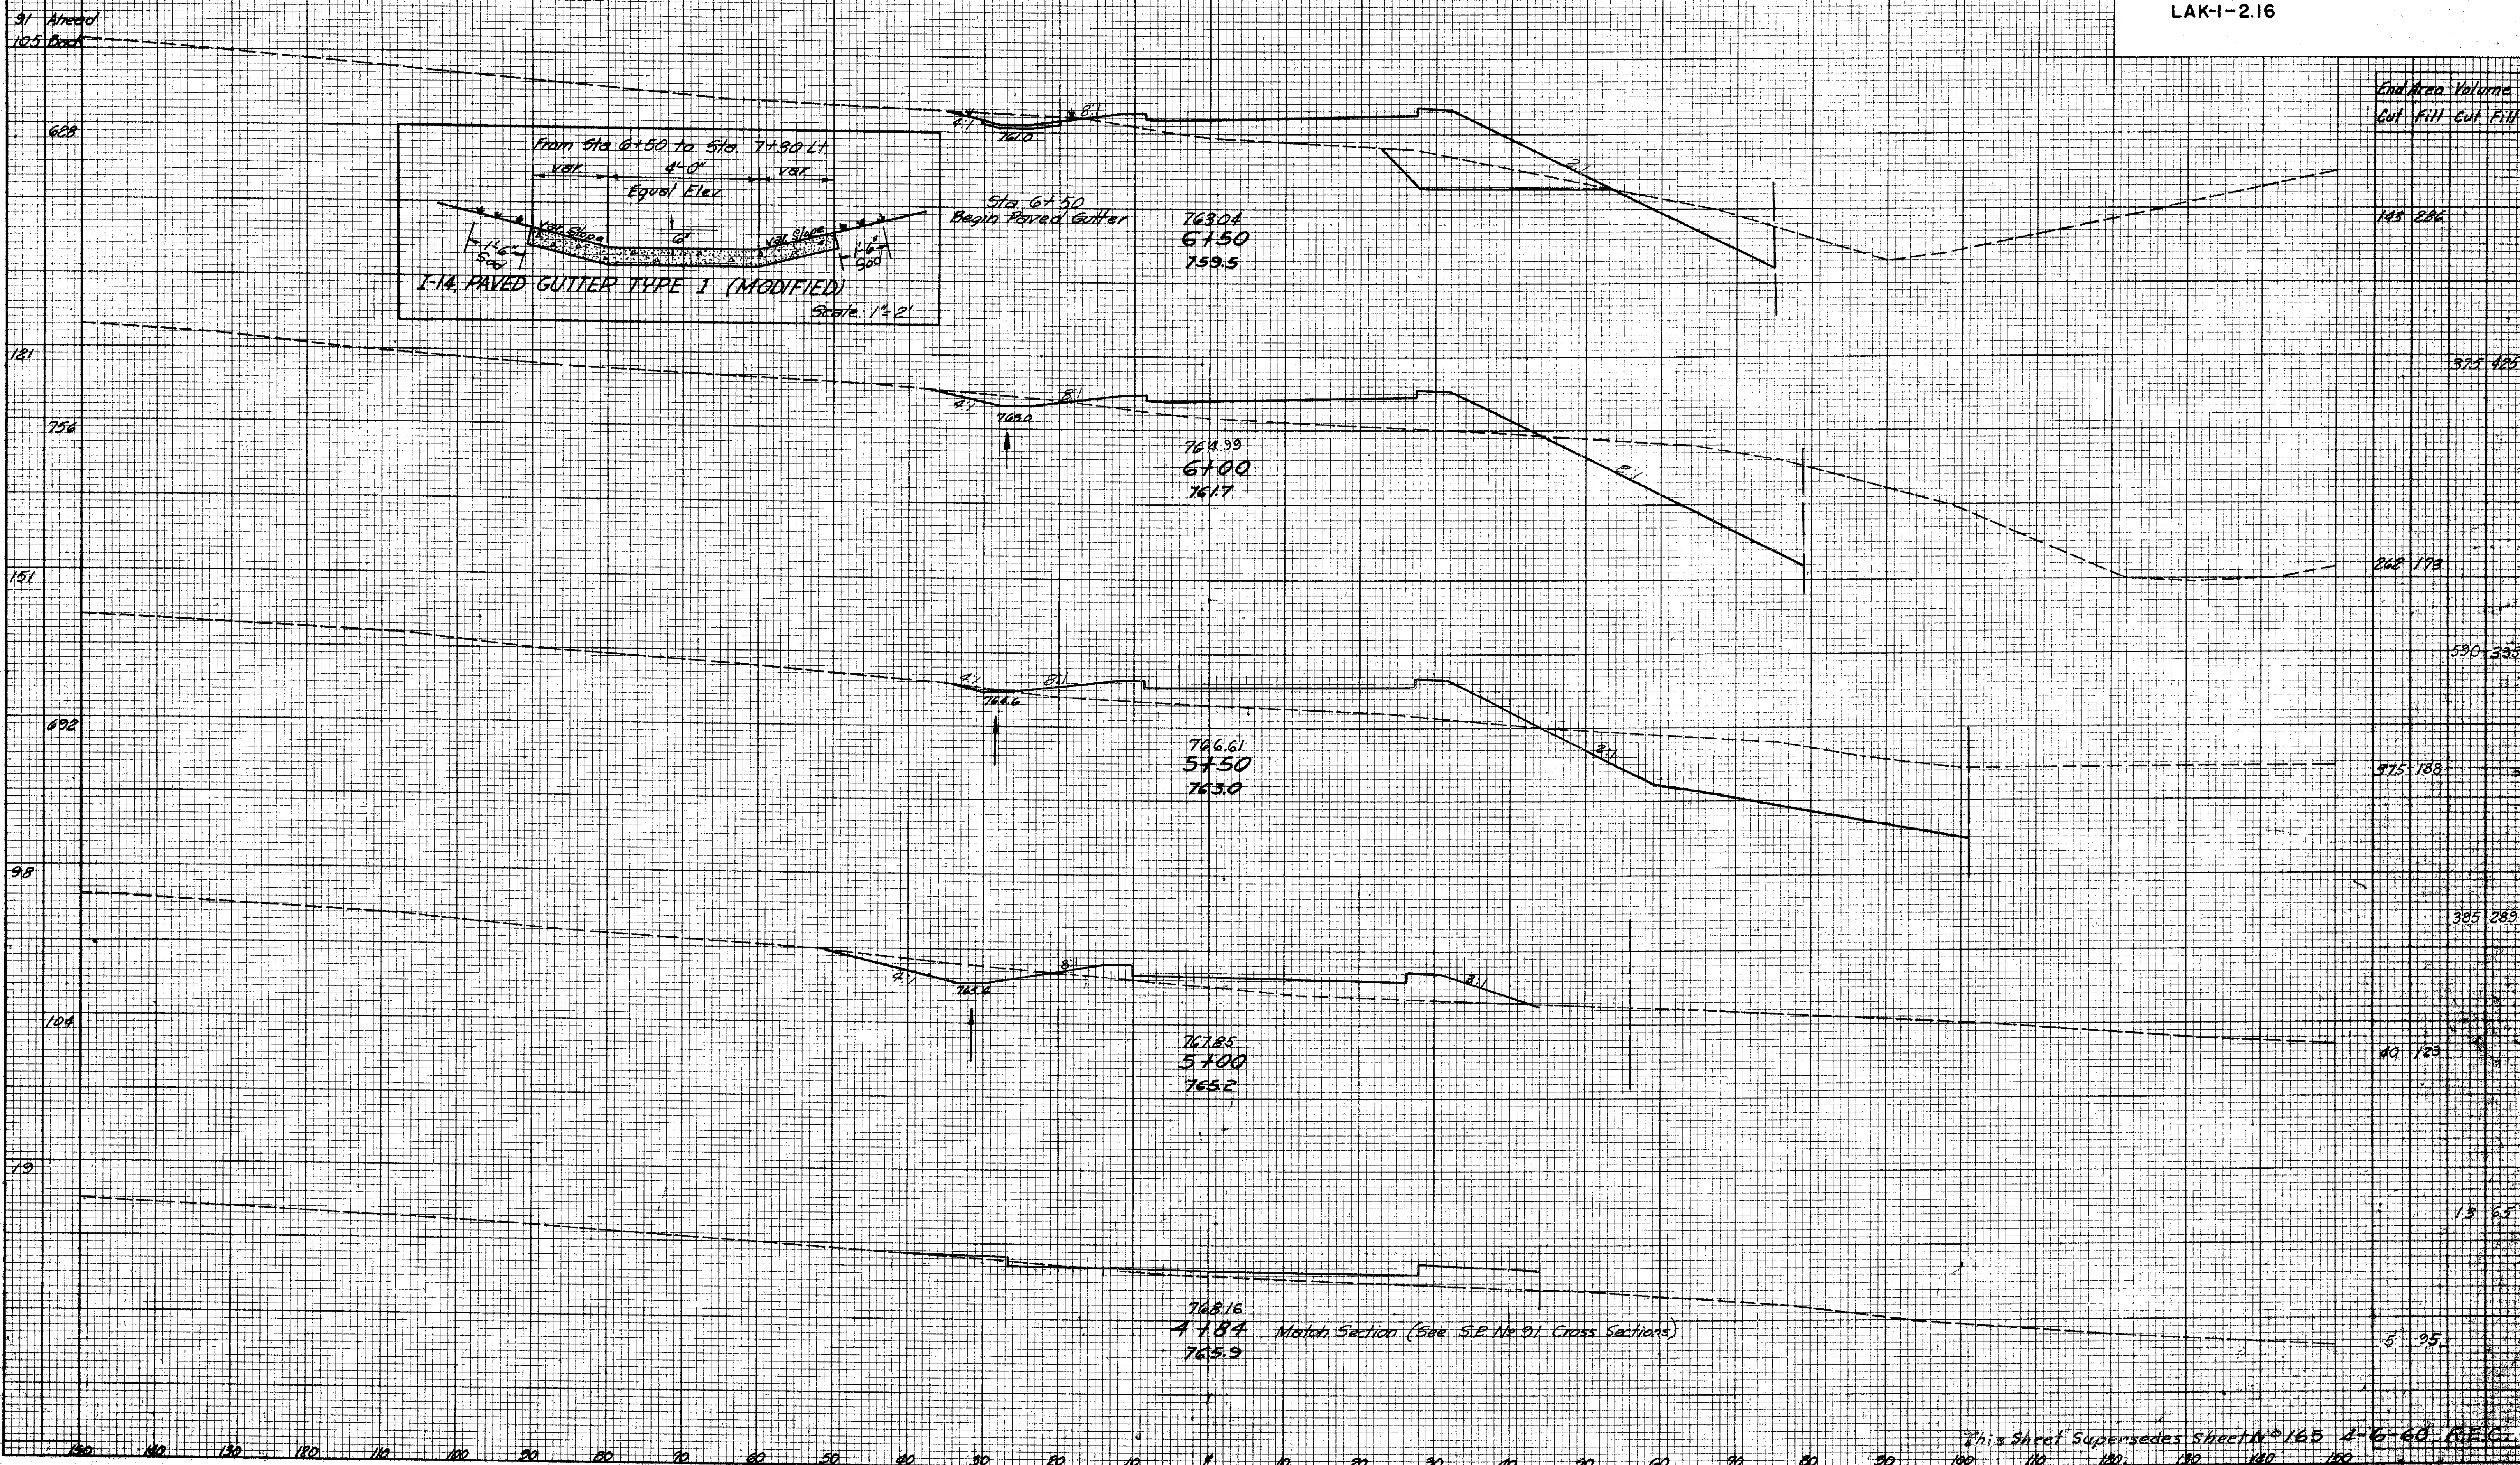

This Sheet Supersedes Sheet No 165 I-6-60 REC
S.P. #91 INTERCHANGE RAMP "B" Sta. 4+04 to Sta. 6+50