

Seeding
End
Width Sq Yd

FED. RD. DIVISION	STATE	PROJECT
2	OHIO	I-1103 (19)

175-S
312

LAKE COUNTY
LAK-1-2.16


End Area
Cut Fill

86.7291

123 30/85

13 9009


36 3188

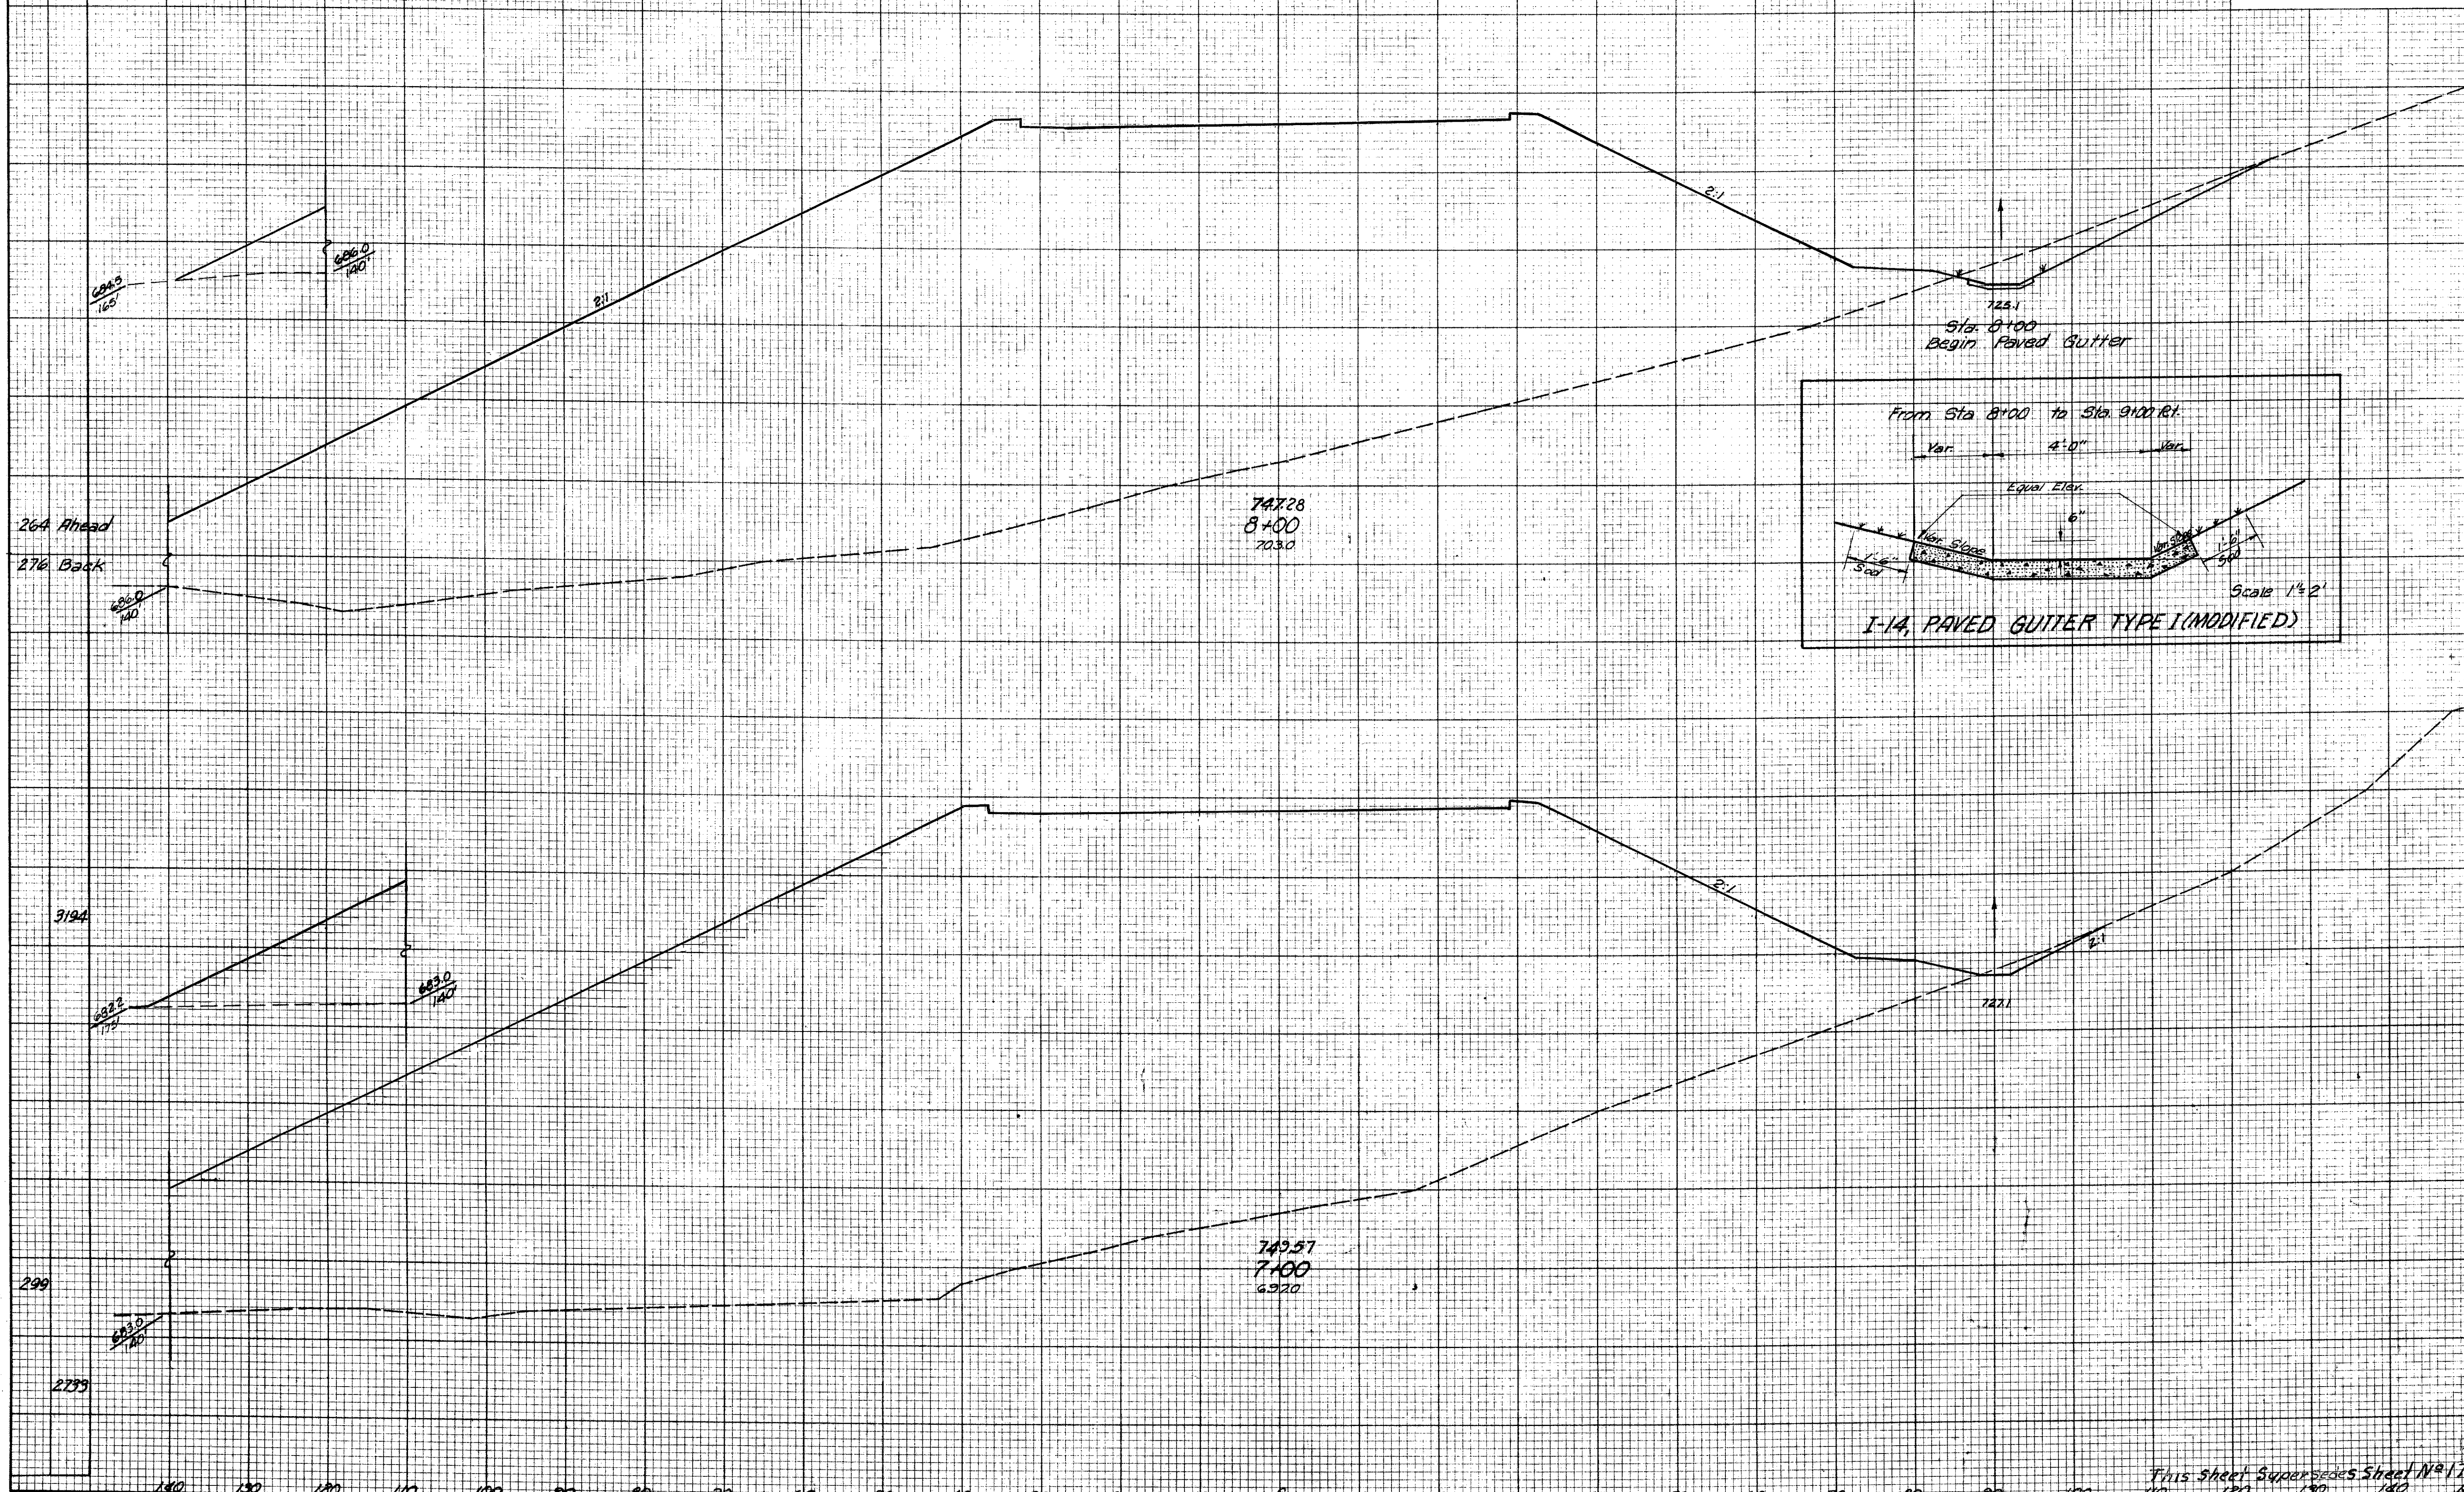

264 Ahead
276 Back

747.28
8+00
703.0

749.57
7+00
692.0

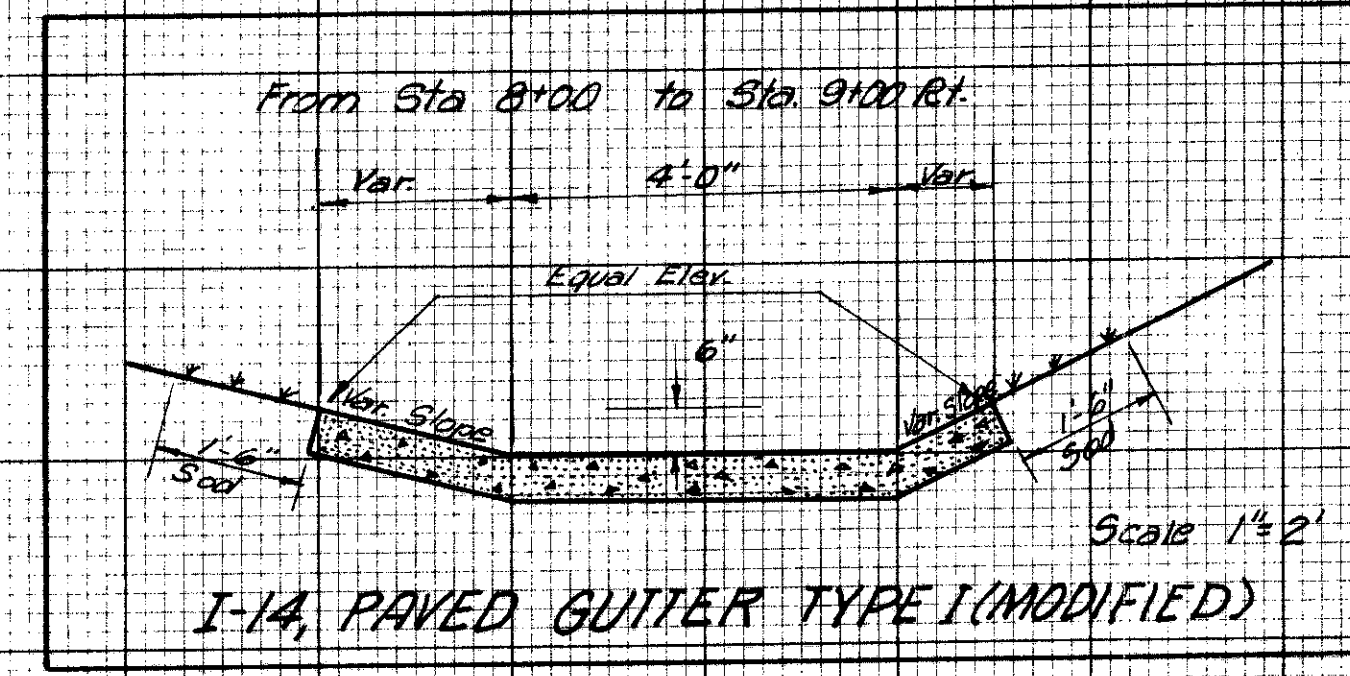

This sheet Supercedes Sheet No. 175 4-6-60 R.E.C.

SR#91 INTERCHANGE RAMP 'CD' STA 7+00 TO STA 8+00