FED. RD. DIVISION	STATE	PROJECT	
2	OHIO	I-1103 (19)	

195-S
312

LAKE COUNTY
LAK-1-2.16

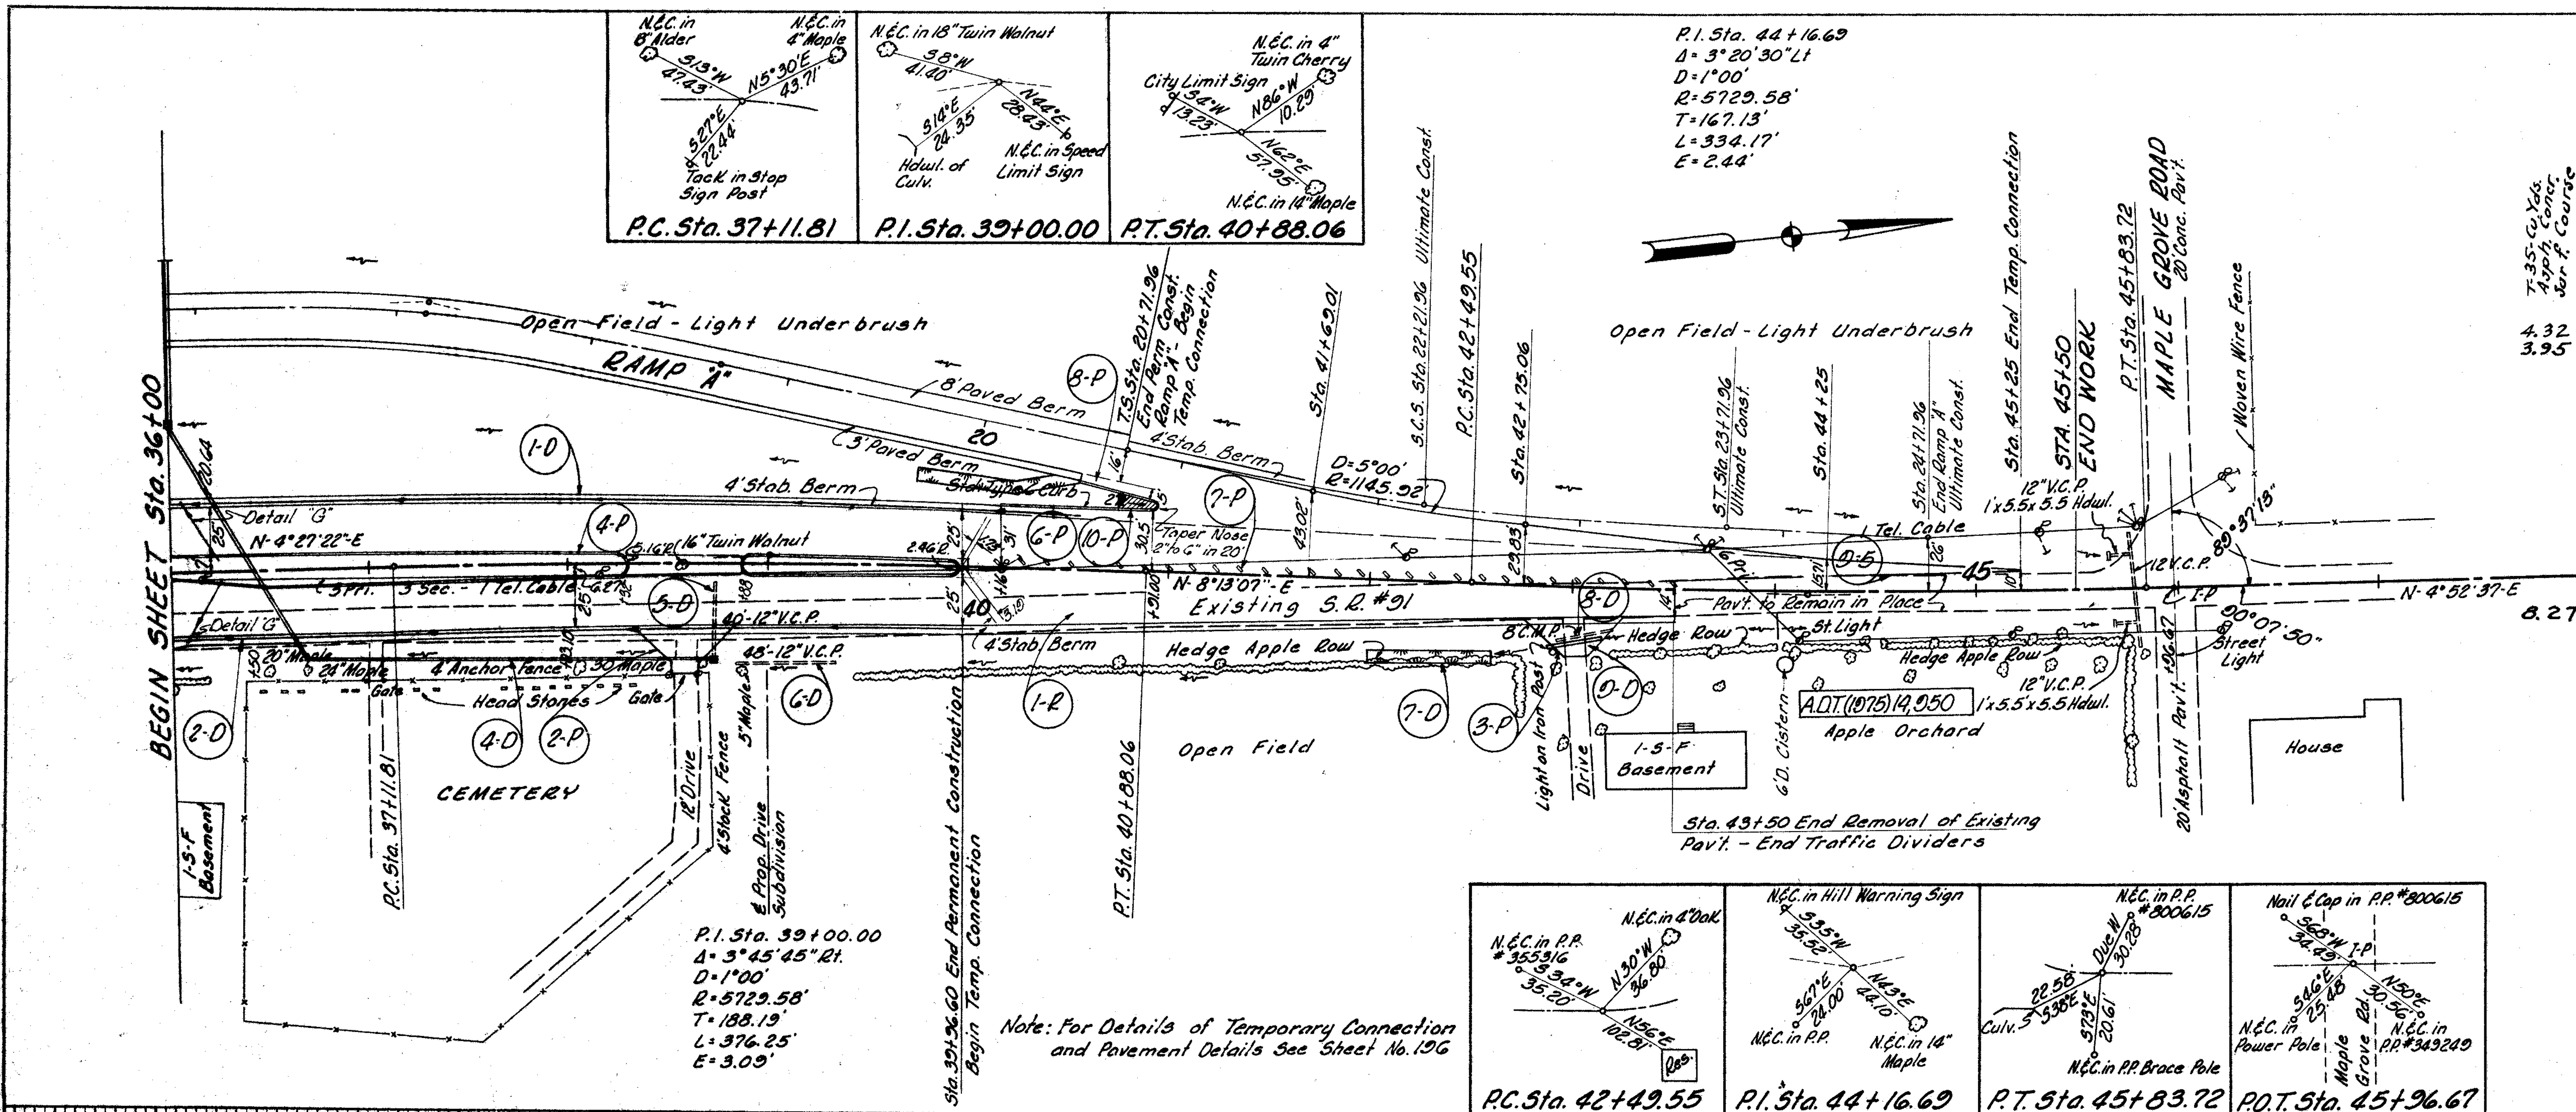

T-35-Cu. Yds. Asph. Conc. Sur. Course
4.32
3.95
8.27

PAVEMENT									
	Station			B-19	I-12	I-12	I-23	B-35	I-21
Ref. No.	From	To	Side ¢	Agg. Base Course	Conc. Curb Type 2-A	Conc. Curb Type 6	Precast Conc. Traf. Dividers	Sealing Vert. Face of Exist. Pvt.	Conc. Med. Pvt. Type 1
				Cu. Yds.	Lin. Ft.	Lin. Ft.	Each	Lin. Ft.	Sq. Yds.
2-P	38+60		Rt.	17					
3-P	43+00		Rt.	16					
4-P	36+00	38+32	Rt. & Lt.		470.3				
5-P	38+88	39+96.6	Rt. & Lt.		206.2				
6-P	39+96.6	39+99.06	Rt. & Lt.			7.72			
7-P	40+02	43+50	Lt.				30		
8-P	40+16	40+93	Lt.			120.28			
9-P	43+50	45+25	Lt. & Rt.					193	
10-P	40+72	40+92.5	Lt.						13
Totals				33	676.5	128.00	30	193	13

DRAINAGE														
See Sh. No.	Ref. No.	Station From	Station To	Side ¢	I-1 Pipe for Driveways Sec. M-6.4(a) 12"	I-2 Class "A" Storm Sew. Under Pvt. or Appr. Sec. M-6.5(b) or Sec. M-6.8(b) 15"	I-3 Roadway Drainage 15"	I-4 Underdrain Shallow 6"	I-5 Pipe Special Underdrain Y Branch 6"x6"x6"	I-5 Class "A" Strm. Sw. Under Pvt. or Apr. Sec. M-6.5(b) or Sec. M-6.8(b) Bend 15"-60°	I-8 Std. No. 2-2-A C.B.	I-9 Stone Underdrain No. 2	E-12 Pipe Removed 15" & Under	L-10 Sodding
					Lin. Ft.	Lin. Ft.	Lin. Ft.	Lin. Ft.	Each	Each	Each	Lin. Ft.	Lin. Ft.	Sq. Yds.
257	1-D	36+00	40+55	Lt.				489	1					
257	2-D	36+00	40+00	Rt.				433	1					
	4-D	36+00	38+75	Rt.		124	204			1	1			
	5-D	38+74		Rt.									40	
	6-D	39+00		Rt.									48	93
	7-D	42+00	42+60	Rt.										
	8-D	43+00		Rt.									28	
	9-D	43+00		Rt.	26									
		40+00	43+50	Rt.								70		
		40+75	44+75	Lt.								90		
Totals					26	124	204	928	2	1	1	160	116	93

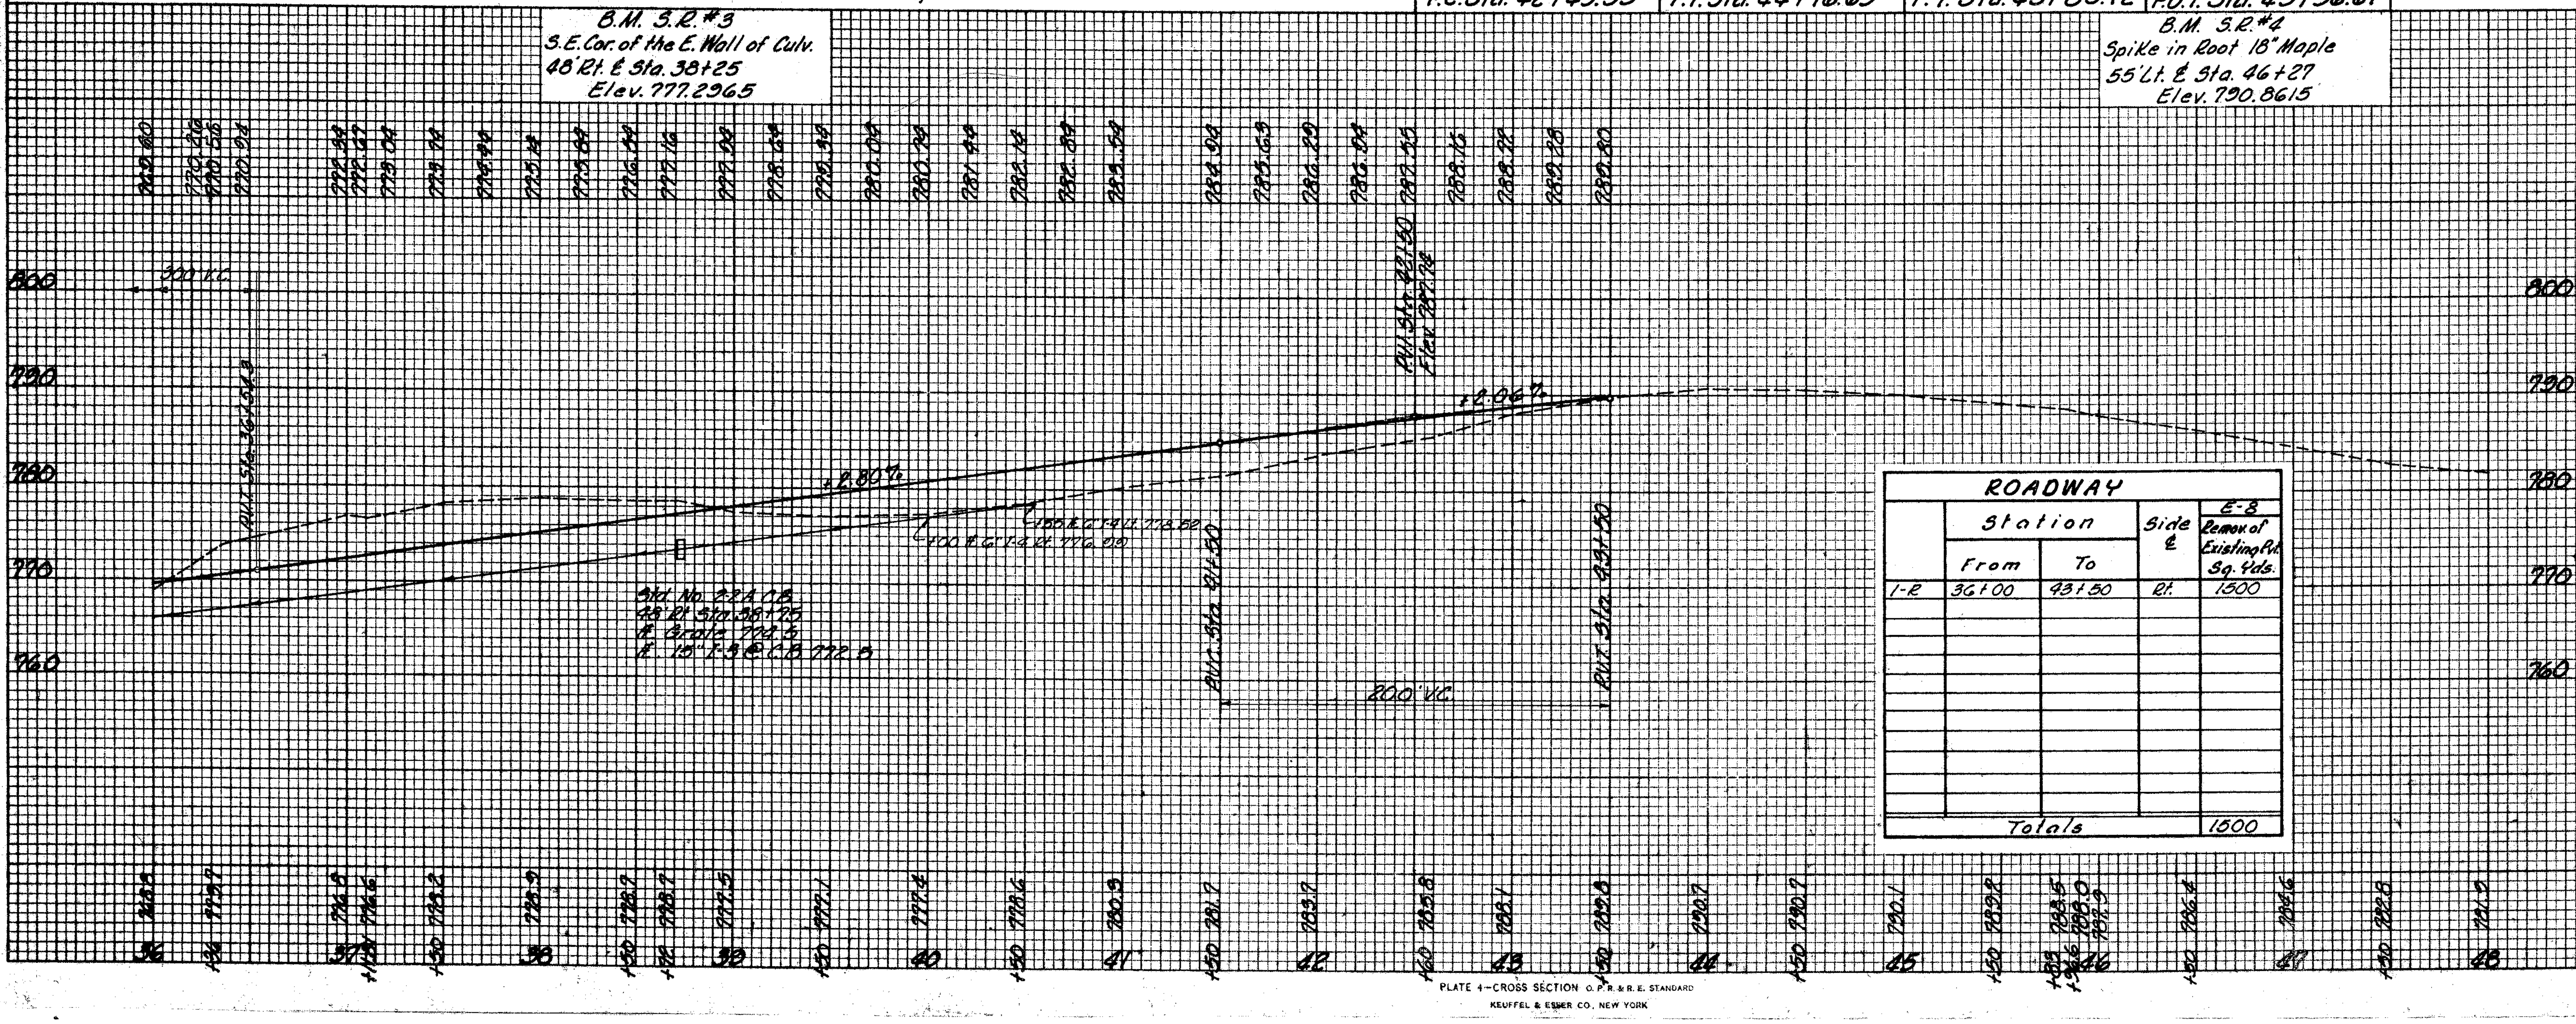

ROADWAY				
	Station		Side ¢	E-8 Remov. of Existing Pvt. Sq. Yds.
	From	To		
1-R	36+00	43+50	Rt.	1500
Totals				1500

This Sheet Supersedes Sheet No 195 4-6-60 R.E.C.

REVISIONS	
3-22-60	Grade Raise for 16'-4" Br. Cl.

MICHAEL BAKER, JR., CONSULTING ENGINEERS
ROCHESTER, PENNSYLVANIA

STATE OF OHIO
DEPARTMENT OF HIGHWAYS
STATE HIGHWAY NO. 1
C-43
STATE ROUTE NO. 91 RELOCATION
STA. 36+00 TO STA. 48+00

Designed	Drawn	Traced	Checked	Reviewed Date	Revised
H. vV.	J.S.	A.L.H.	B.P.		

FINAL SURVEY	BY
SURVEYED	
PLOTTED	
TEMPLATE	
AREAS	
AREAS CHECKED	
NOTE BOOK	
NO.	

ORIGINAL SURVEY	BY	DATE
SURVEYED		
PLOTTED		
TEMPLATE		
AREAS		
AREAS CHECKED		
NOTE BOOK		
NO.		

PLATE 4—CROSS SECTION O. P. R. & R. E. STANDARD
KEUFFEL & ESSER CO., NEW YORK