


Seeding  
End  
width 37.16

FED. RD. DIVISION	STATE	PROJECT
2	OHIO	I-1103 (19)

206-3  
312

LAKE COUNTY  
LAK-1-2.16

End Area Volume  
Cut Fill Cut Fill

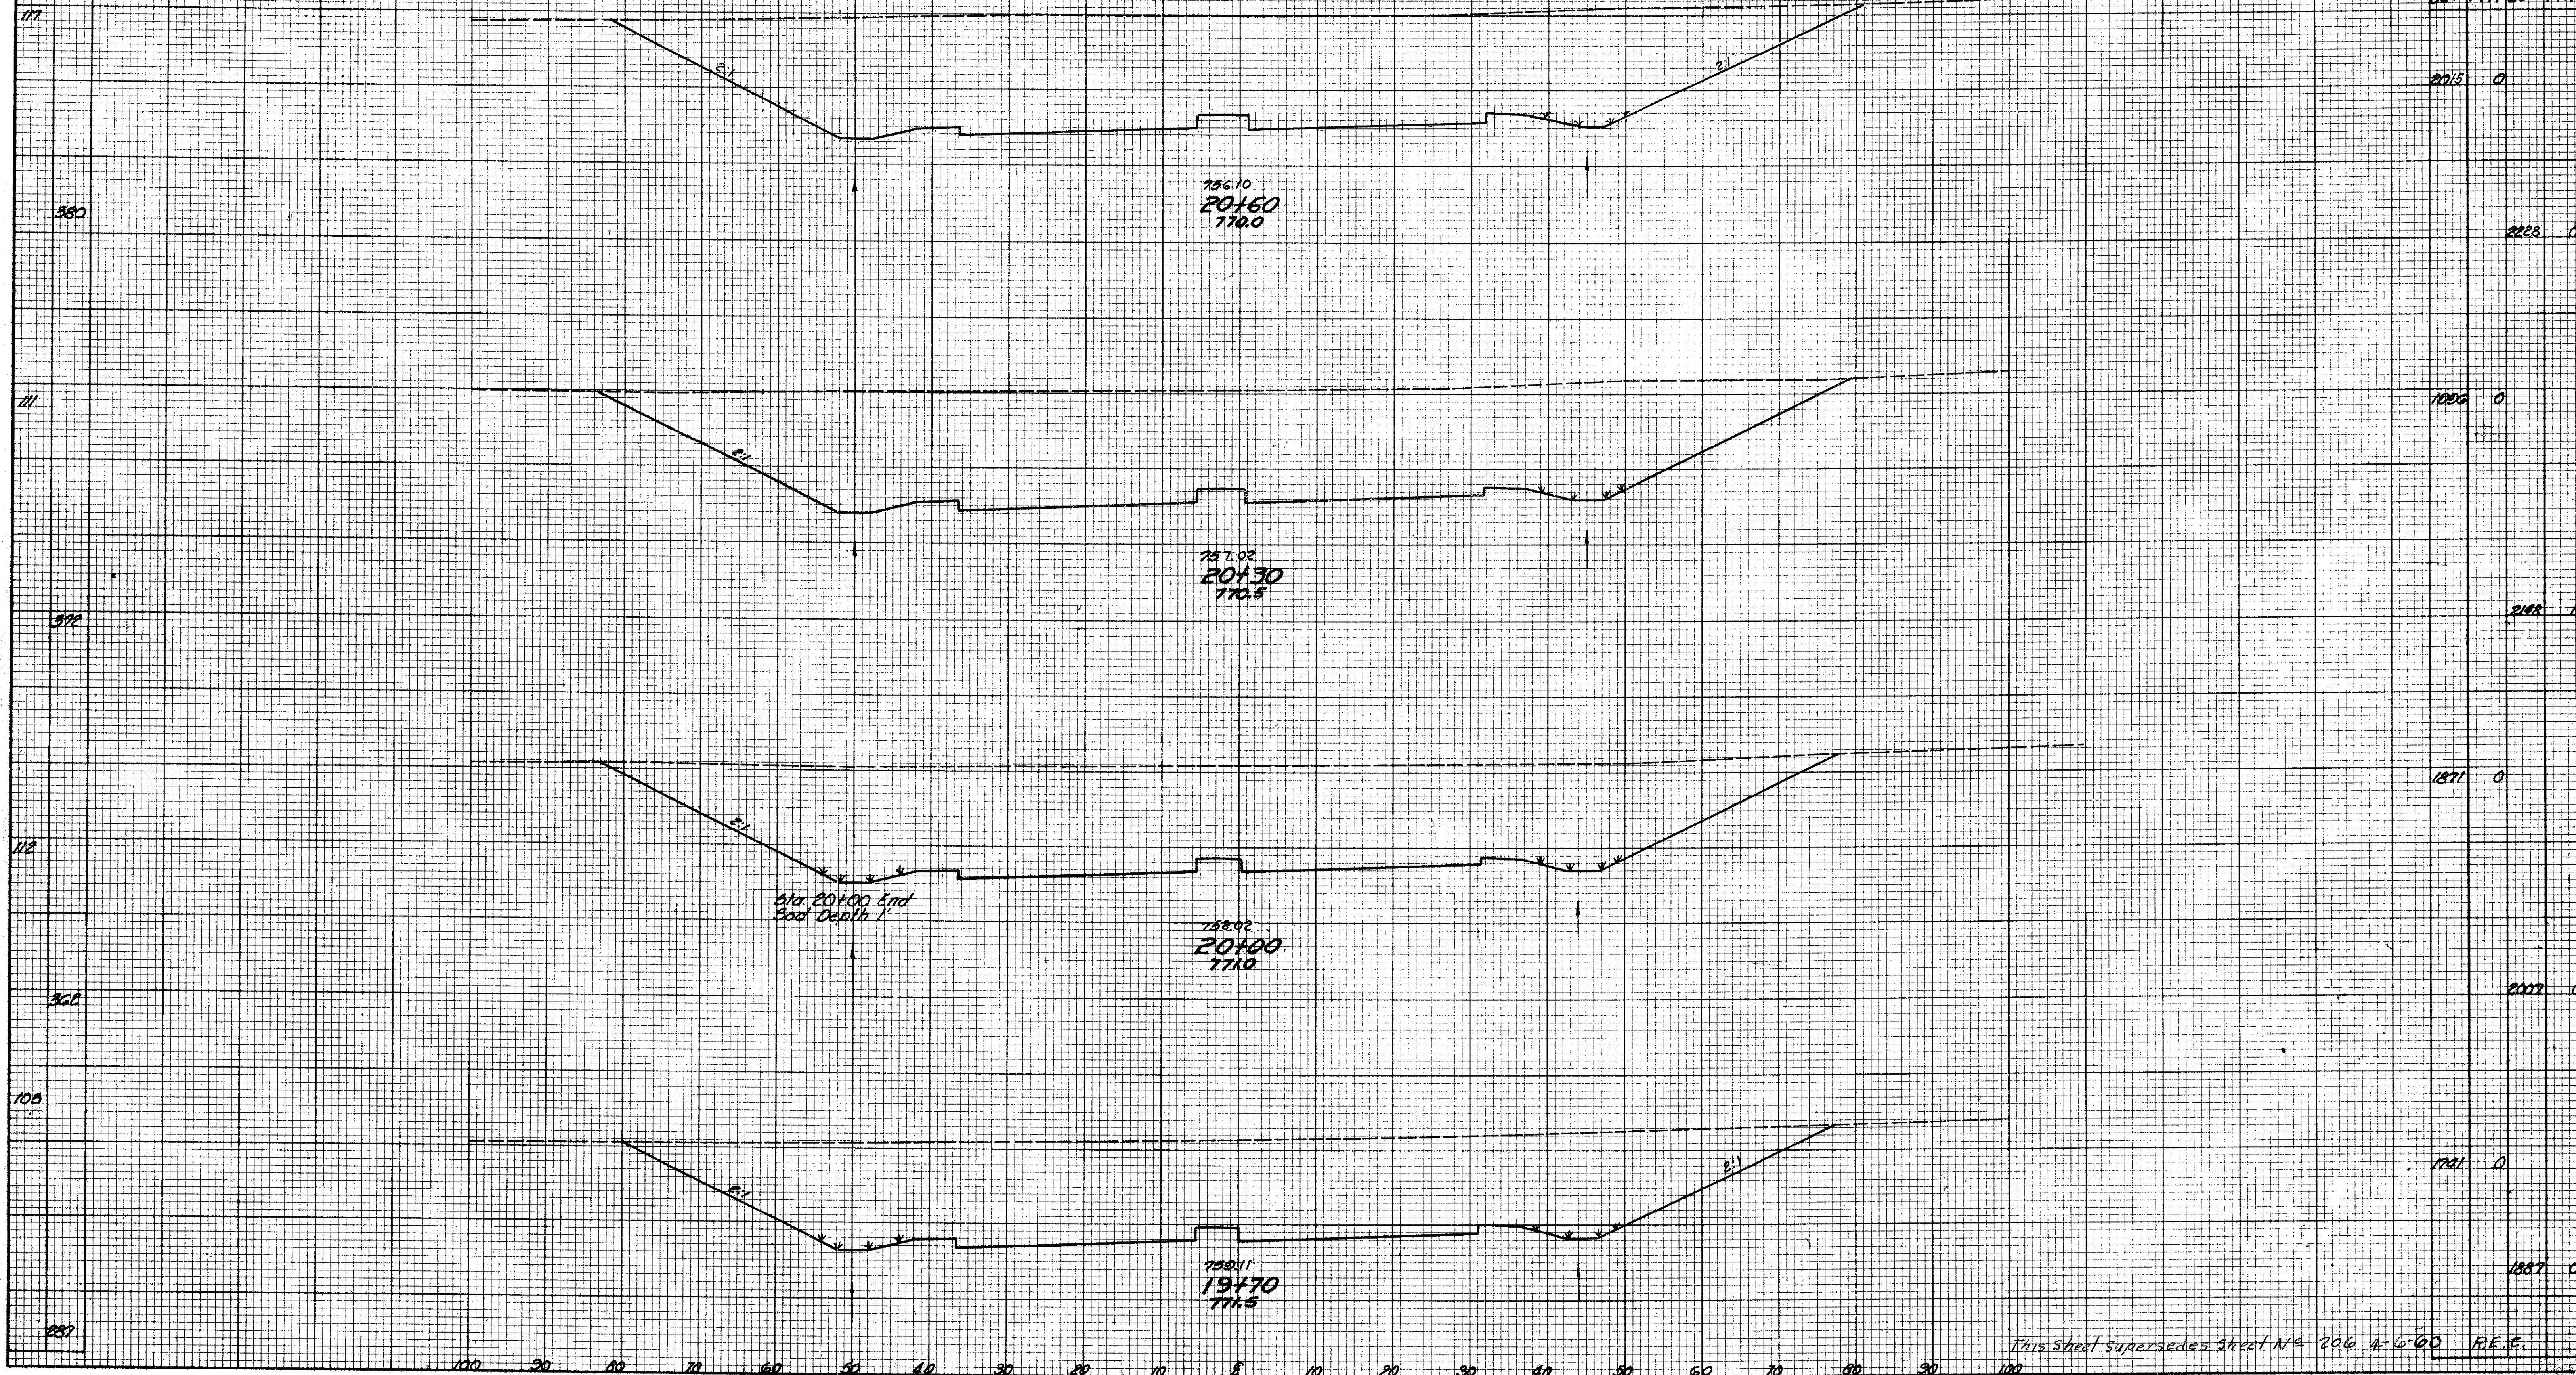

2015 0

2223 0

1000 0

2168 0

1871 0

2007 0

1721 0

1887 0

This sheet supersedes sheet No. 206-4-6-60 R.E.E.

S.P. NO. 91 RELOCATION STA. 19+70 TO STA. 20+60