


Seeding
End
Width Sqft

FED. RD. DIVISION	STATE	PROJECT	
2	OHIO	I-1103 (19)	

213-5
312

LAKE COUNTY
LAK-1-2.16

End Area	Volume
Cut	Fill
Cut	Fill

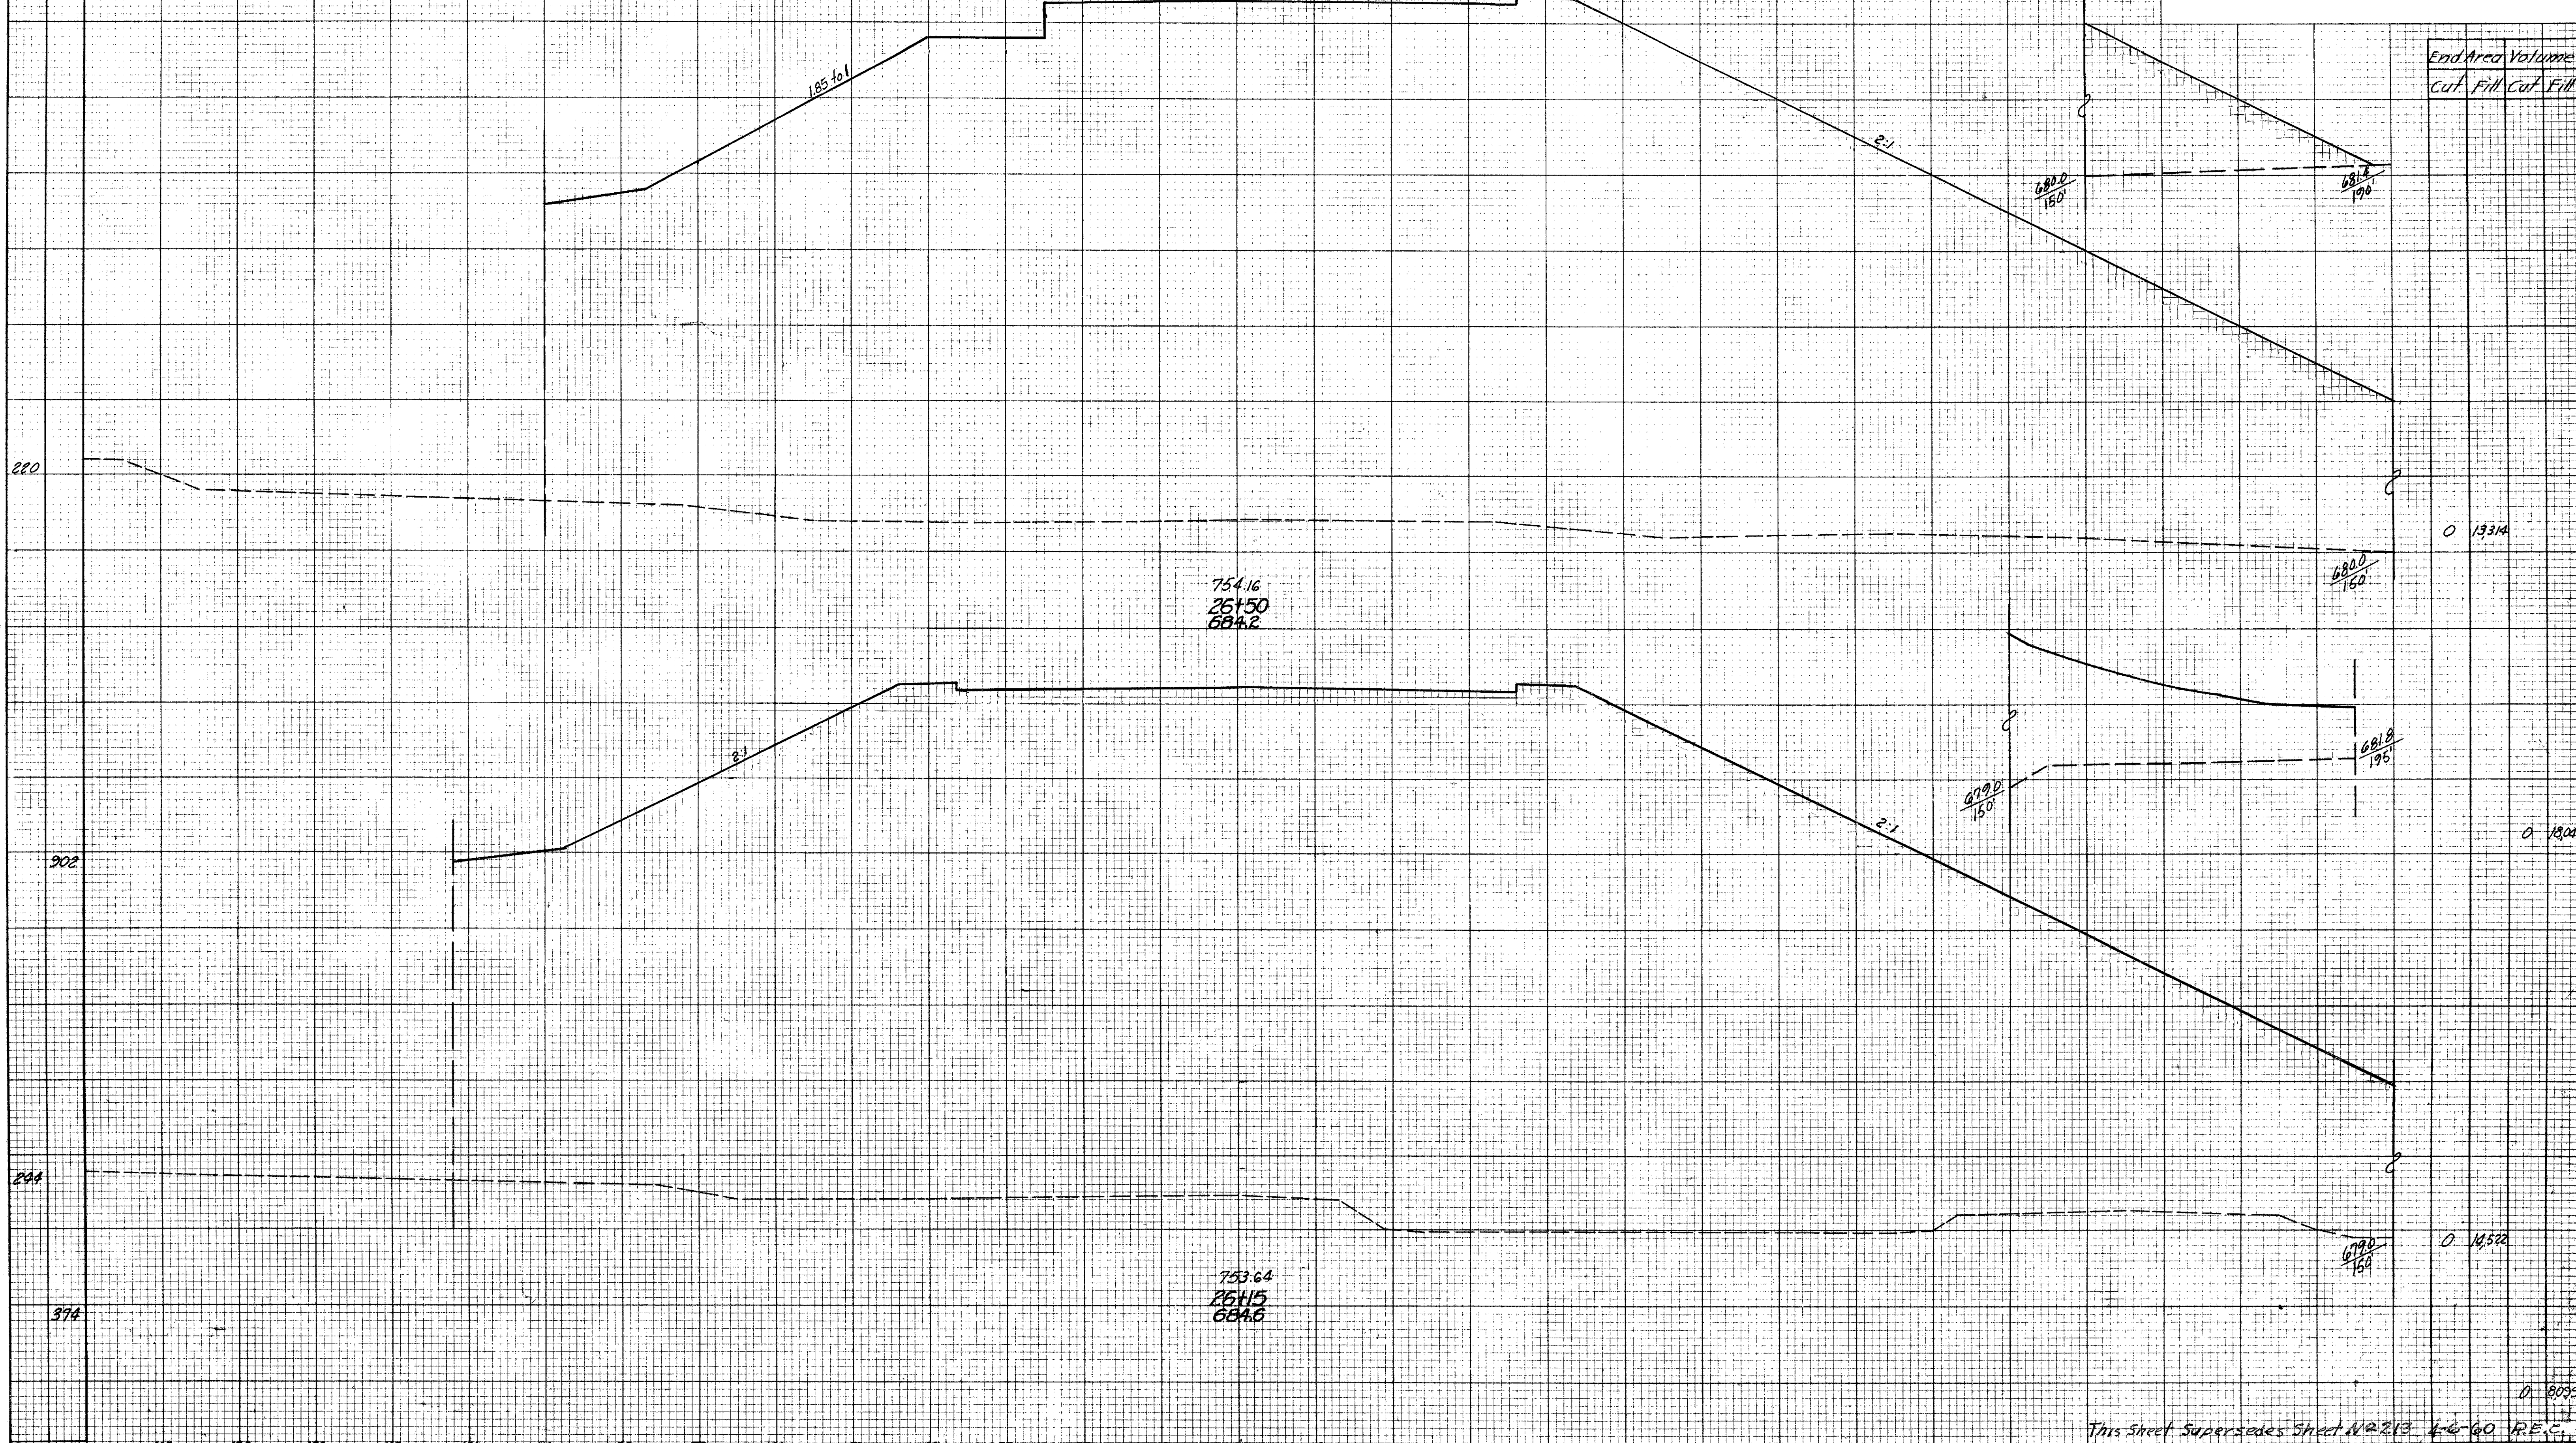

This Sheet Supersedes Sheet No. 213 4-6-60 P.E.C.

S.R. No. 91 RELOCATION Sta. 26+15 To Sta. 26+50