


Springing
and
Width 39.1d

FED. RD. DIVISION	STATE	PROJECT
2	OHIO	I-1103 (19)

214-S
3/2

LAKE COUNTY
LAK-1-2.16

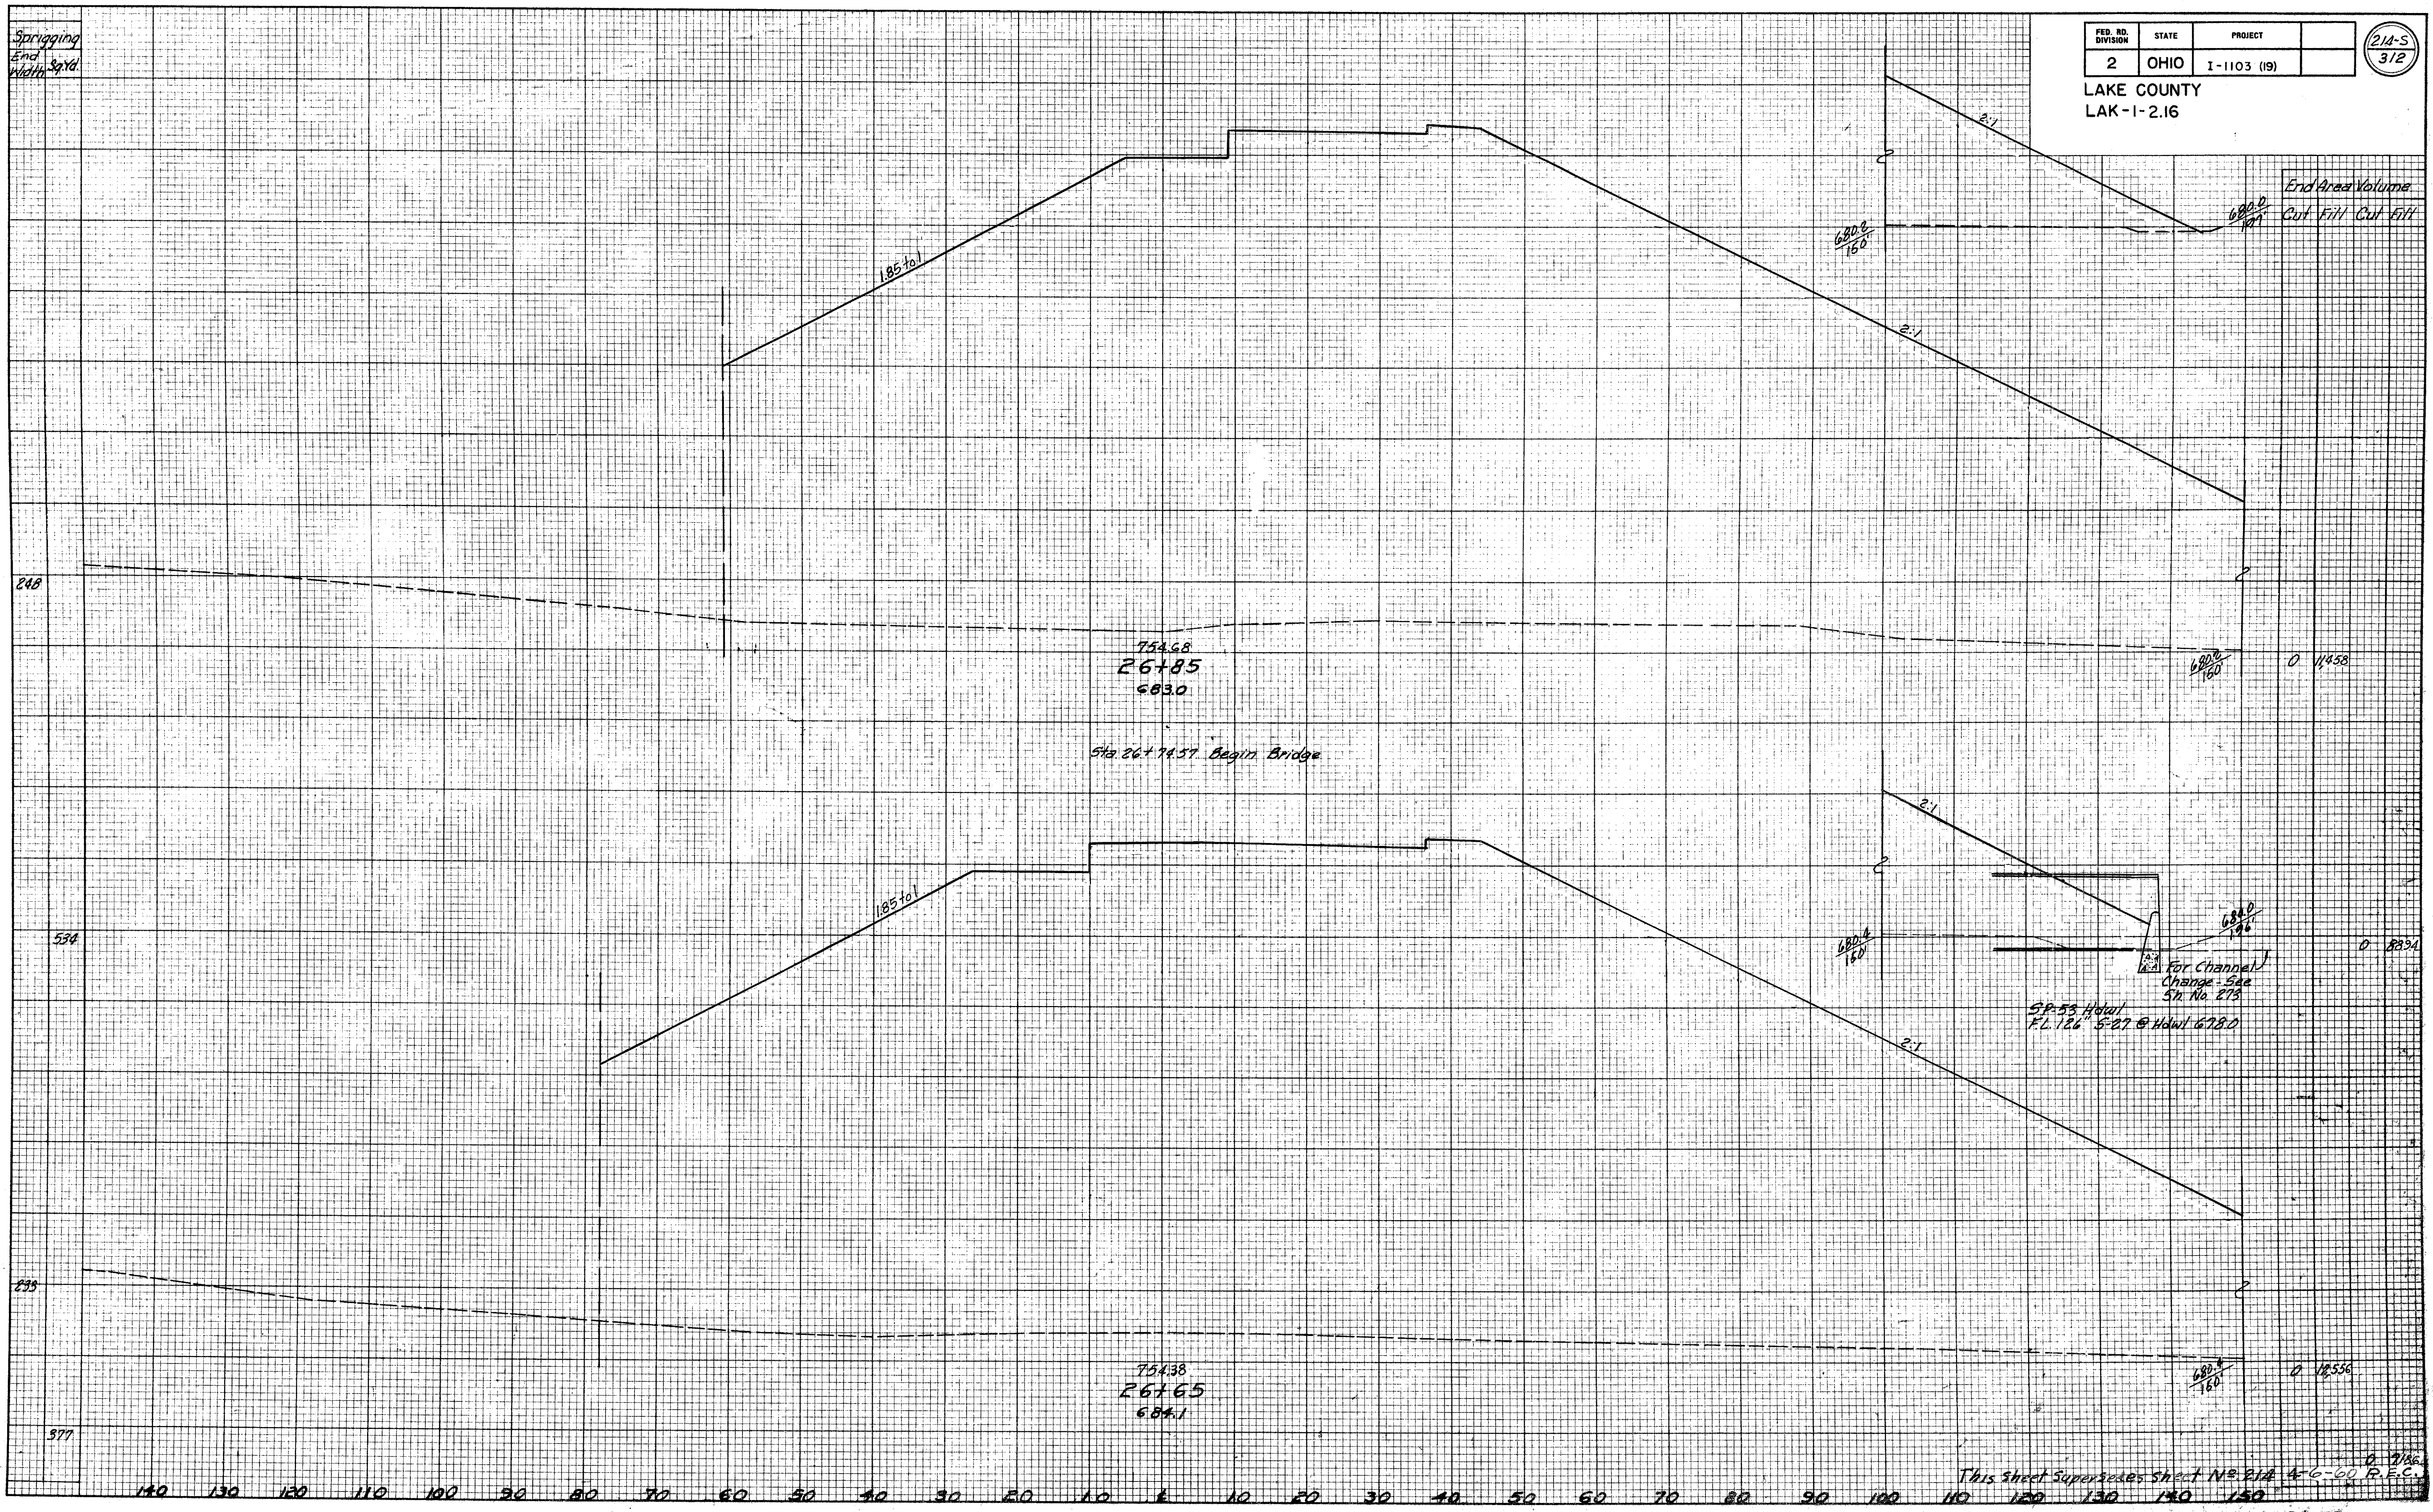

End Area Volume
Cut Fill Cut/Fill

754.68
26+85
683.0

Sta. 26+74.57 Begin Bridge

For Channel
Change - See
Sta. No. 275
SP-53 Hdwal
F.L. 126' 5'-27" @ Hdwal 678.0'

754.38
26+65
684.1

This sheet supersedes sheet No. 81A 4-6-60 P.E.C.

Sta. No. 91 RELOCATION Sta. 26+65 To Sta. 26+85