


Springing
End
Width Sq. Ft.

FED. RD. DIVISION	STATE	PROJECT
2	OHIO	I-1103 (19)

215-S
312

LAKE COUNTY
LAK-1-2.16

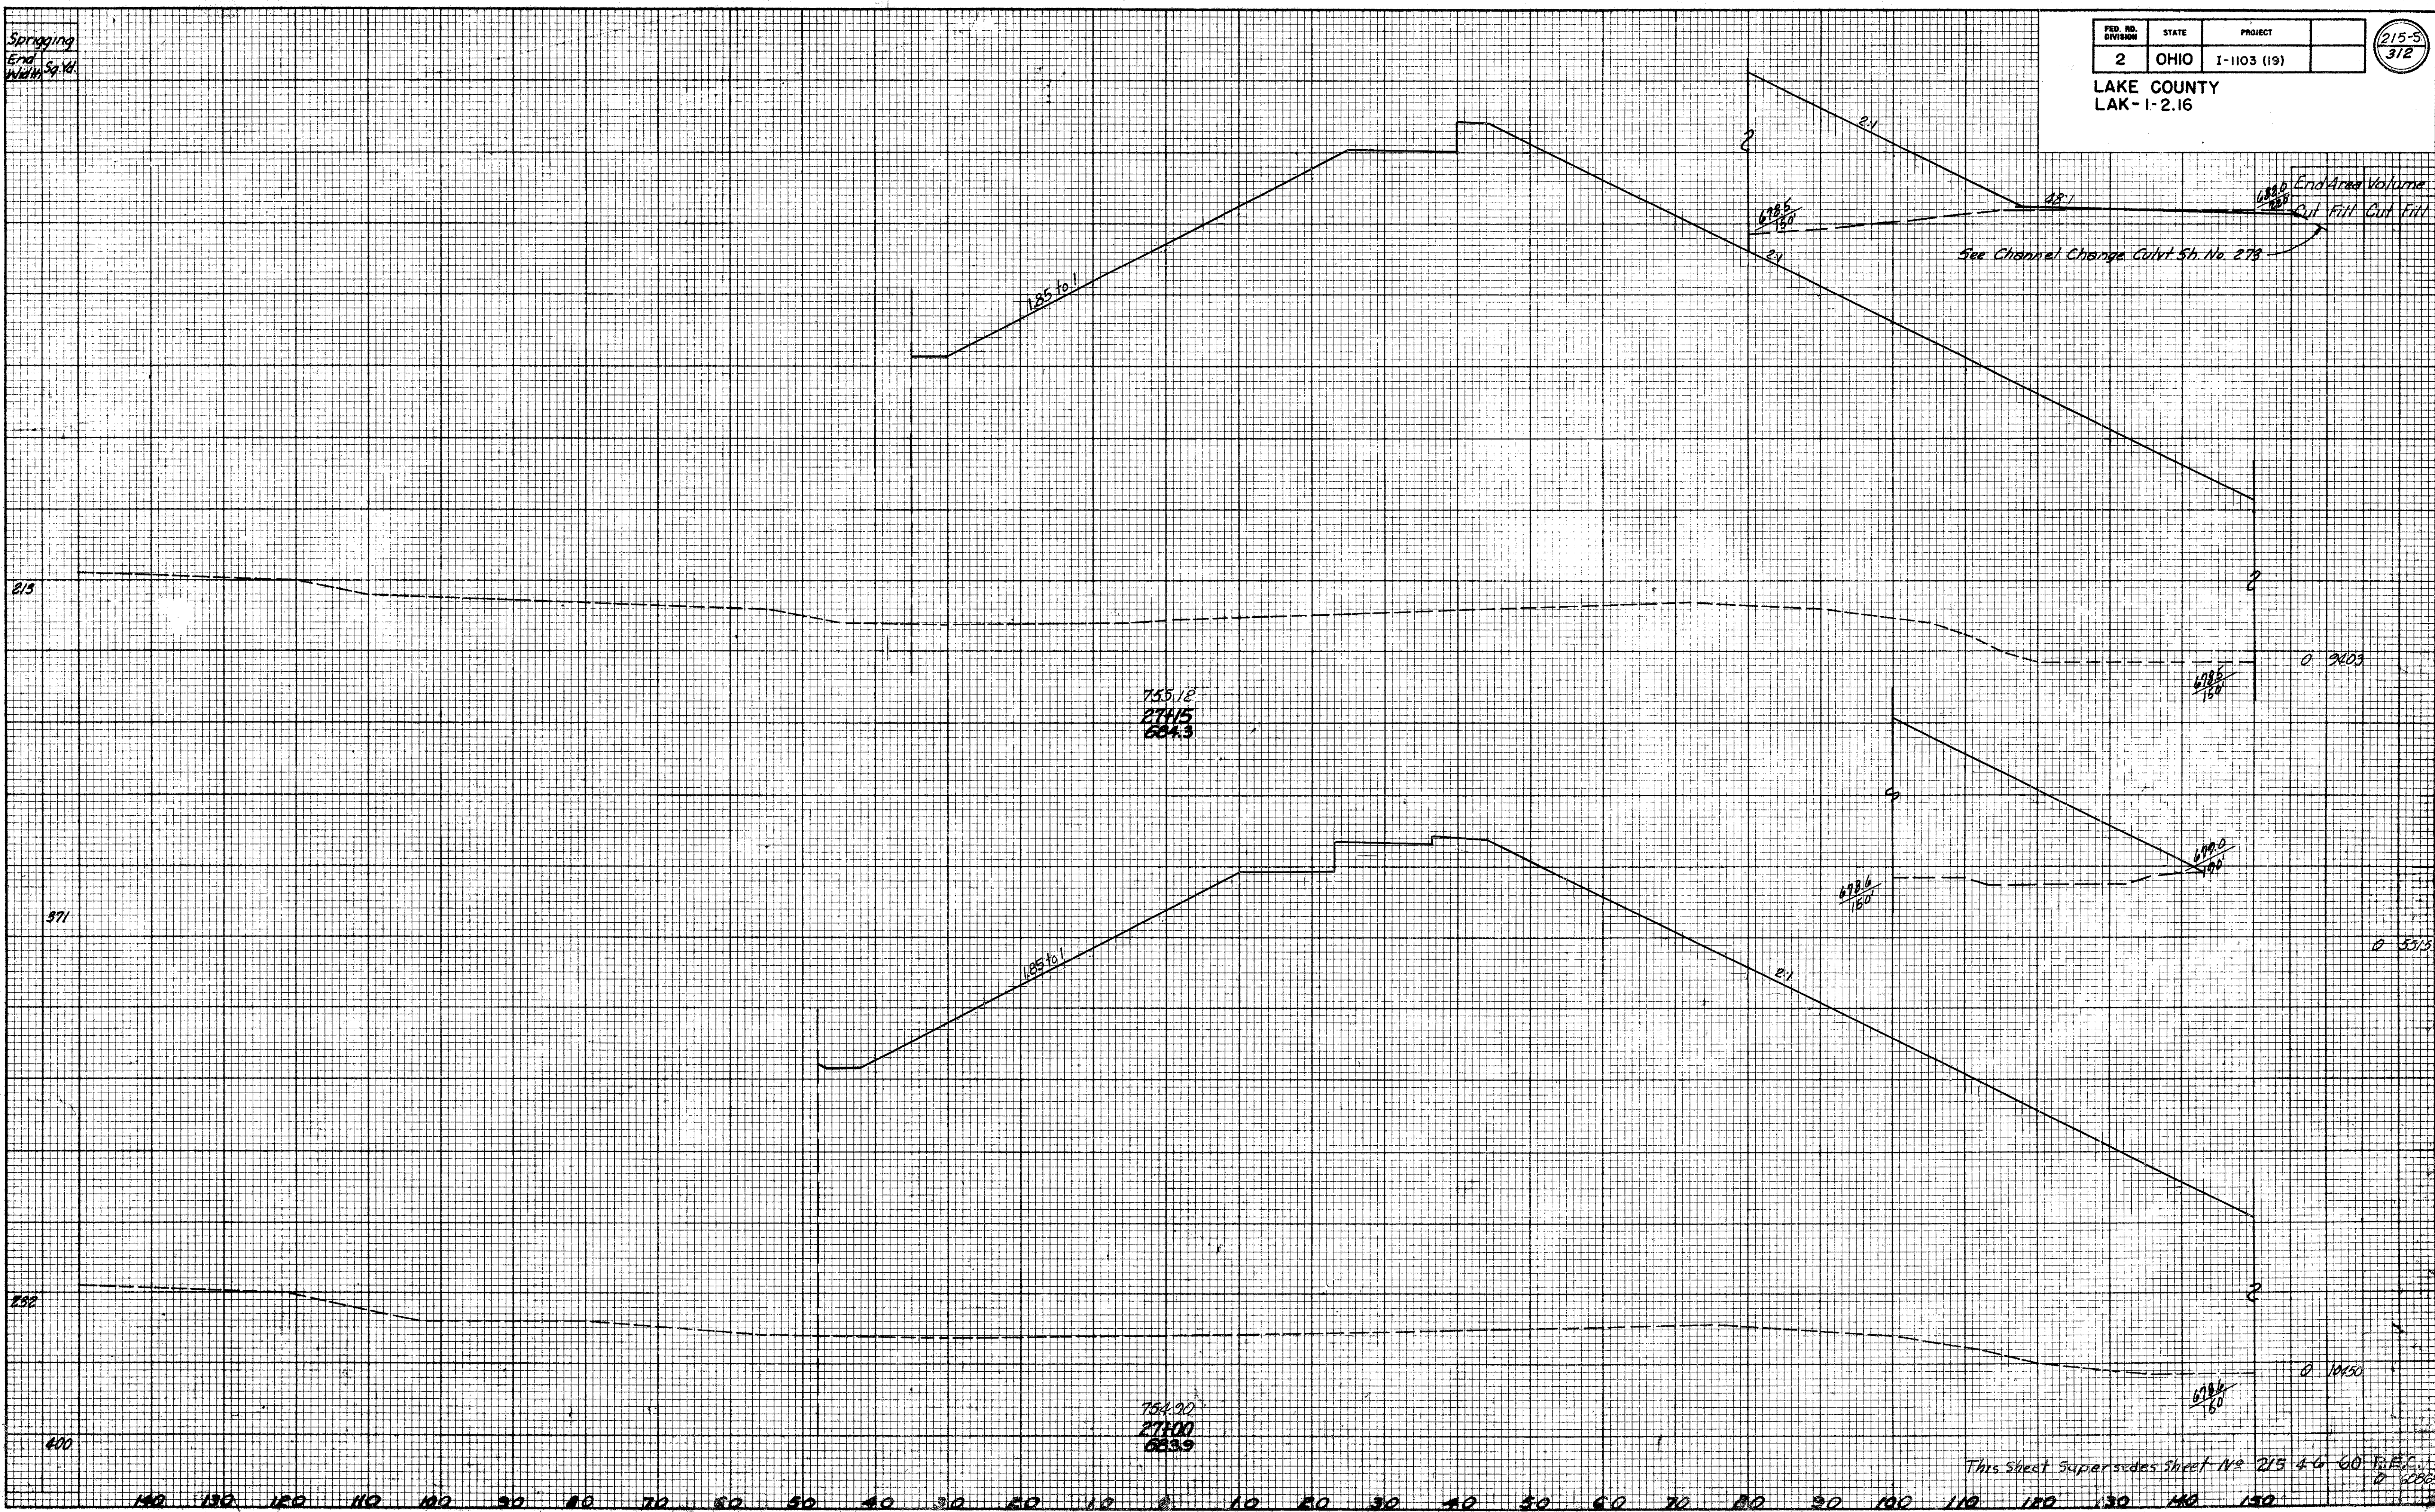

This sheet supersedes sheet No 215 4-6 60 P.F.C. D 6006