


Seeding
End
Width Sq. Ft.

FED. RD. DIVISION	STATE	PROJECT
2	OHIO	I-1103 (19)

2175
312

LAKE COUNTY
LAK-1-2.16

End Area Volume	
Cut	Fill

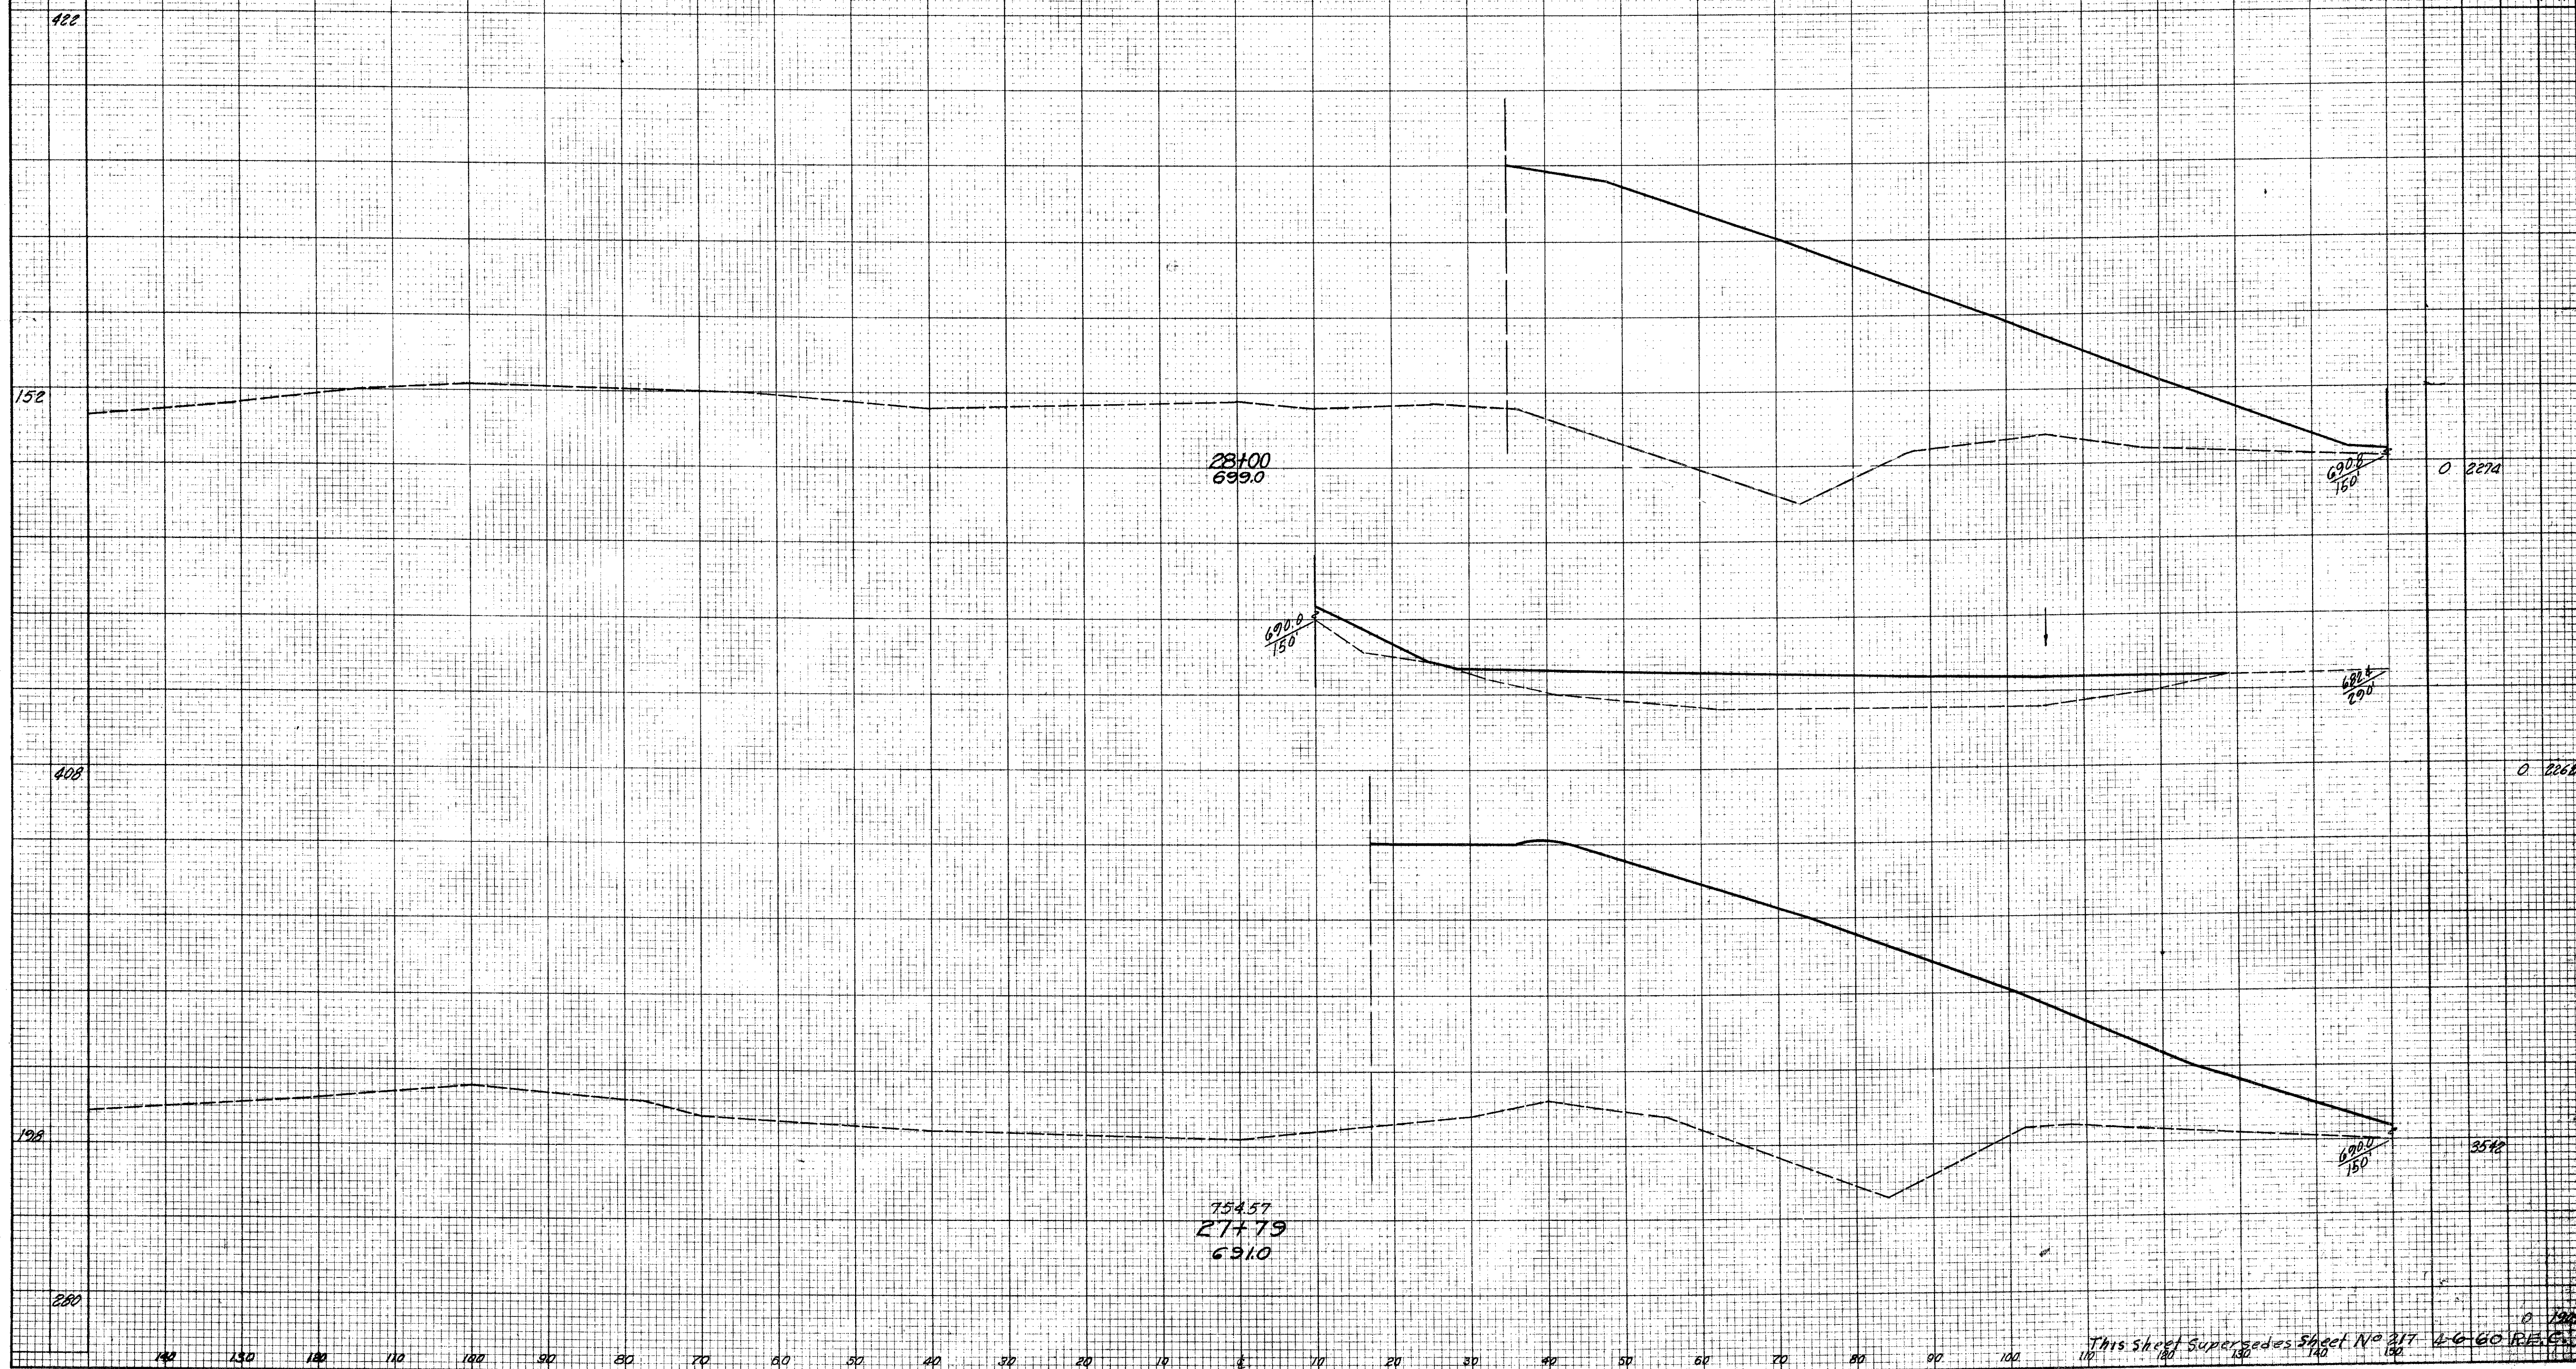

This Sheet Supersedes Sheet No. 217 4-6-60 R.E.S.

S.R. NO. 91 RELOCATION STA. 27+79 TO STA. 28+00