


Seeding  
and  
width Sqd.

FED. RD. DIVISION	STATE	PROJECT
2	OHIO	I-1103 (19)

2185  
312

LAKE COUNTY  
LAK-1-2.16

End Area		Volume	
Cut	Fill	Cut	Fill

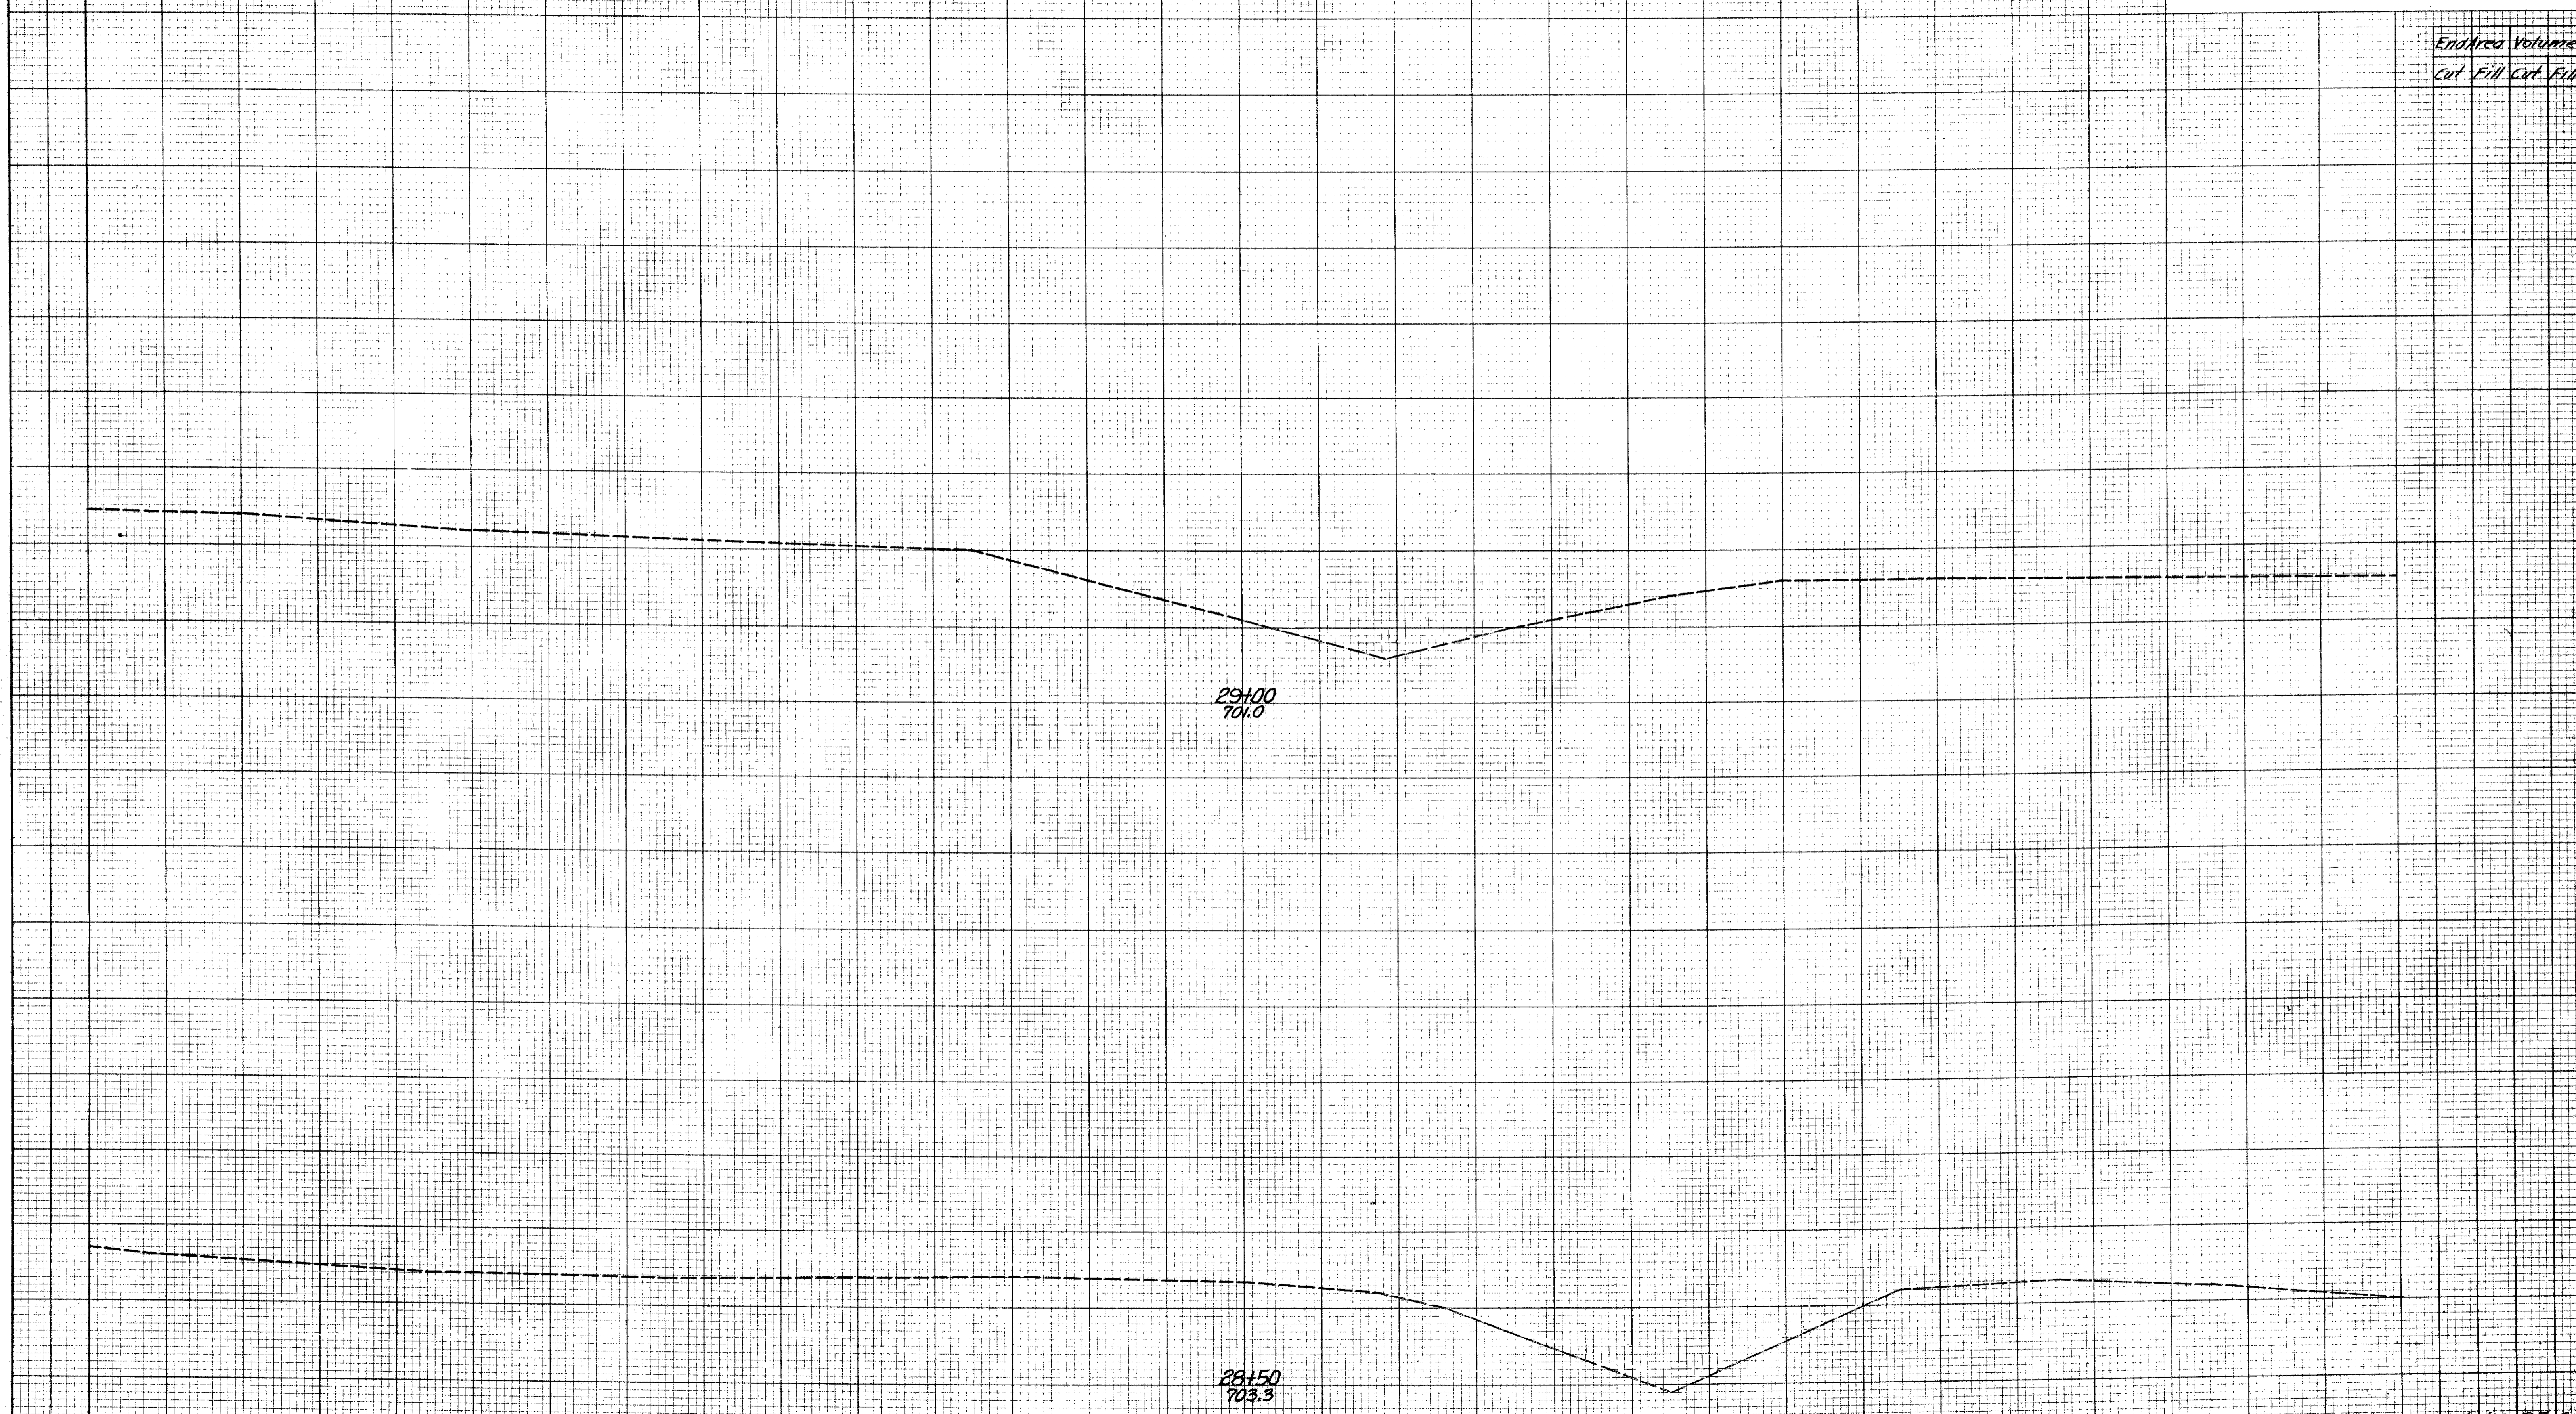

140 130 120 110 100 90 80 70 60 50 40 30 20 10 0 10 20 30 40 50 60 70 80 90 100 110 120 130 140

This Sheet Supersedes Sheet No. 218 A-6 60 R.E.C.  
S.R. NO. 91 RELOCATION STA. 28+50 TO STA. 29+00