


Seeding
End Width
Sq. Yd.

FED. RD. DIVISION	STATE	PROJECT
2	OHIO	I-1103 (19)

2215
312

LAKE COUNTY
LAK-1-2.16

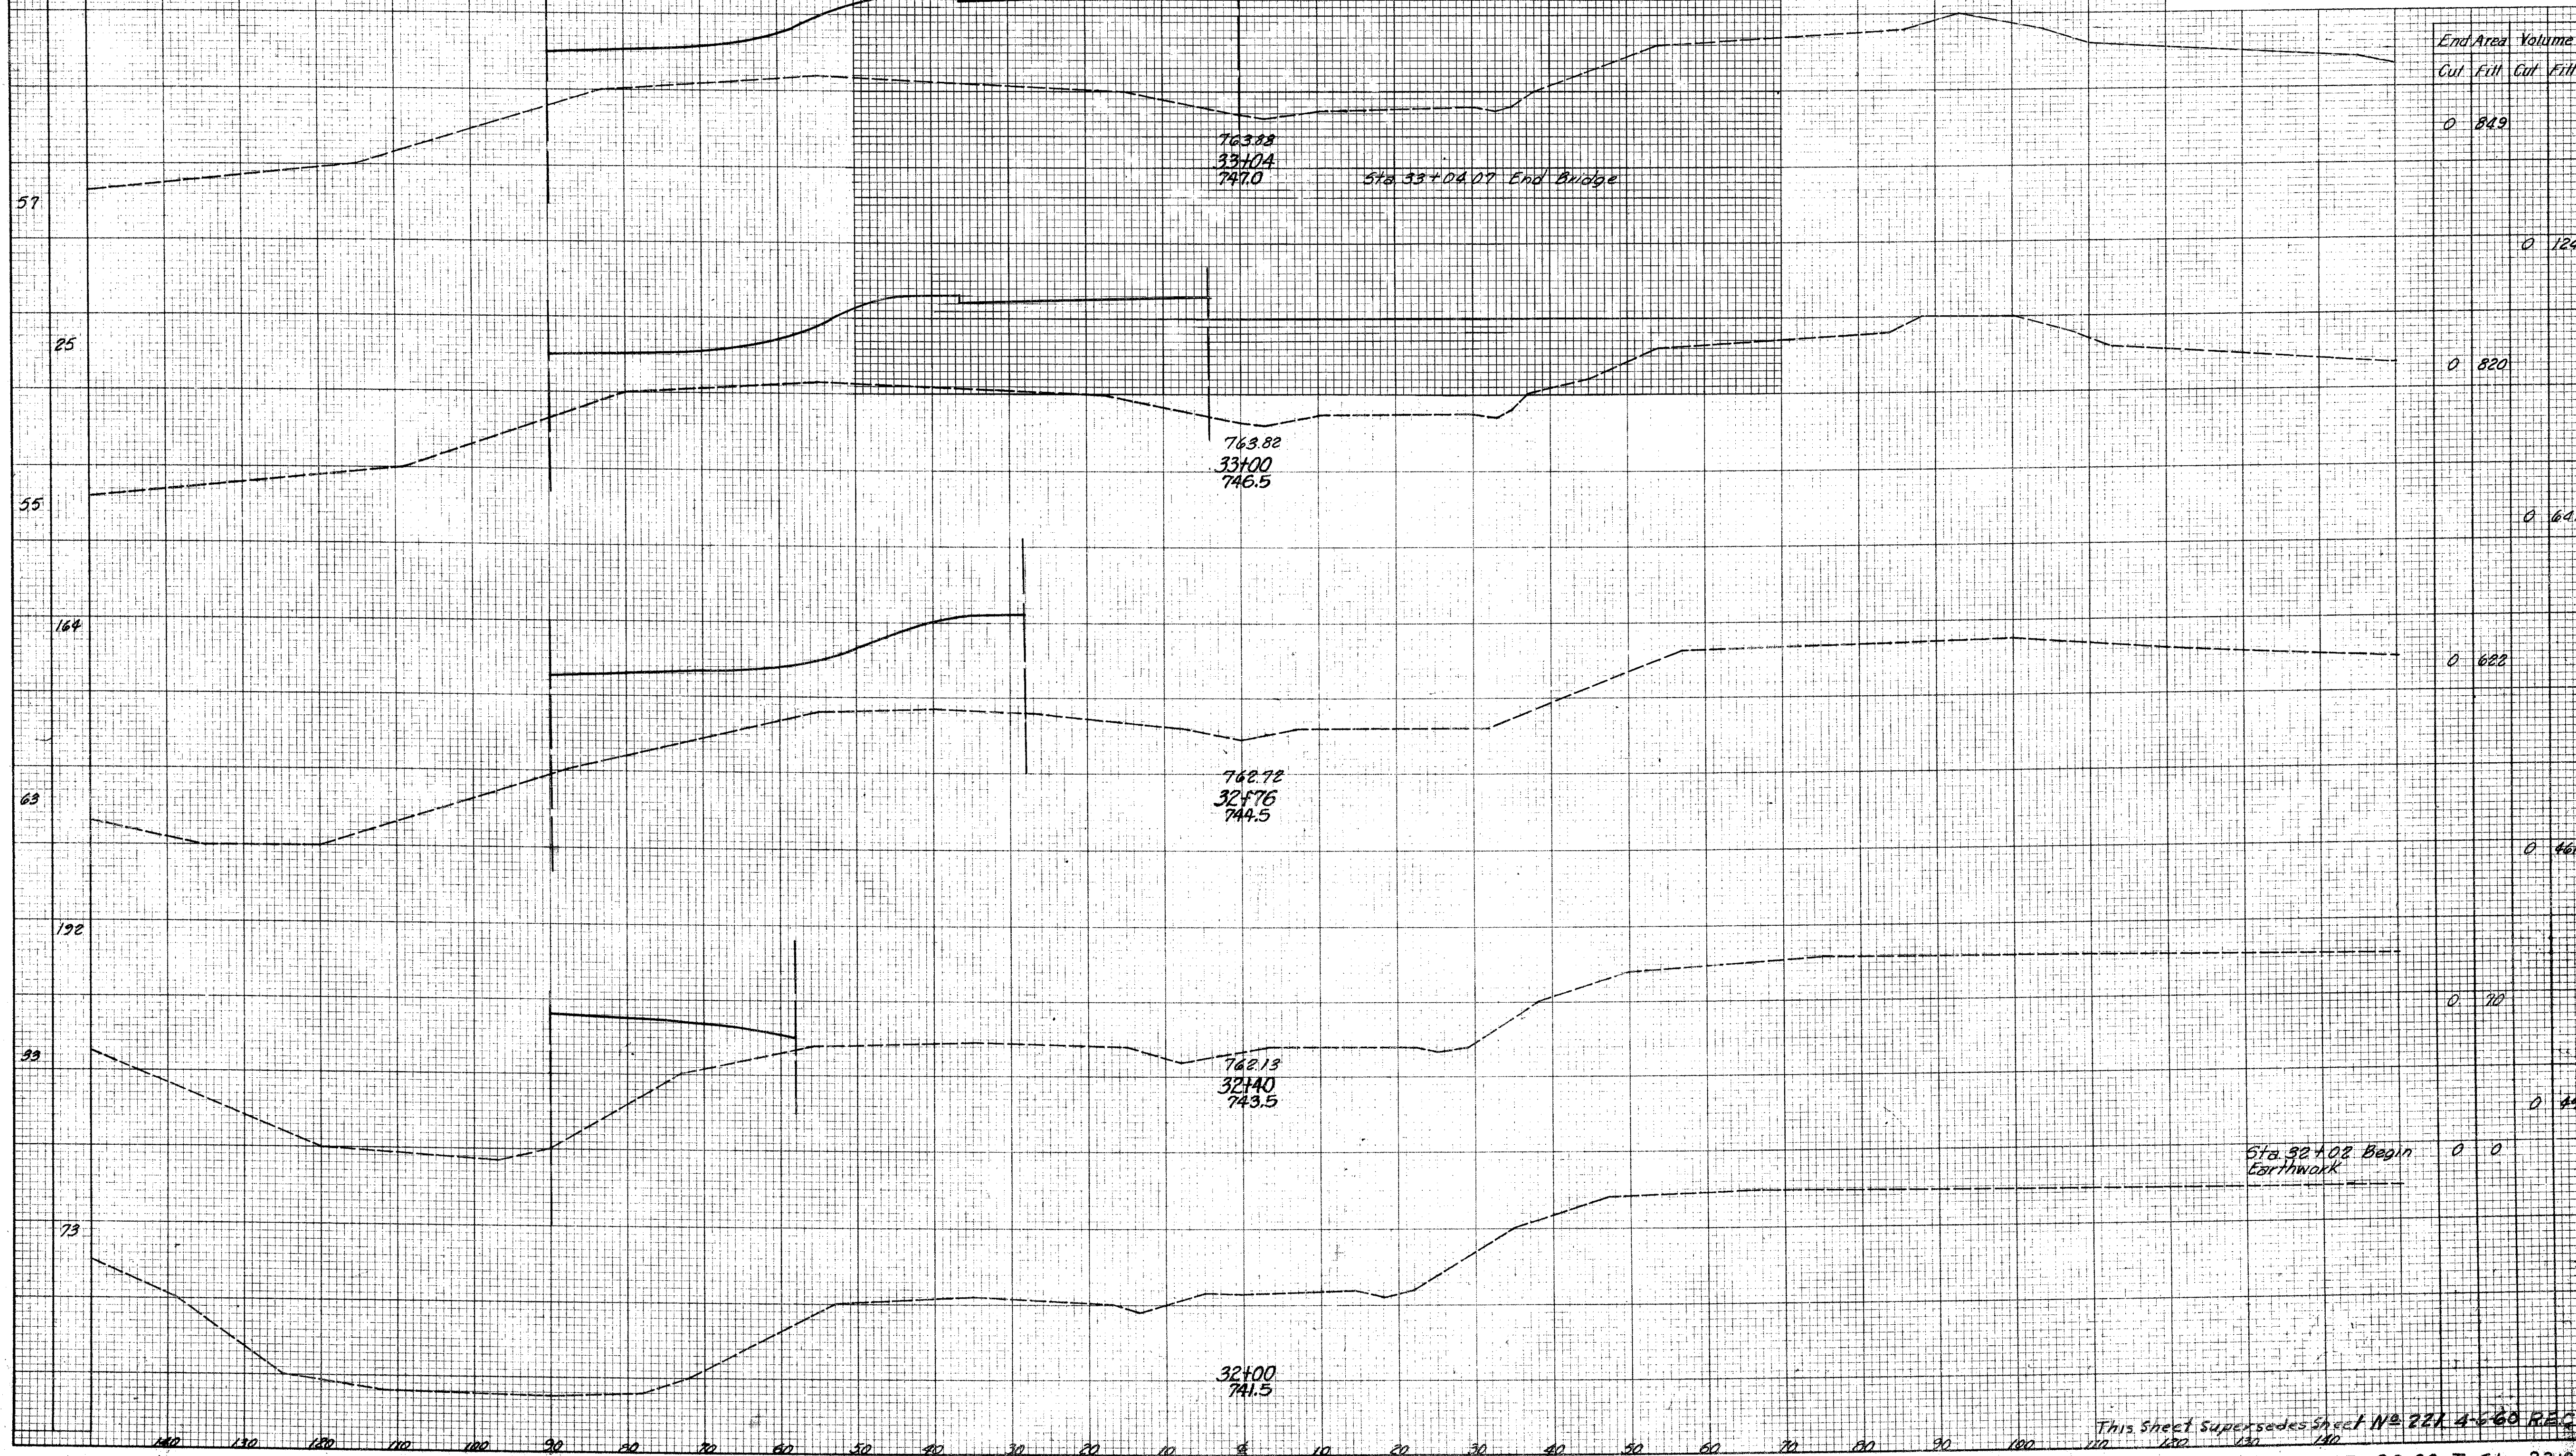

This sheet supersedes sheet No. 221 4-6-68 REC.
S.R. NO. 91 RELOCATION STA. 32+00 To Sta. 33+04