


Seeding  
End Width Sq.Yd.

FED. RD. DIVISION	STATE	PROJECT
2	OHIO	I-1103 (19)

2225  
372

LAKE COUNTY  
LAK-1-2.16

End Area Volume  
Cut Fill Cut Fill

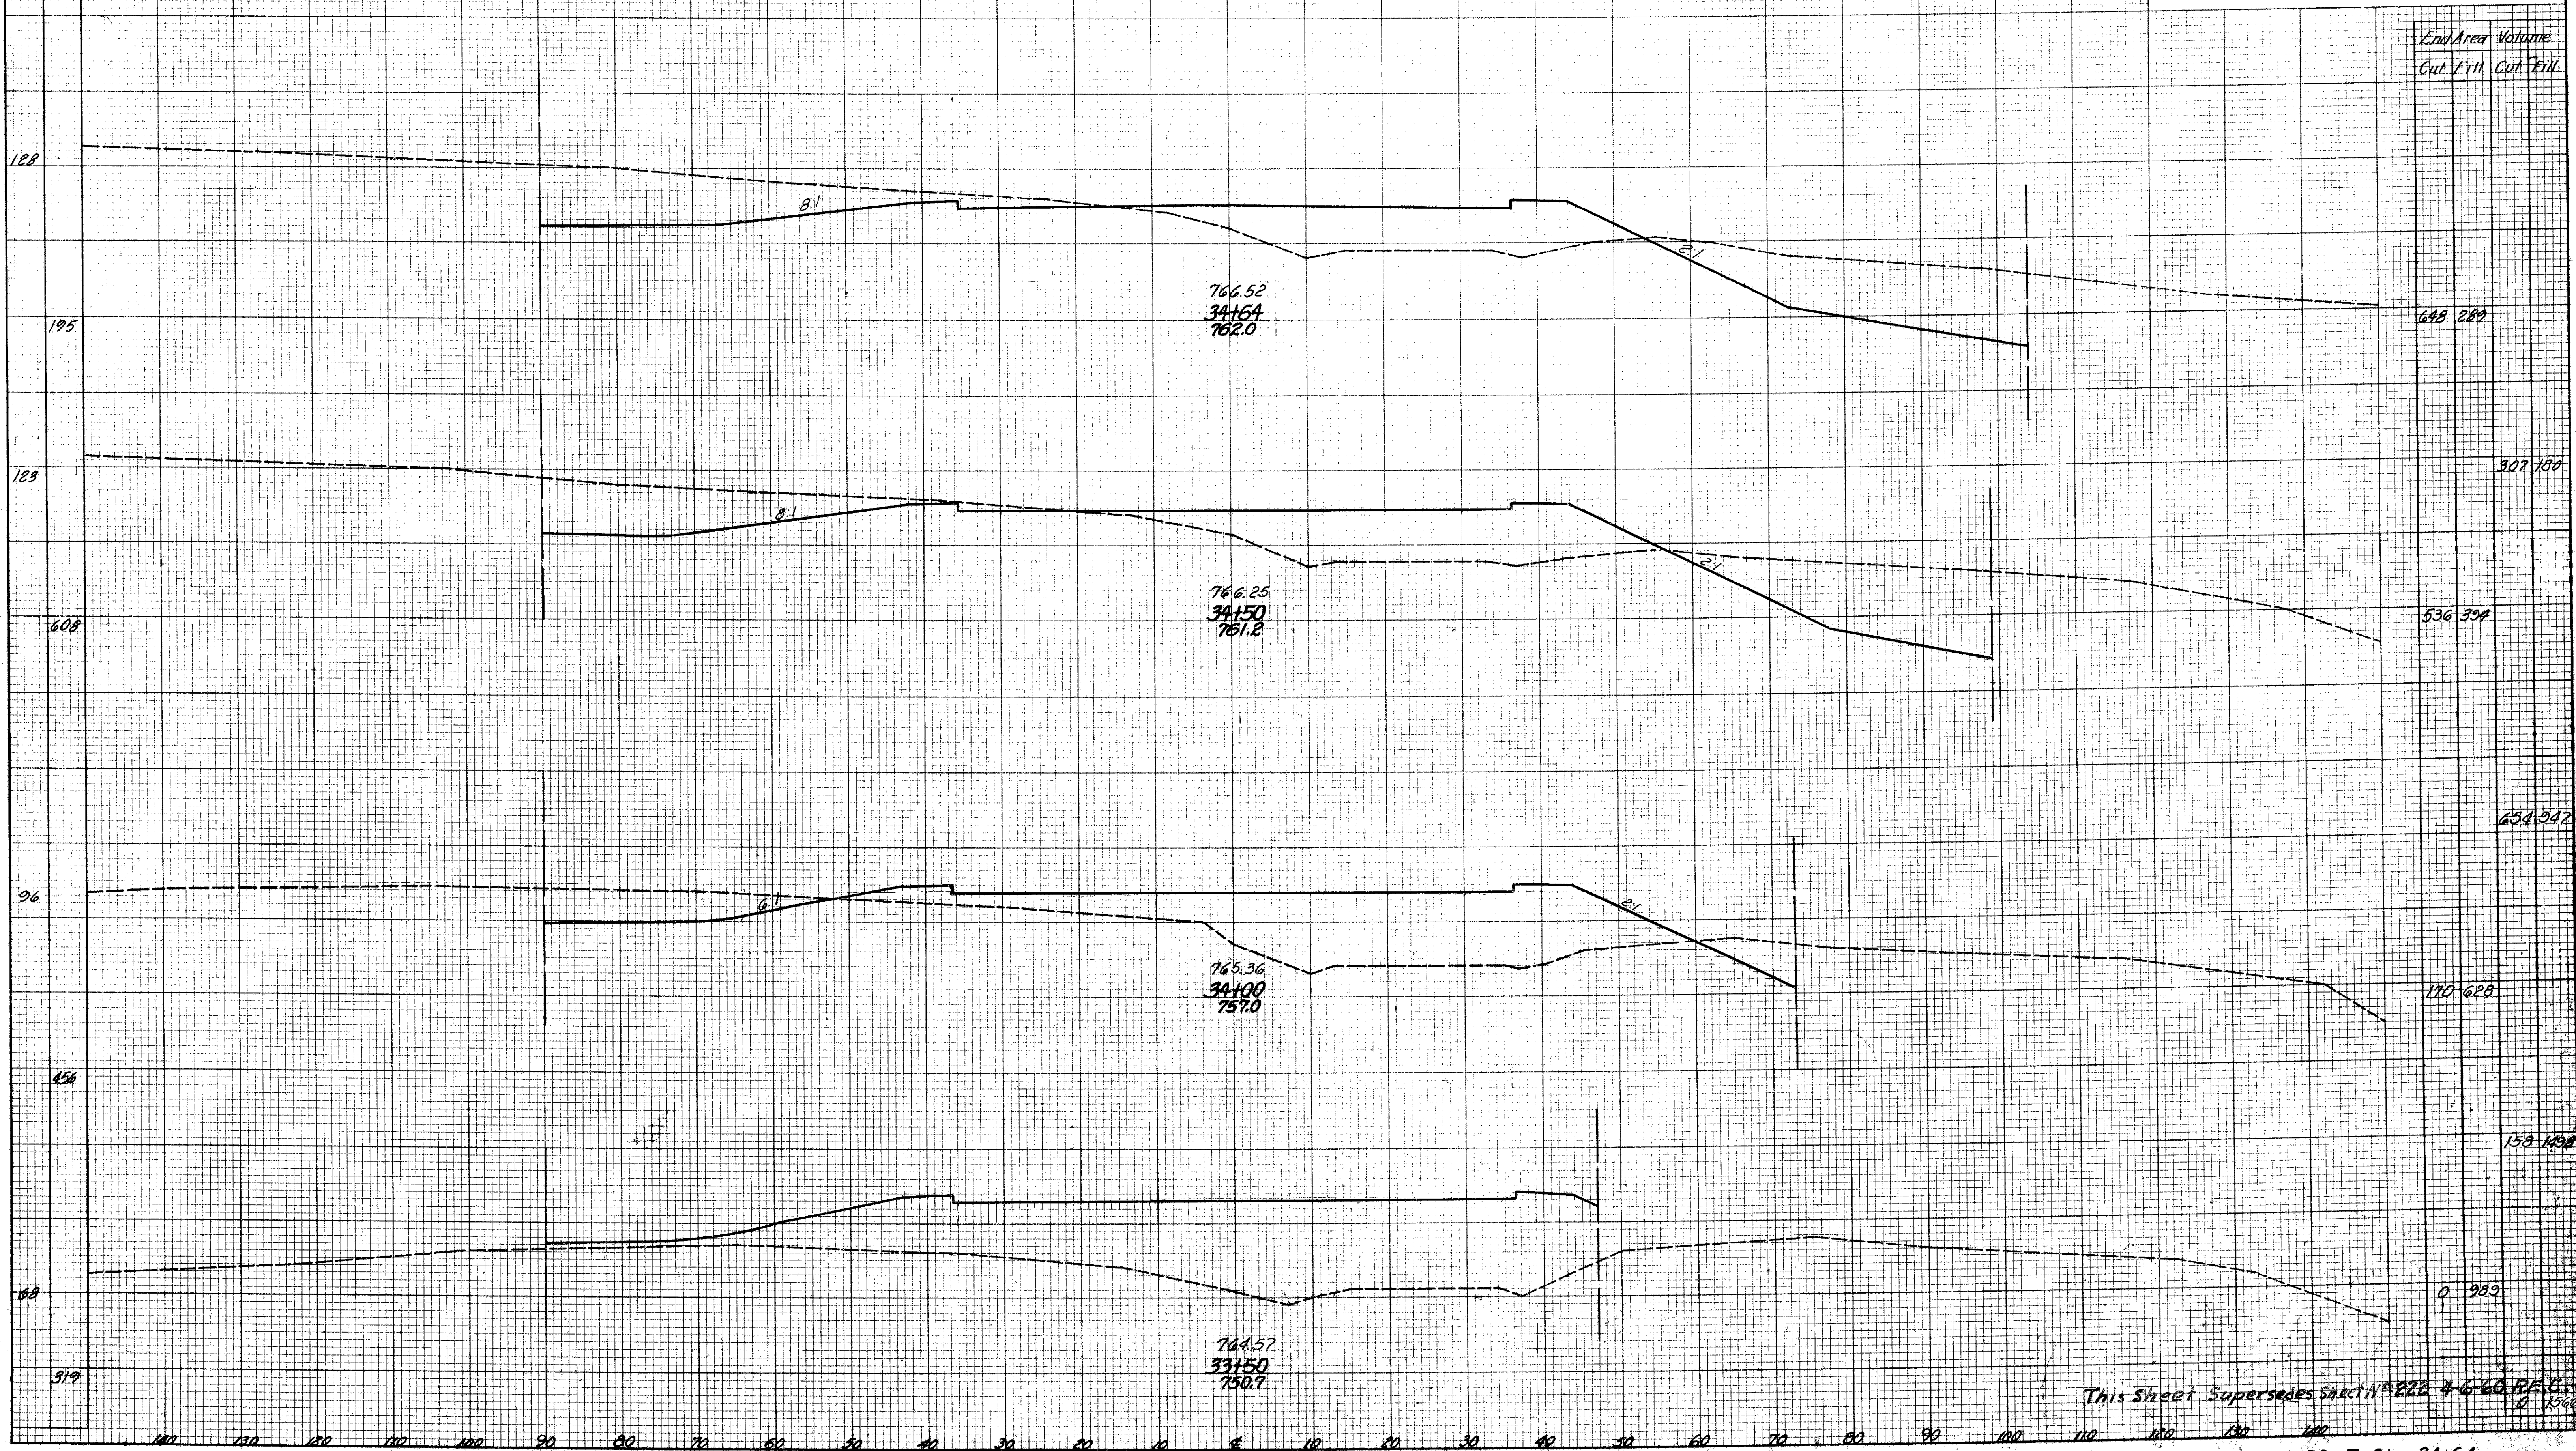

This Sheet Supersedes Sheet No. 222 3-6-60 P.F.C.  
0 1500

S.R. No. 91 RELOCATION Sta. 33+50 To Sta. 34+64