


Seeding
E.M.
W.H. S.Y.H.

FED. RD. DIVISION	STATE	PROJECT
2	OHIO	I-1103 (19)

242-S
312

LAKE COUNTY
LAK-1-2.16

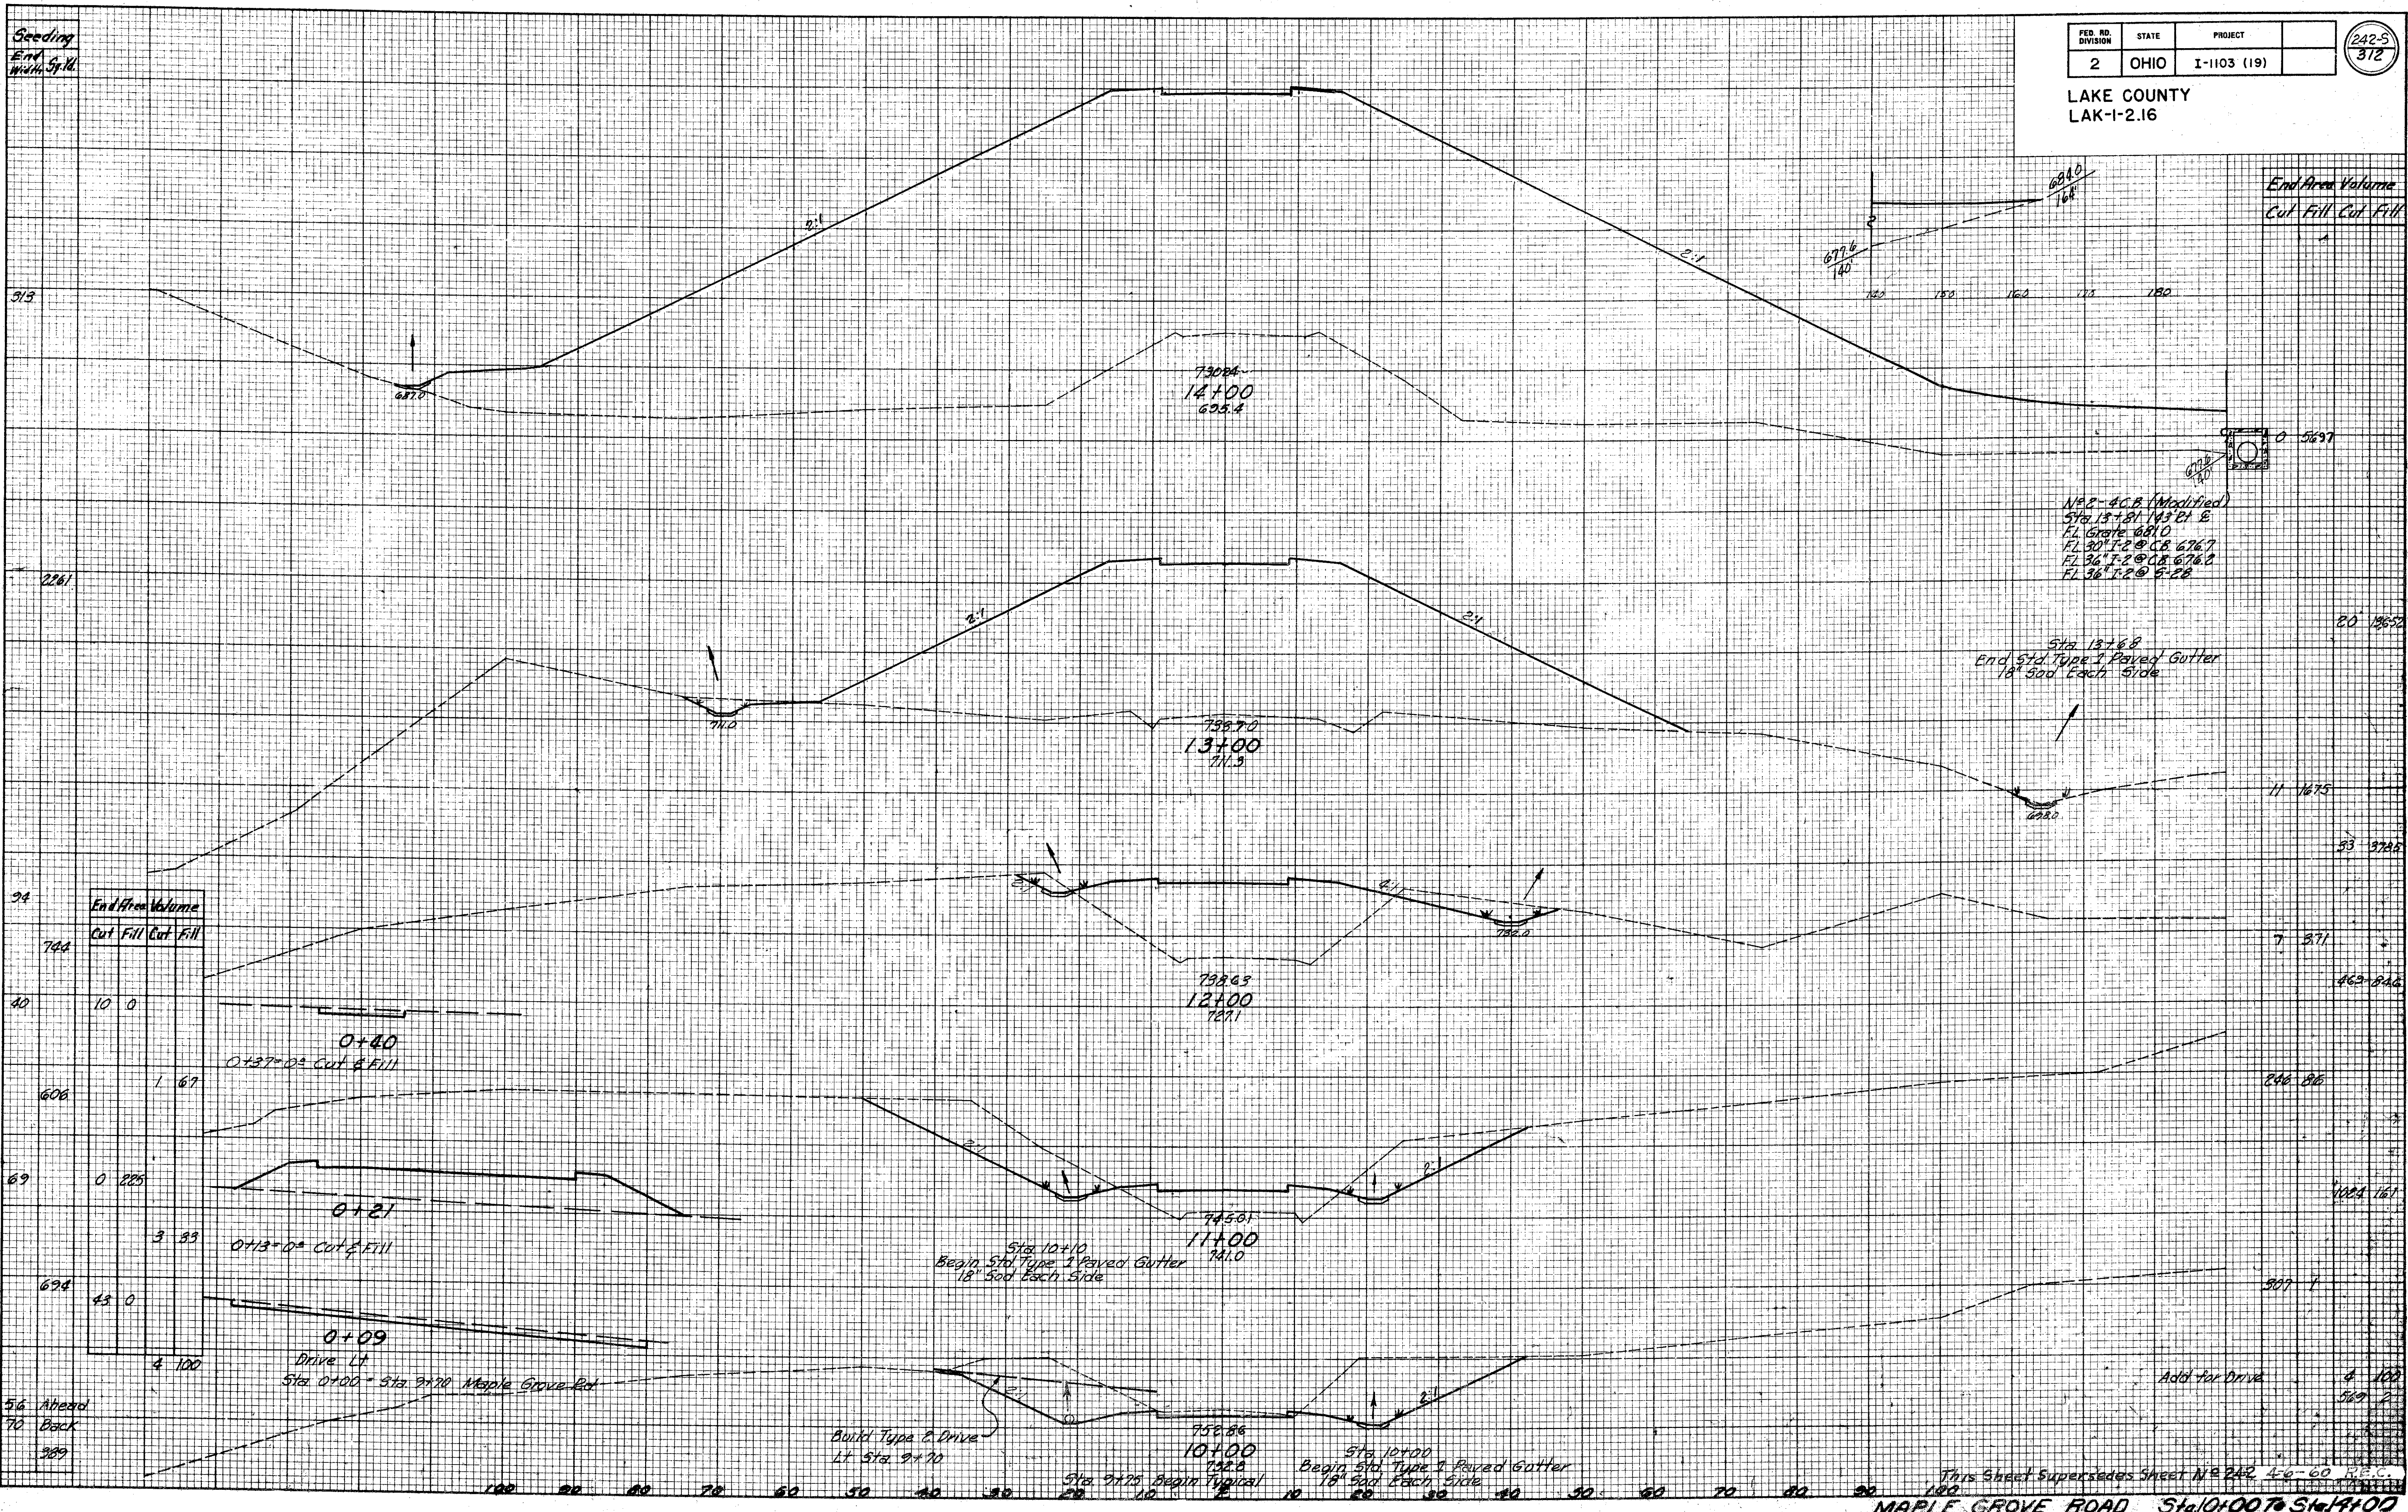

End Area Volume	
Cut	Fill

End Area Volume	
Cut	Fill

70.4		
40	10	0
60.6	1	67
69	0	225
69.4	45	0
	4	100

56 Ahead
70 Back
389

Nº 2 - 4 C.B. (Modified)
Sta. 13+81.143 21' E
FL Grate 681.0
FL 30" T-2 @ C.B. 676.7
FL 36" T-2 @ C.B. 676.0
FL 36" T-2 @ 5-22

Sta 12+68
End Sta. Type 1 Paved Gutter
18" 500' Each Side

Sta 10+10
Begin Sta. Type 1 Paved Gutter
18" 500' Each Side

Sta 11+00
Begin Sta. Type 1 Paved Gutter
18" 500' Each Side

This Sheet Supersedes Sheet Nº 242, 4-6-60, R.E.C.
MAPLE GROVE ROAD Sta 10+00 to Sta 11+00