


Seeding
End
Minimum Sq. Yd.

FED. RD. DIVISION	STATE	PROJECT
2	OHIO	I-1103 (19)

244-S
312

LAKE COUNTY
LAK-1-2.16

End Area Volume
Cut Fill Cut Fill

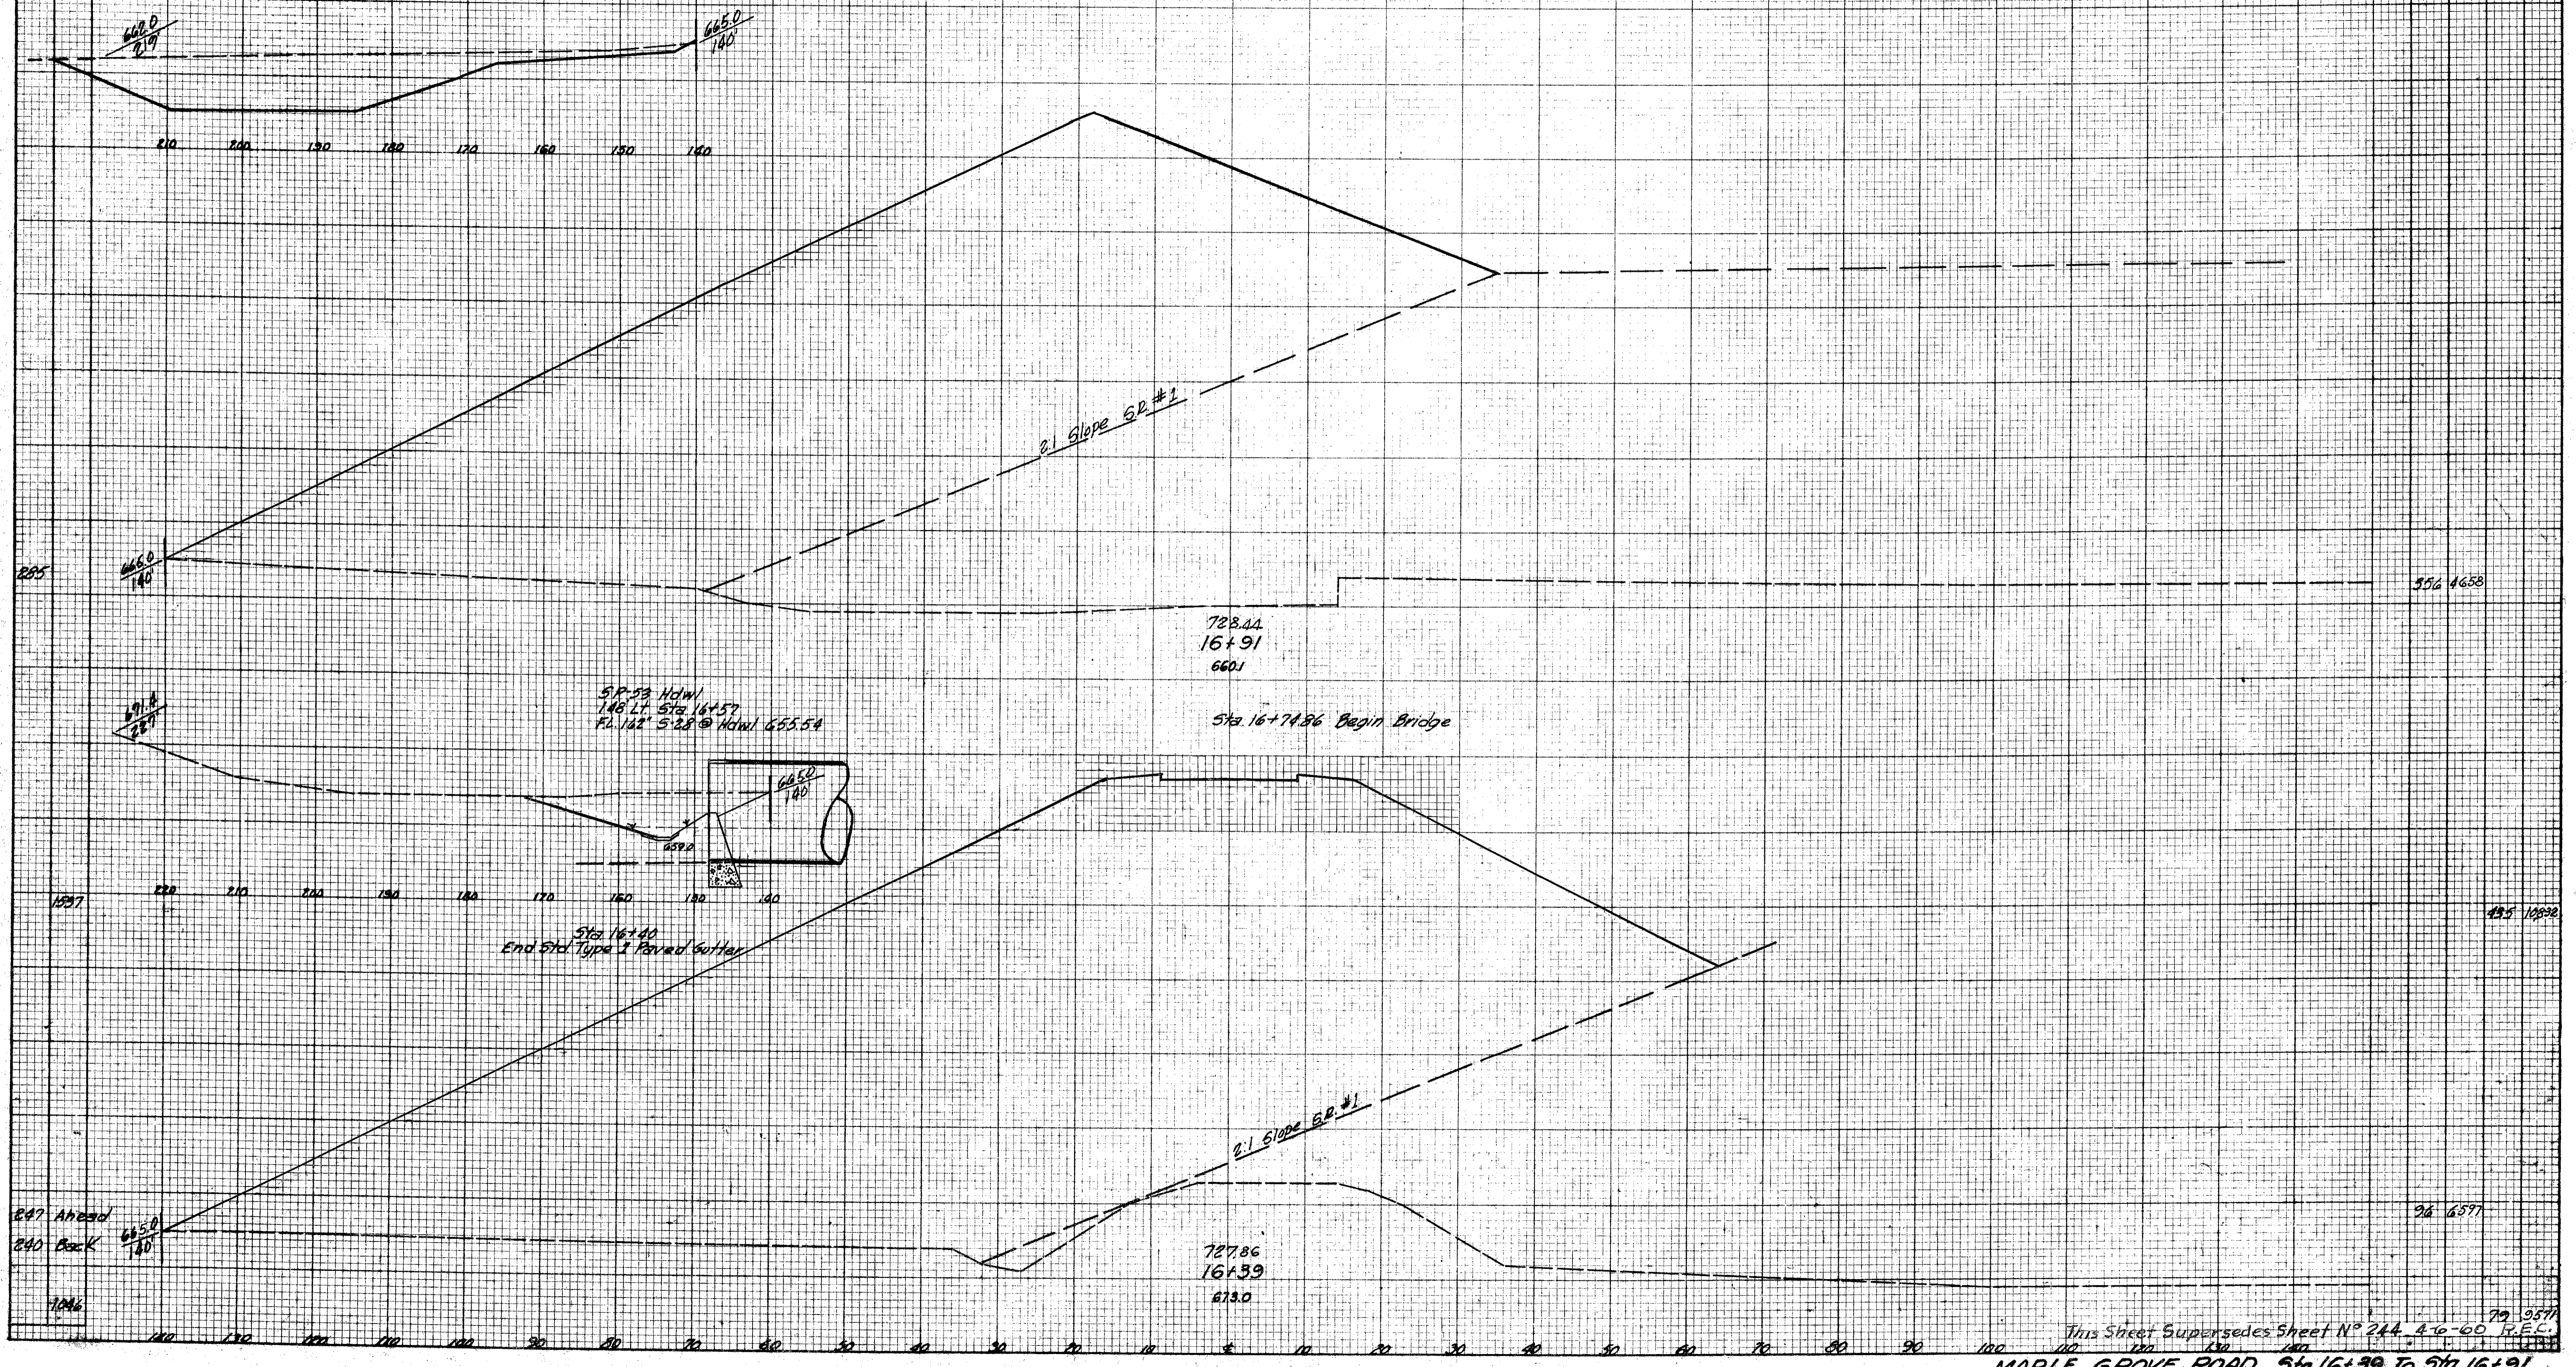

This Sheet Supersedes Sheet No. 244-S-60 R.E.C.
MAPLE GROVE ROAD Sta 16+39 To Sta. 16+91