


Seeding	
End Width	Sq. Yds.
0	887

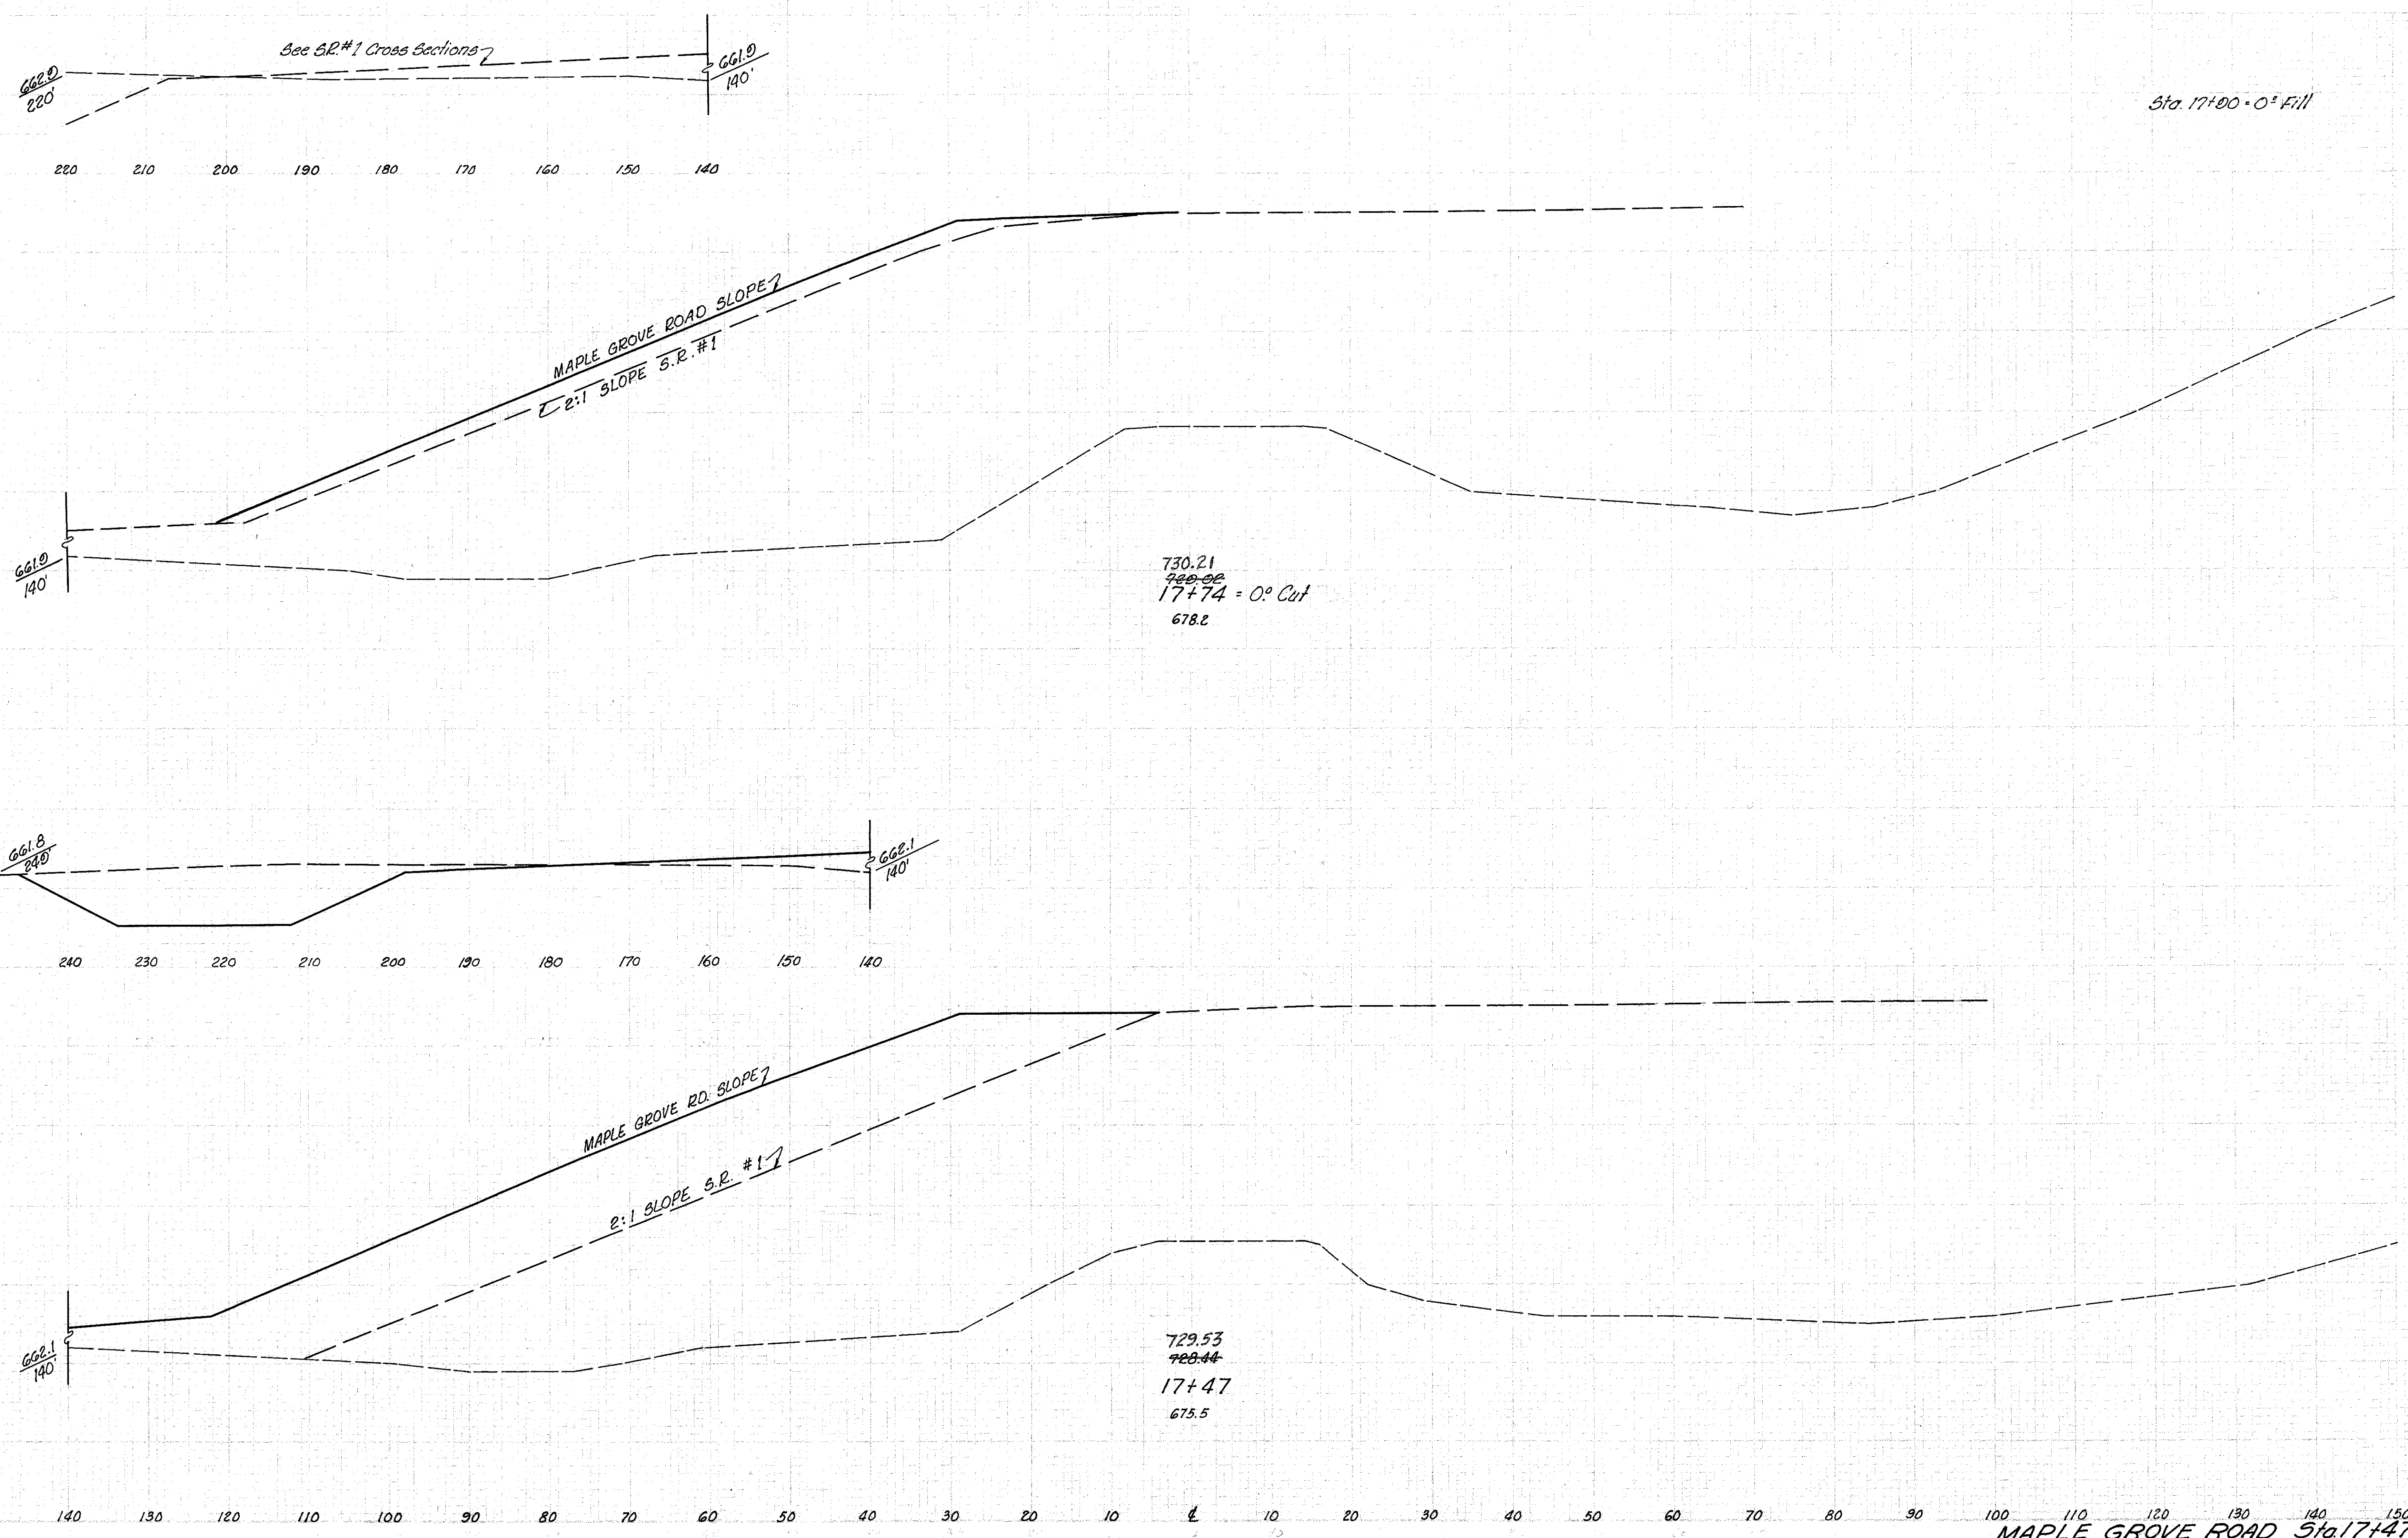

End Area		Volume	
Cut	Fill	Cut	Fill
		0	60
0	203		
		136	656
272	1190		
		6065	651