FED. RD. DIVISION	STATE	PROJECT	
2	OHIO	I-1103(19)	

303
312

LAKE COUNTY
LAK-1-2.16
LIMITED ACCESS

R/W
7 of 17

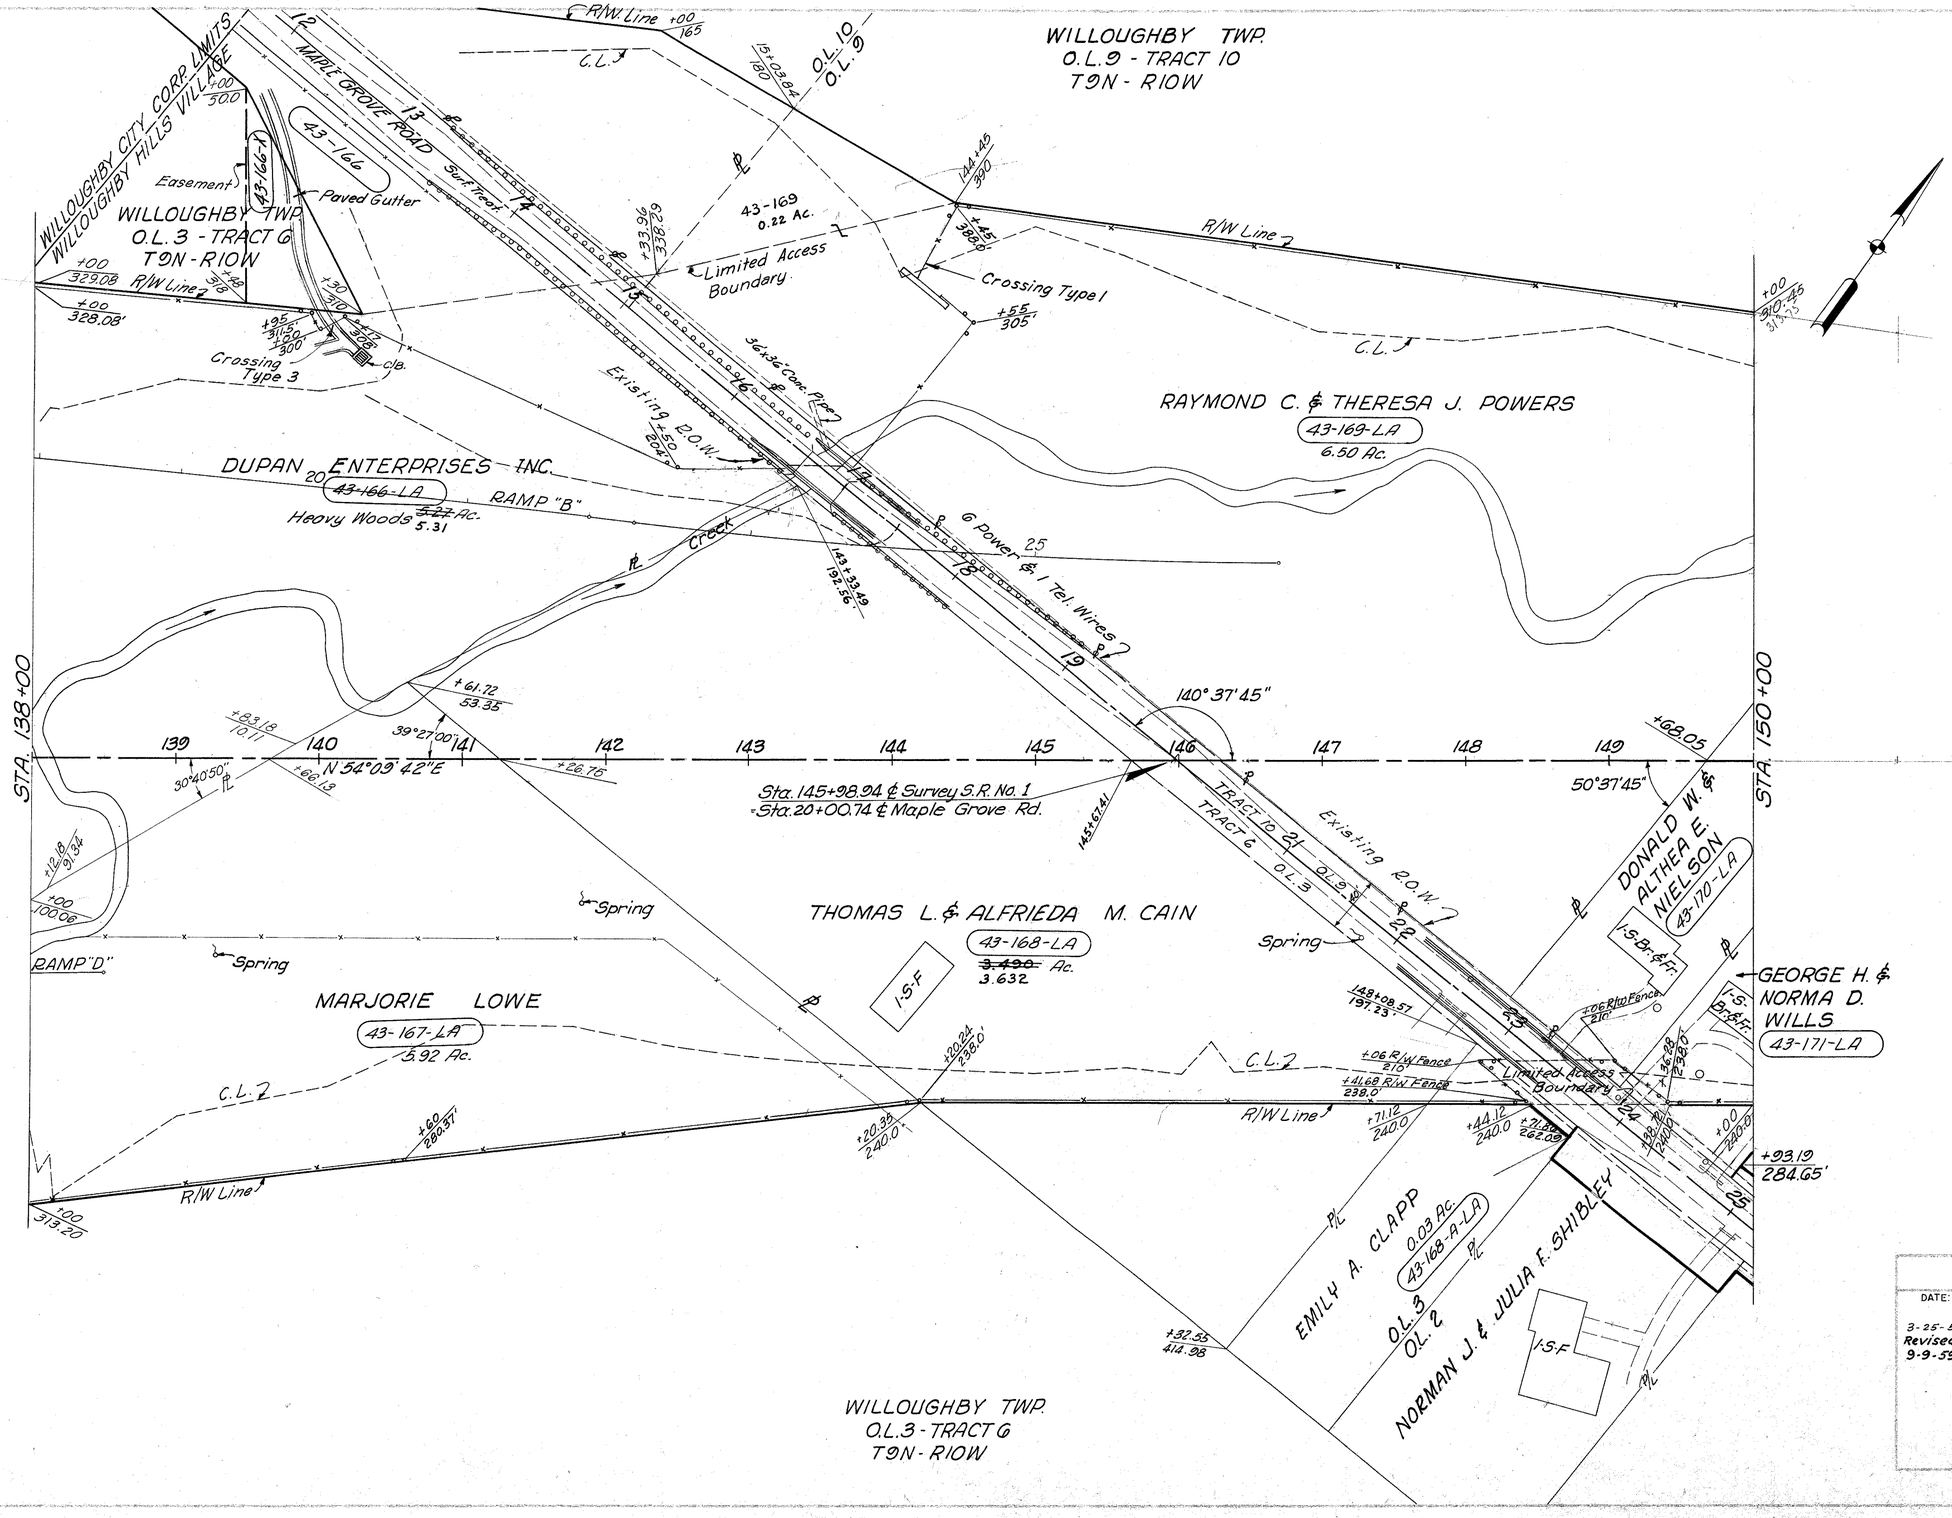

SRUCTURES TO BE REMOVED
Parcel No. 43-168-LA
1-1 Story Frame Res.

Parcel No. 43-170-LA
1-1 Story Brick & Frame Res.

Parcel No. 43-171-LA
1-1 Story Brick & Frame Res.

2596 L.F. Type "D" Fence

MICHAEL BAKER JR., CONSULTING ENGINEERS
ROCHESTER, PENNSYLVANIA

DATE: 3-25-59 Revised 9-9-59

STATE OF OHIO
DEPARTMENT OF HIGHWAYS
RIGHT OF WAY PLANS
STATE HIGHWAY NO. 1
C-43
STA. 138+00 TO STA. 150+00

Designed	Drawn	Traced	Checked	Reviewed Date	Revised
J.P.	A.L.H.	K.G.	B.P.		