
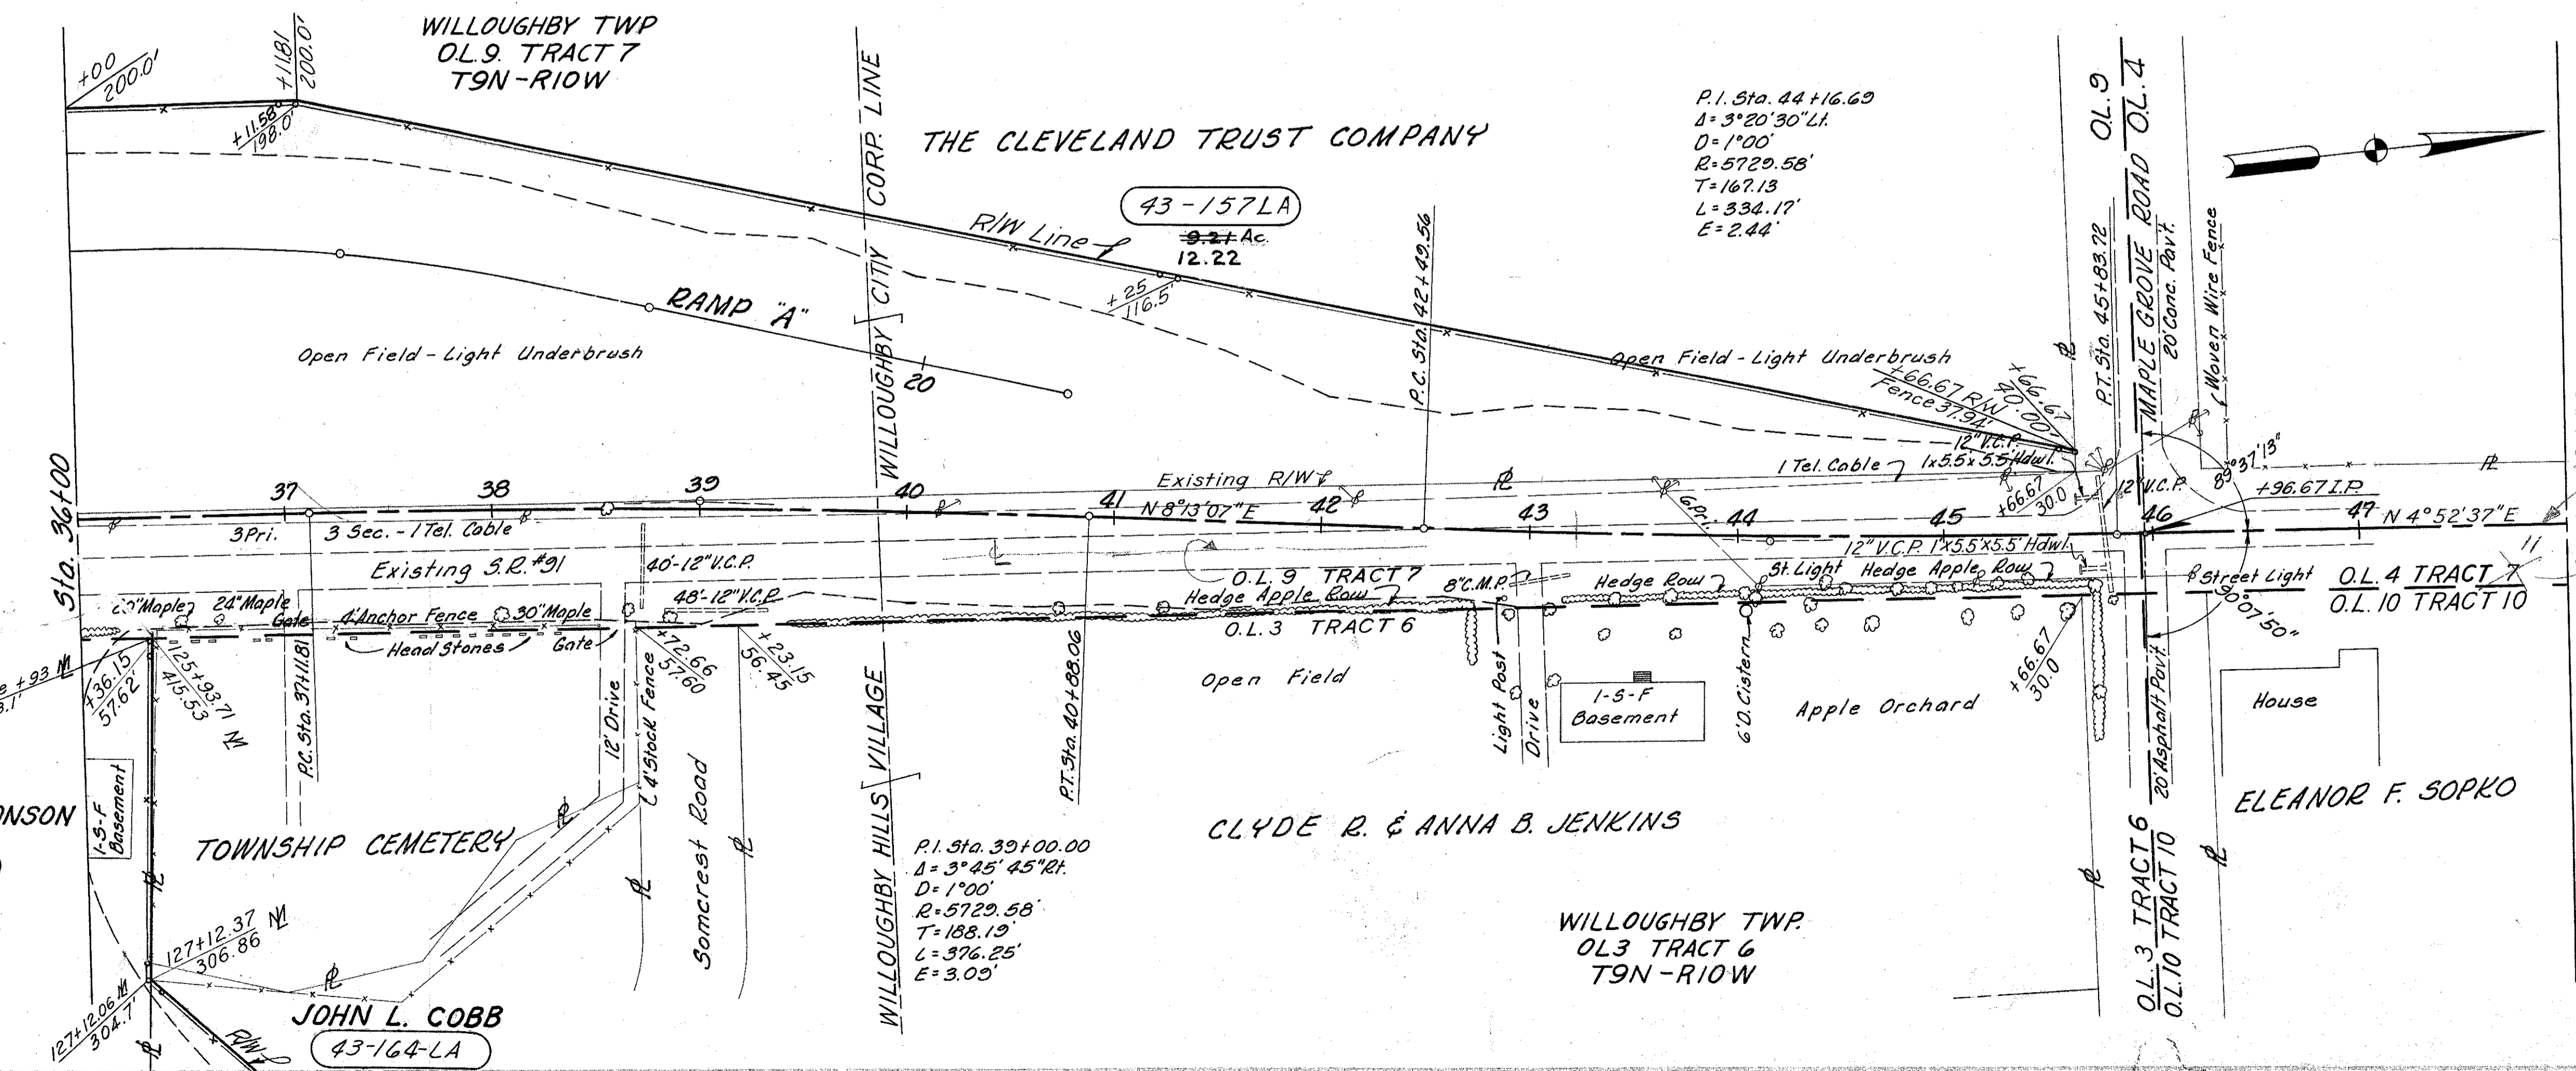


LAKE COUNTY
LAK-1-2.16
LIMITED ACCESS

R/W
15 of 17

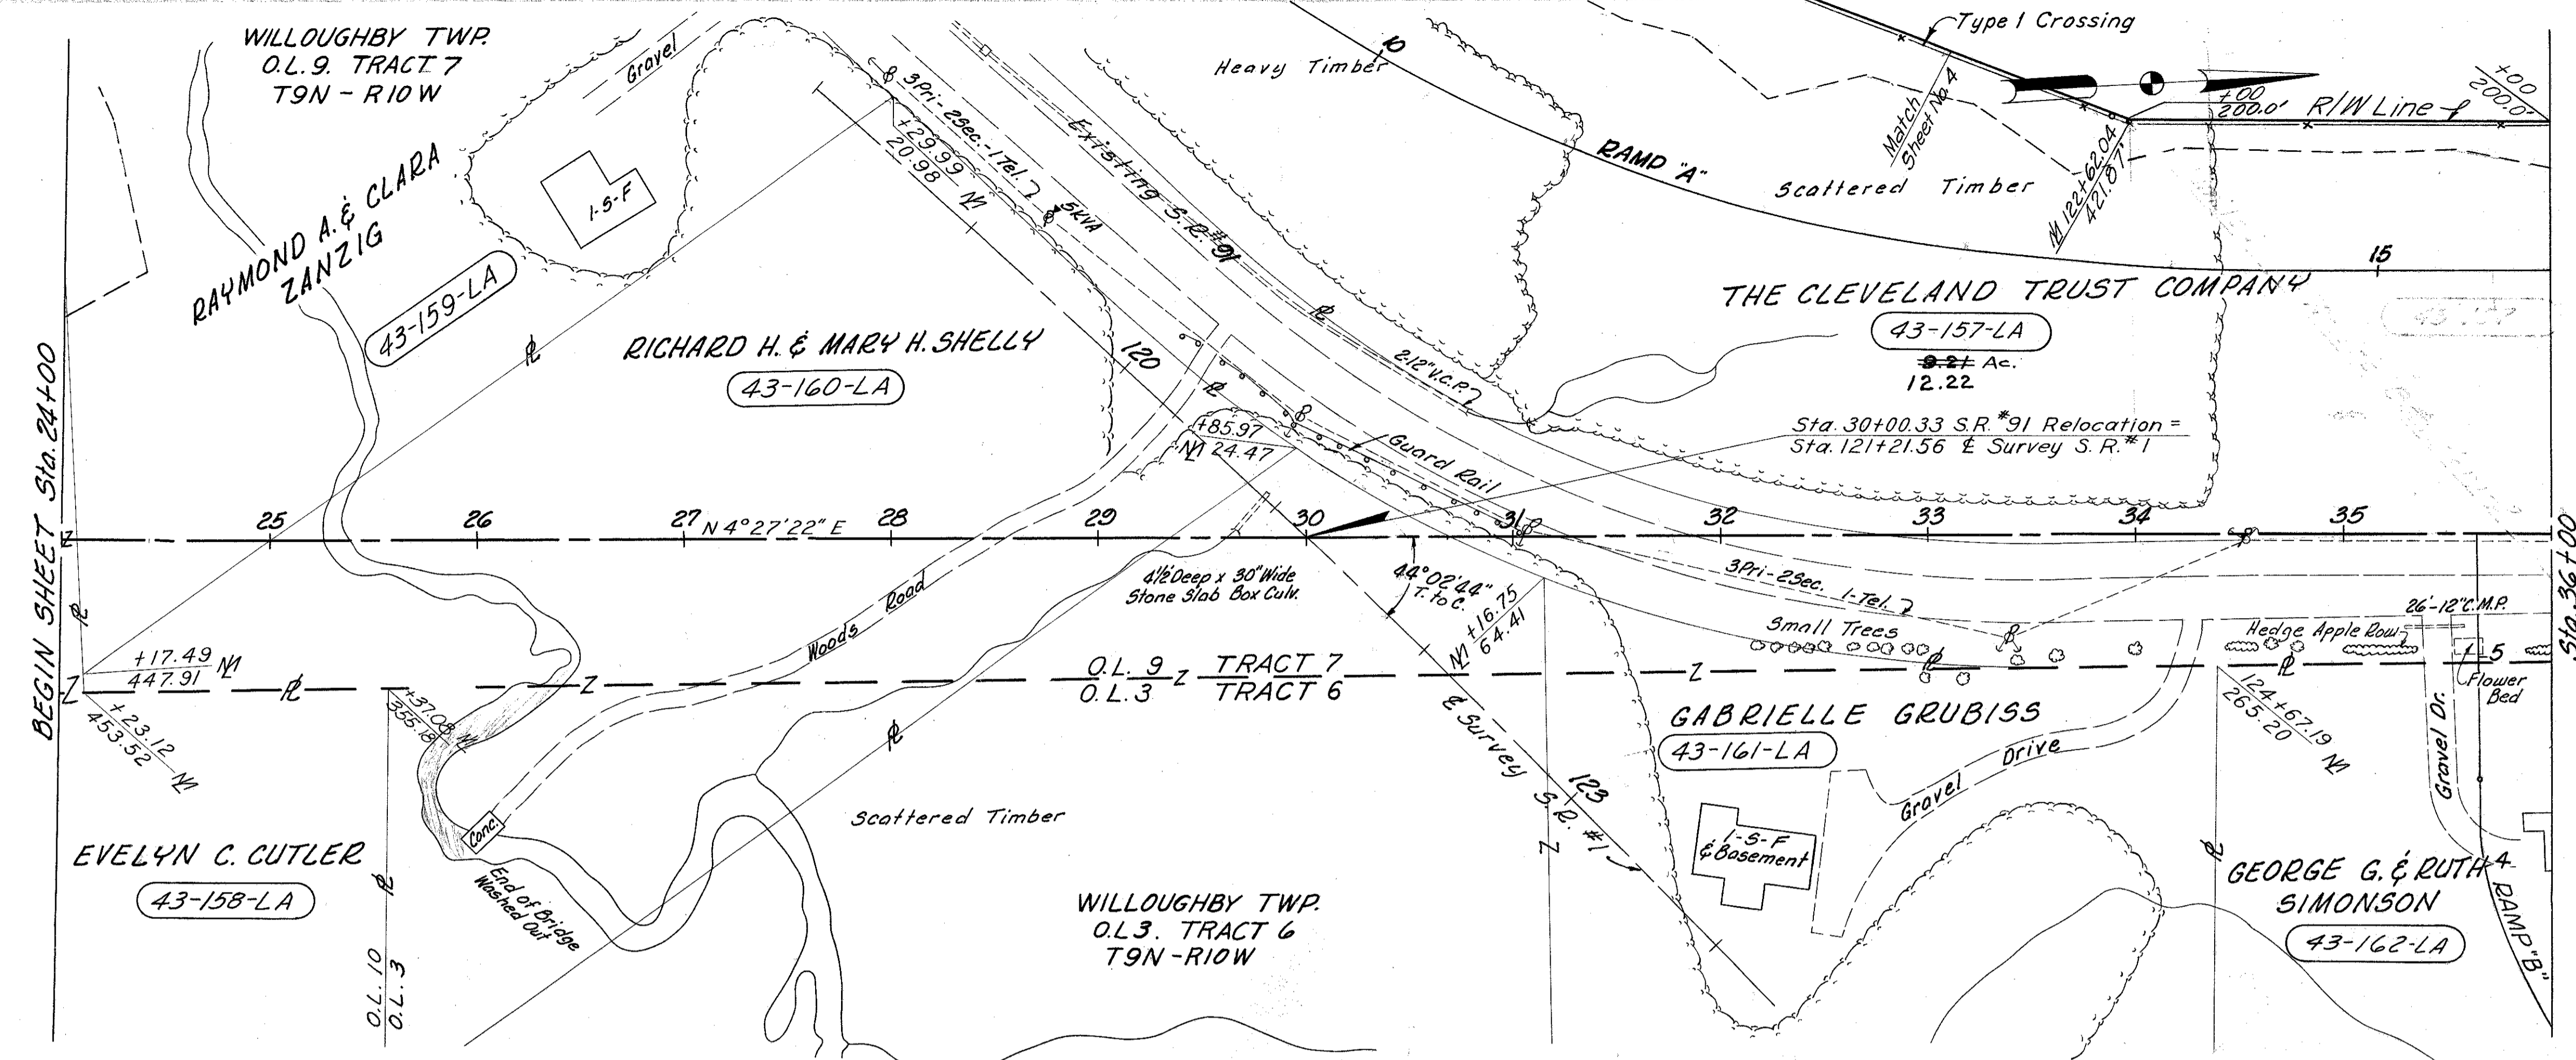

1283 L.F. Type "D" Fence

MICHAEL BAKER JR., CONSULTING ENGINEERS
ROCHESTER, PENNSYLVANIA

DATE:
3-25-59
10-26-59

STATE OF OHIO
DEPARTMENT OF HIGHWAYS
RIGHT OF WAY PLANS
STATE HIGHWAY NO. 1
C-43

S.R. NO. 91 STA. 24+00 TO STA. 48+00

Designed	Drawn	Traced	Checked	Reviewed Date	Revised
J.R.	A.L.H.	K.A.	B.P.		

GEORGE G. & RUTH SIMONSON
43-162-LA

TOWNSHIP CEMETERY
JOHN L. COBB
43-164-LA

CLYDE R. & ANNA B. JENKINS
WILLOUGHBY TWP.
OL.3 TRACT 6
T9N-R10W

ELEANOR F. SOPKO