
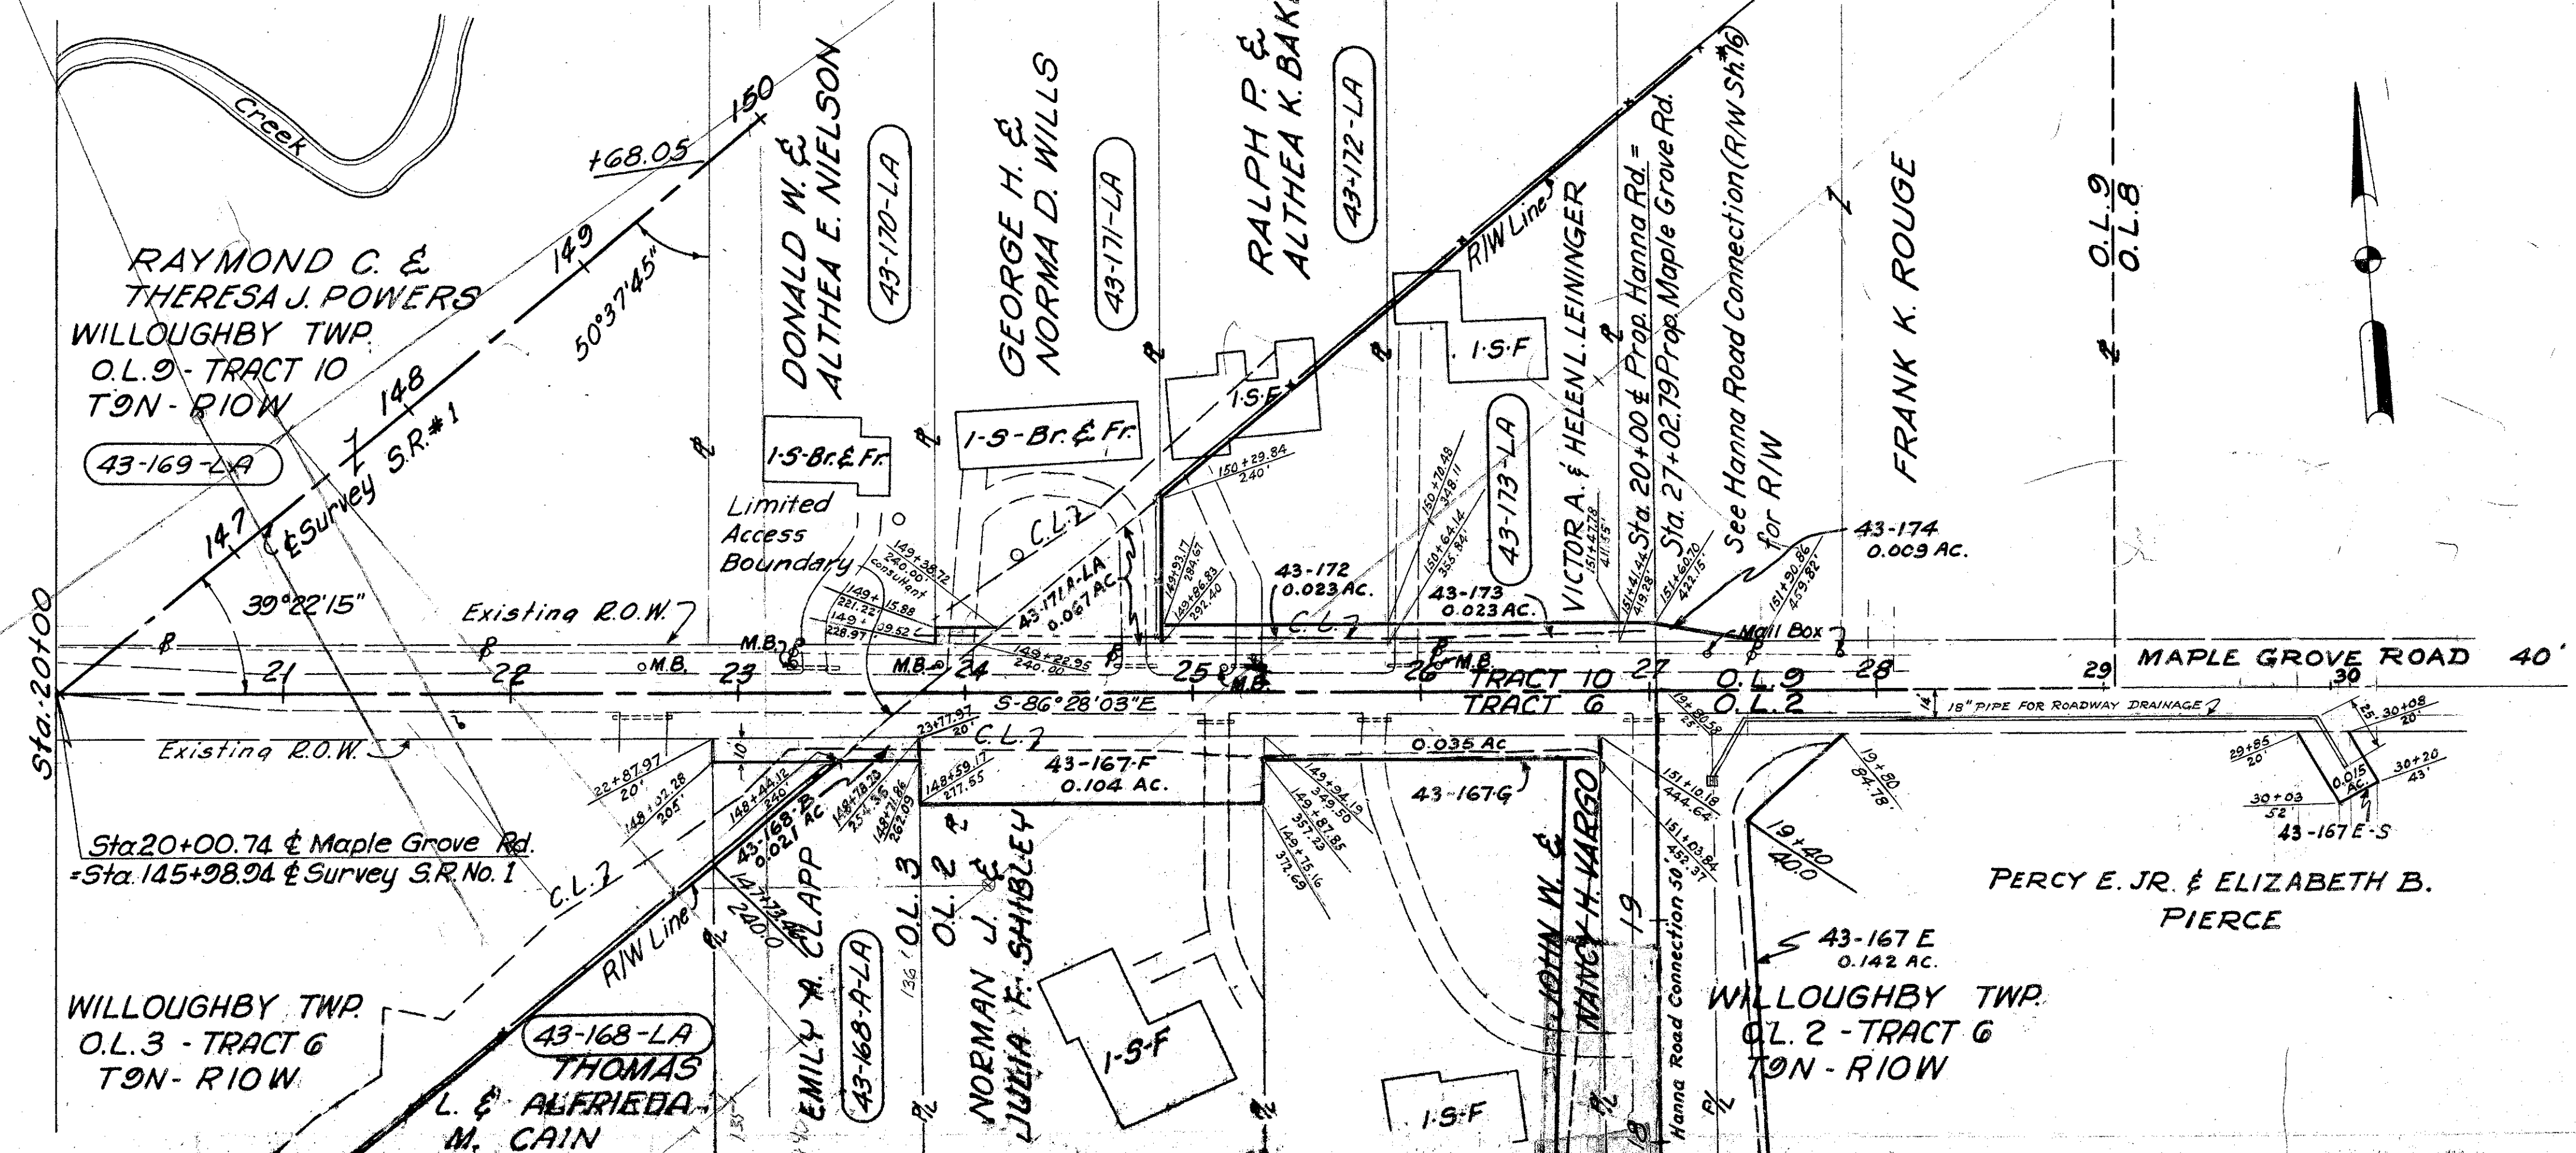


FED. RD. DIVISION	STATE	PROJECT
2	OHIO	1-1103 (19)

313
312

LAKE COUNTY
LAK-1-2.16
LIMITED ACCESS

R/W
17 of 17

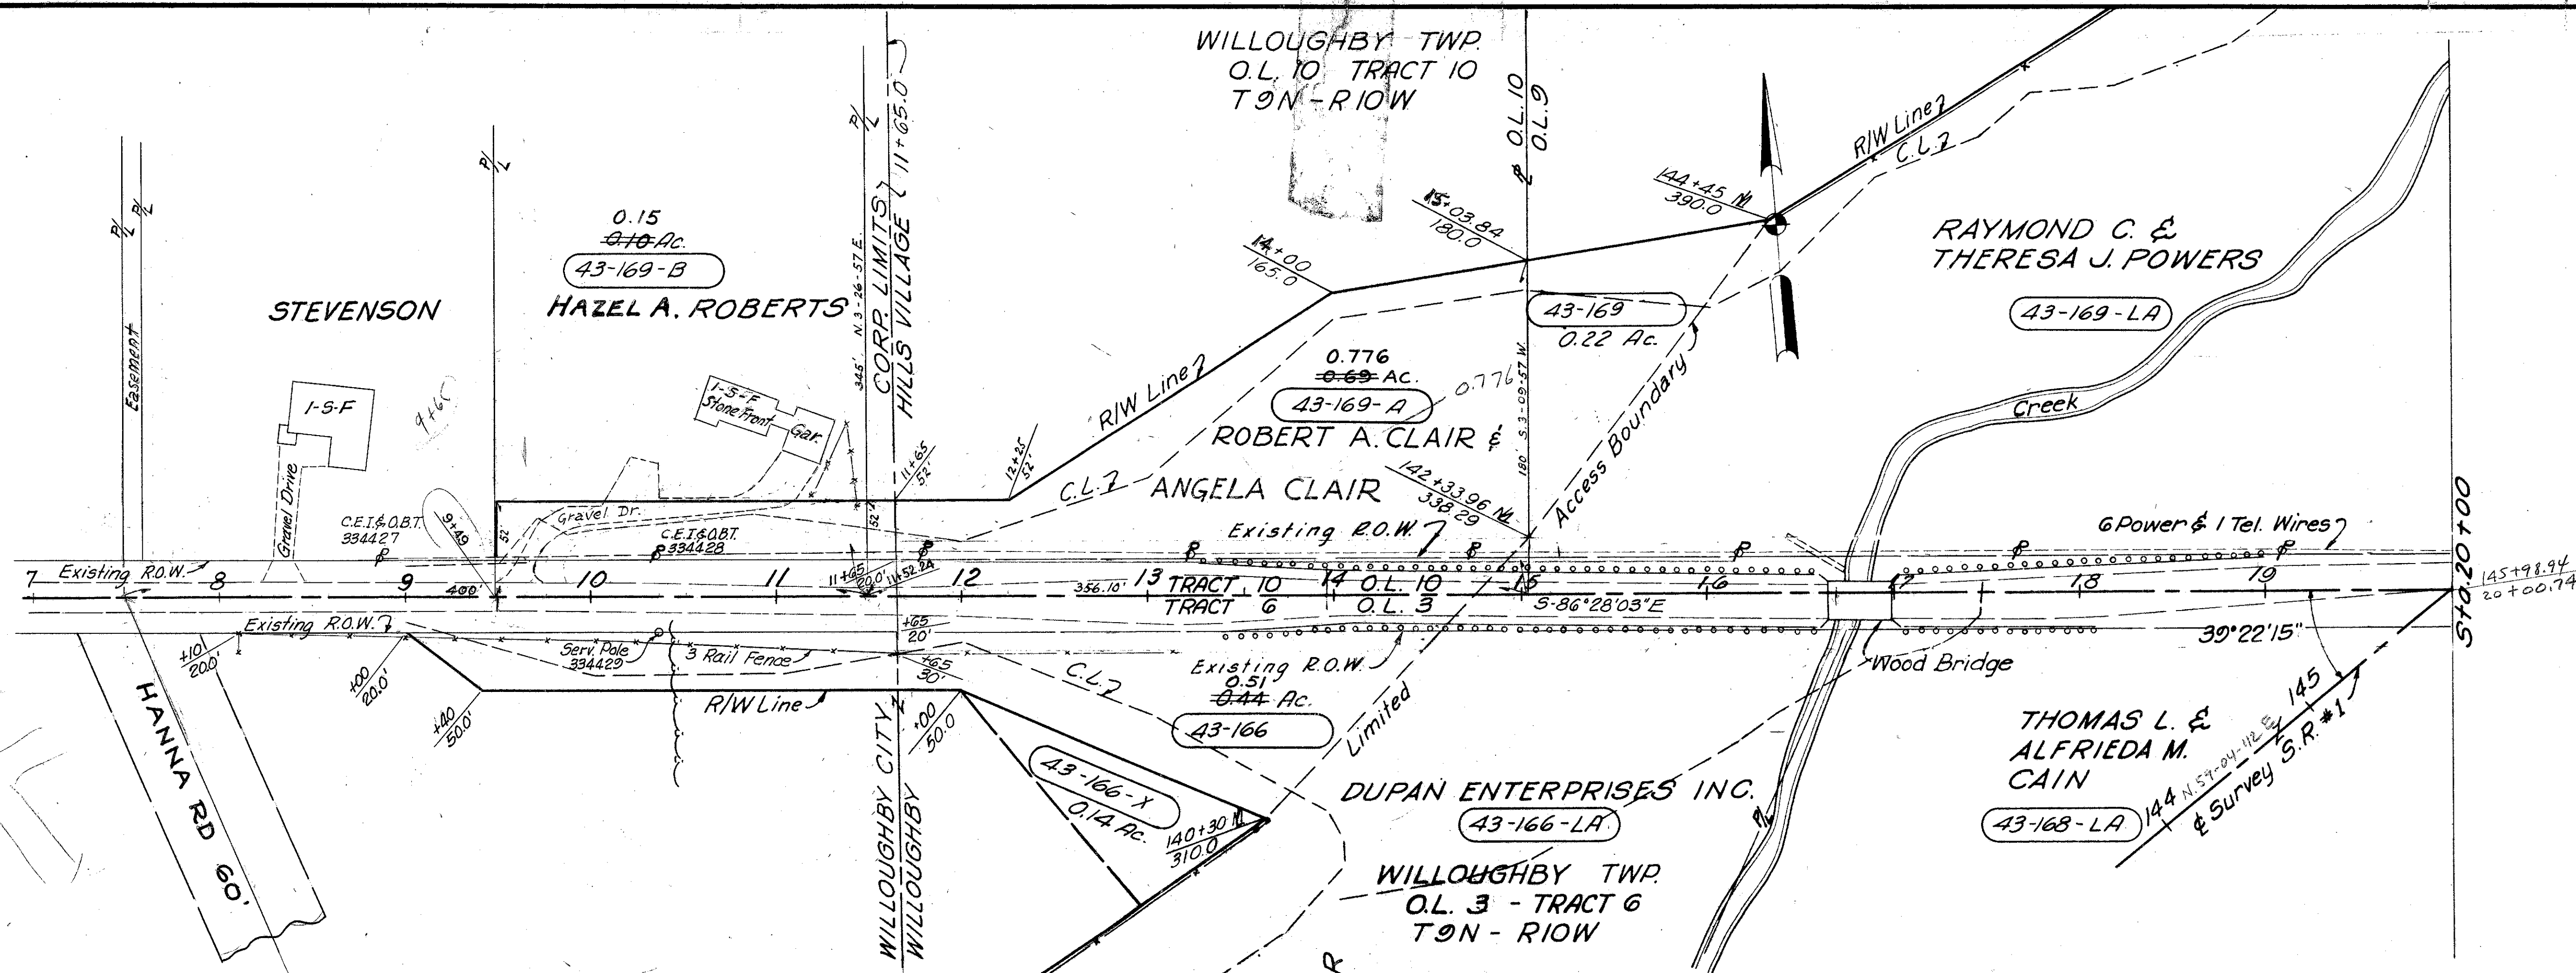

MICHAEL BAKER JR., CONSULTING ENGINEERS ROCHESTER, PENNSYLVANIA					
DATE: 3-25-59 Revised: 6-5-59 9-9-59 10-26-59 4-6-60 5-2-60					
STATE OF OHIO DEPARTMENT OF HIGHWAYS RIGHT OF WAY PLANS STATE HIGHWAY NO. 1 C-43 MAPLE GROVE ROAD					
Designed	Drawn	Traced	Checked	Reviewed Date	Revised
W.T.P.	A.L.H.	K.L.G.	J.P.		

✓ B.A.P. Dec. 2/59