


SEEDING
END WERTH YRS.

2 OHIO RCT-1103 (28)

67
211

LAKE COUNTY
LAK-1-20.03

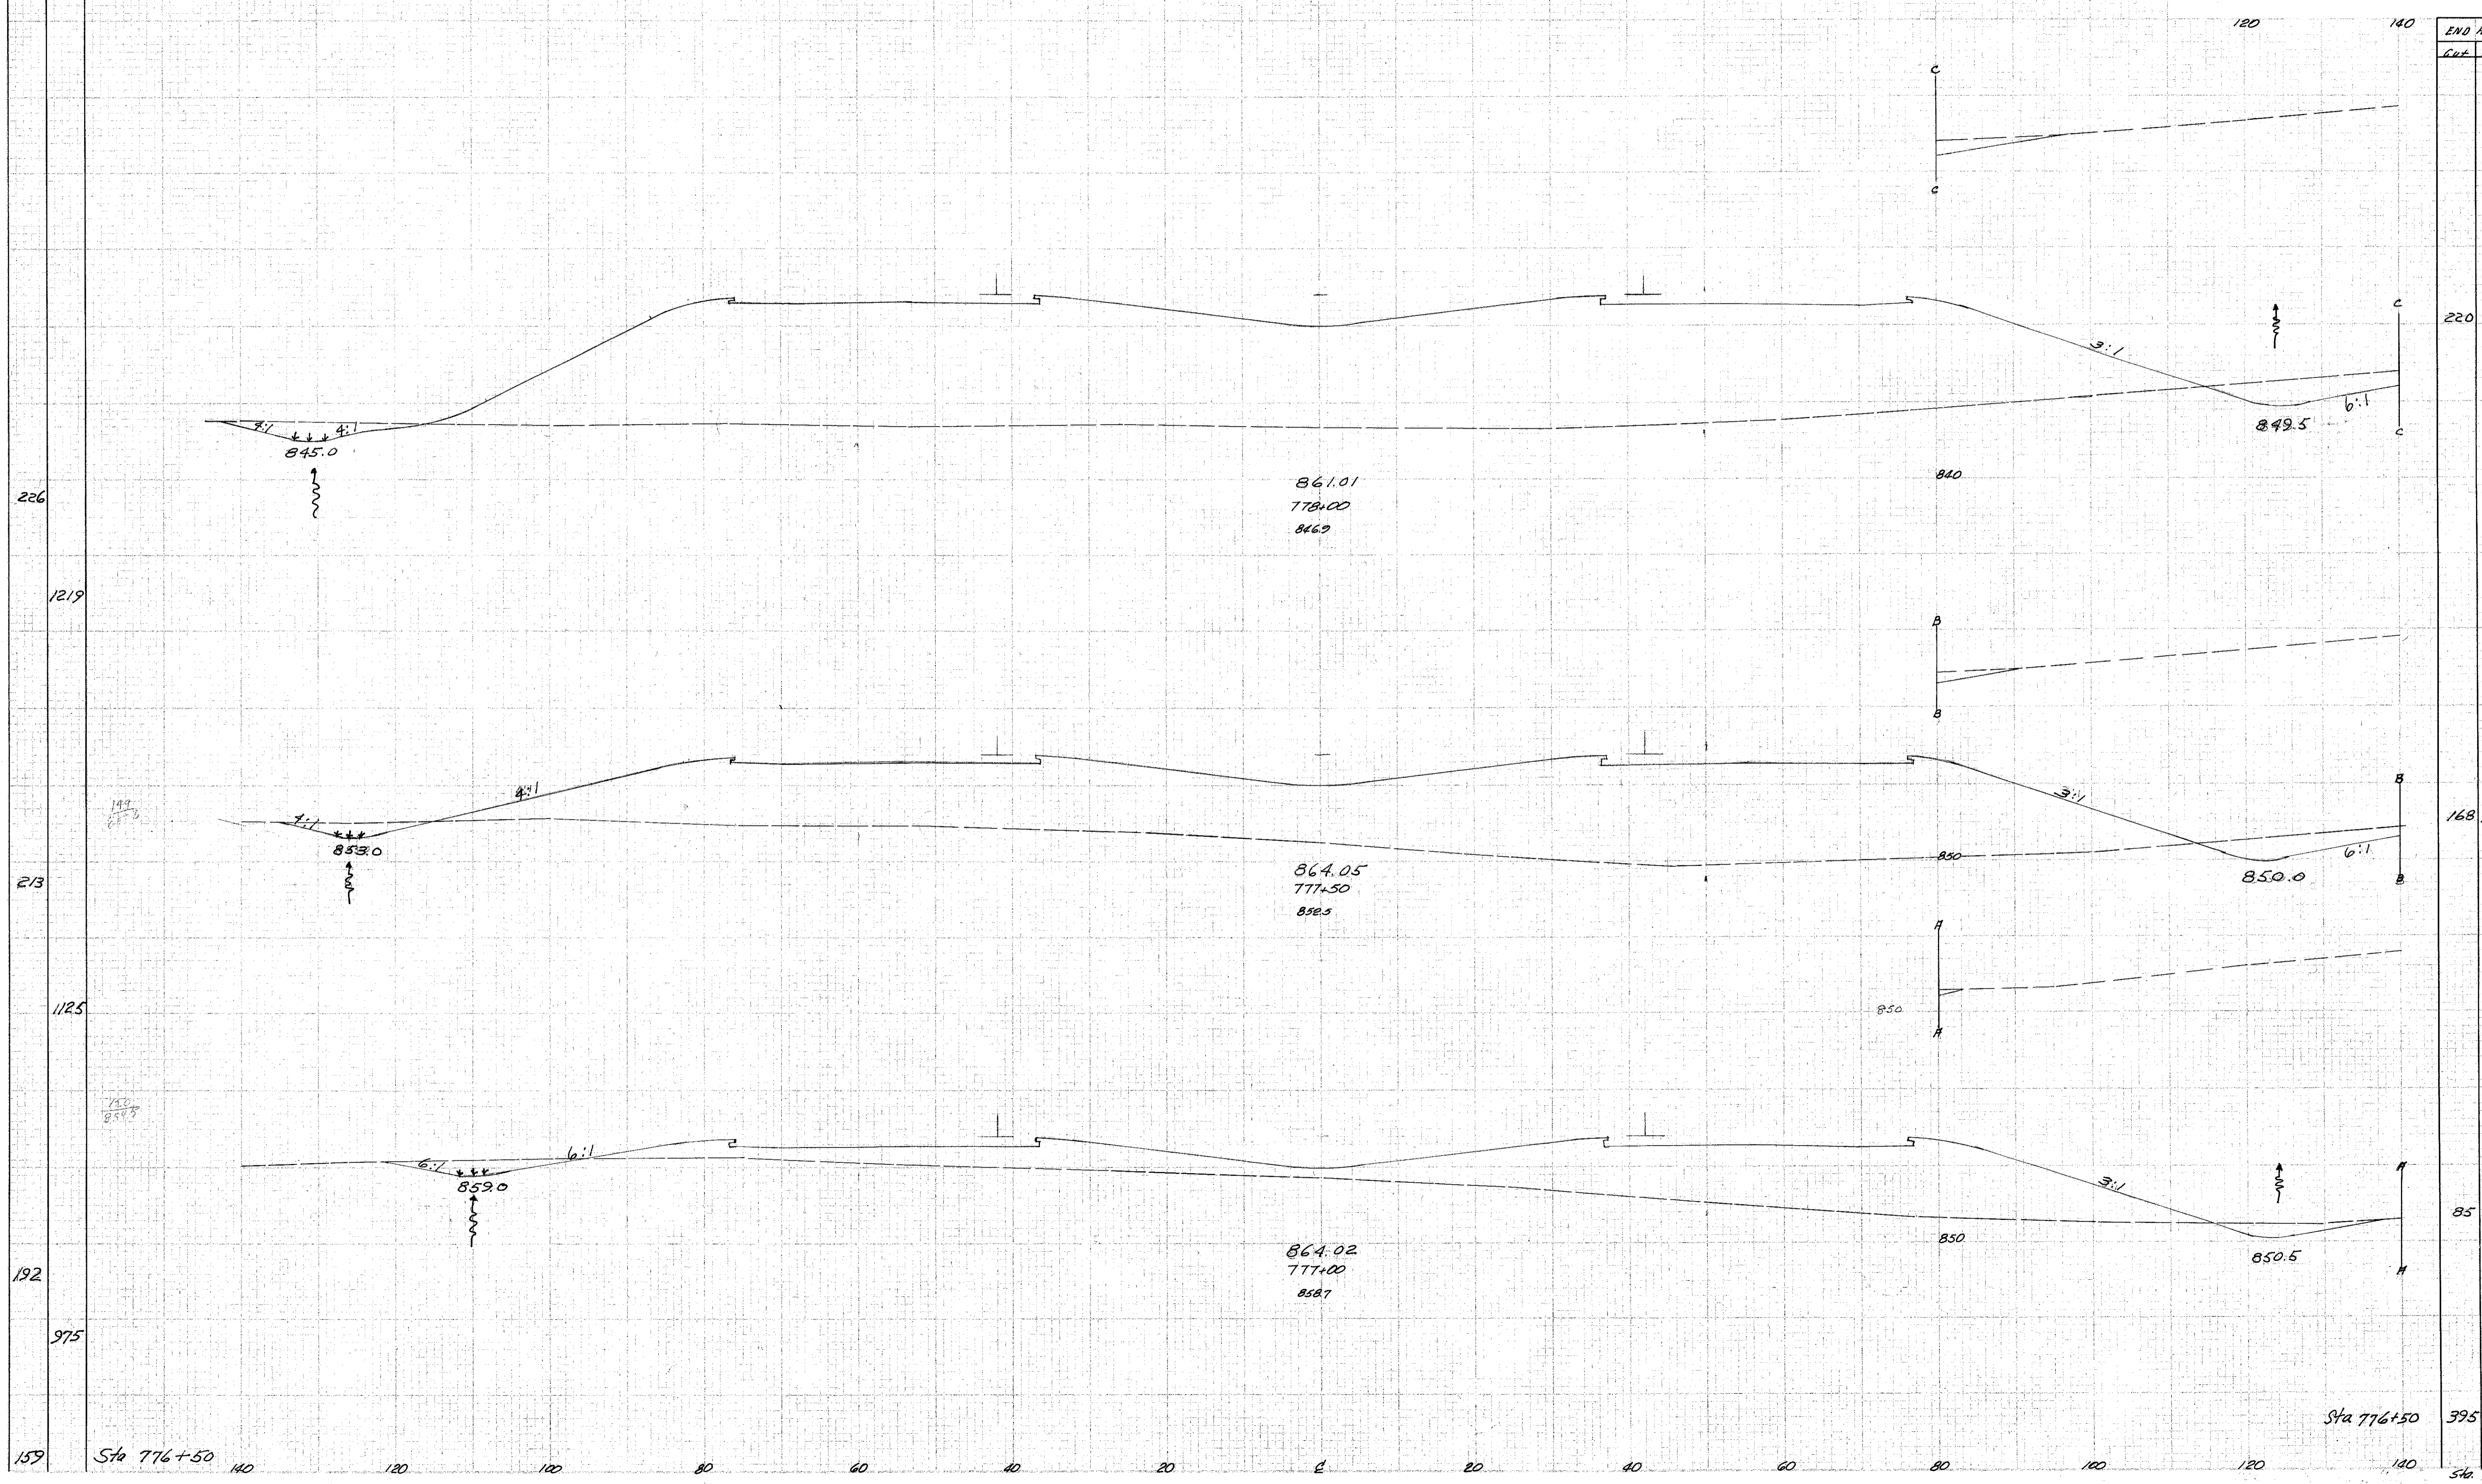

END AREA		CU. YDS.	
Cut	Fill	Cut	Fill
220	2963		
		360	4590
168	1994		
		235	2728
85	952		
		445	1037
Sta 776+50	395	167	
Sta 777+00 to 778+00			

Rev
A-30-58
4/20/58 DM
1-5-2-58 DM

Sta 776+50

Sta 776+50

Sta 777+00 to 778+00