

SEEDING
END STA.
WIDTH YDS.

280 260 240 220 200 180 160 140 120 100 80 60 40


PLAN SHEET NO. 2
DATE 1958
PROJECT HCL-1103 (28)

73
211

LAKE COUNTY
LAK-1-20.03

20 2

END STA.	AREA	CUT	FILL	CUT	FILL

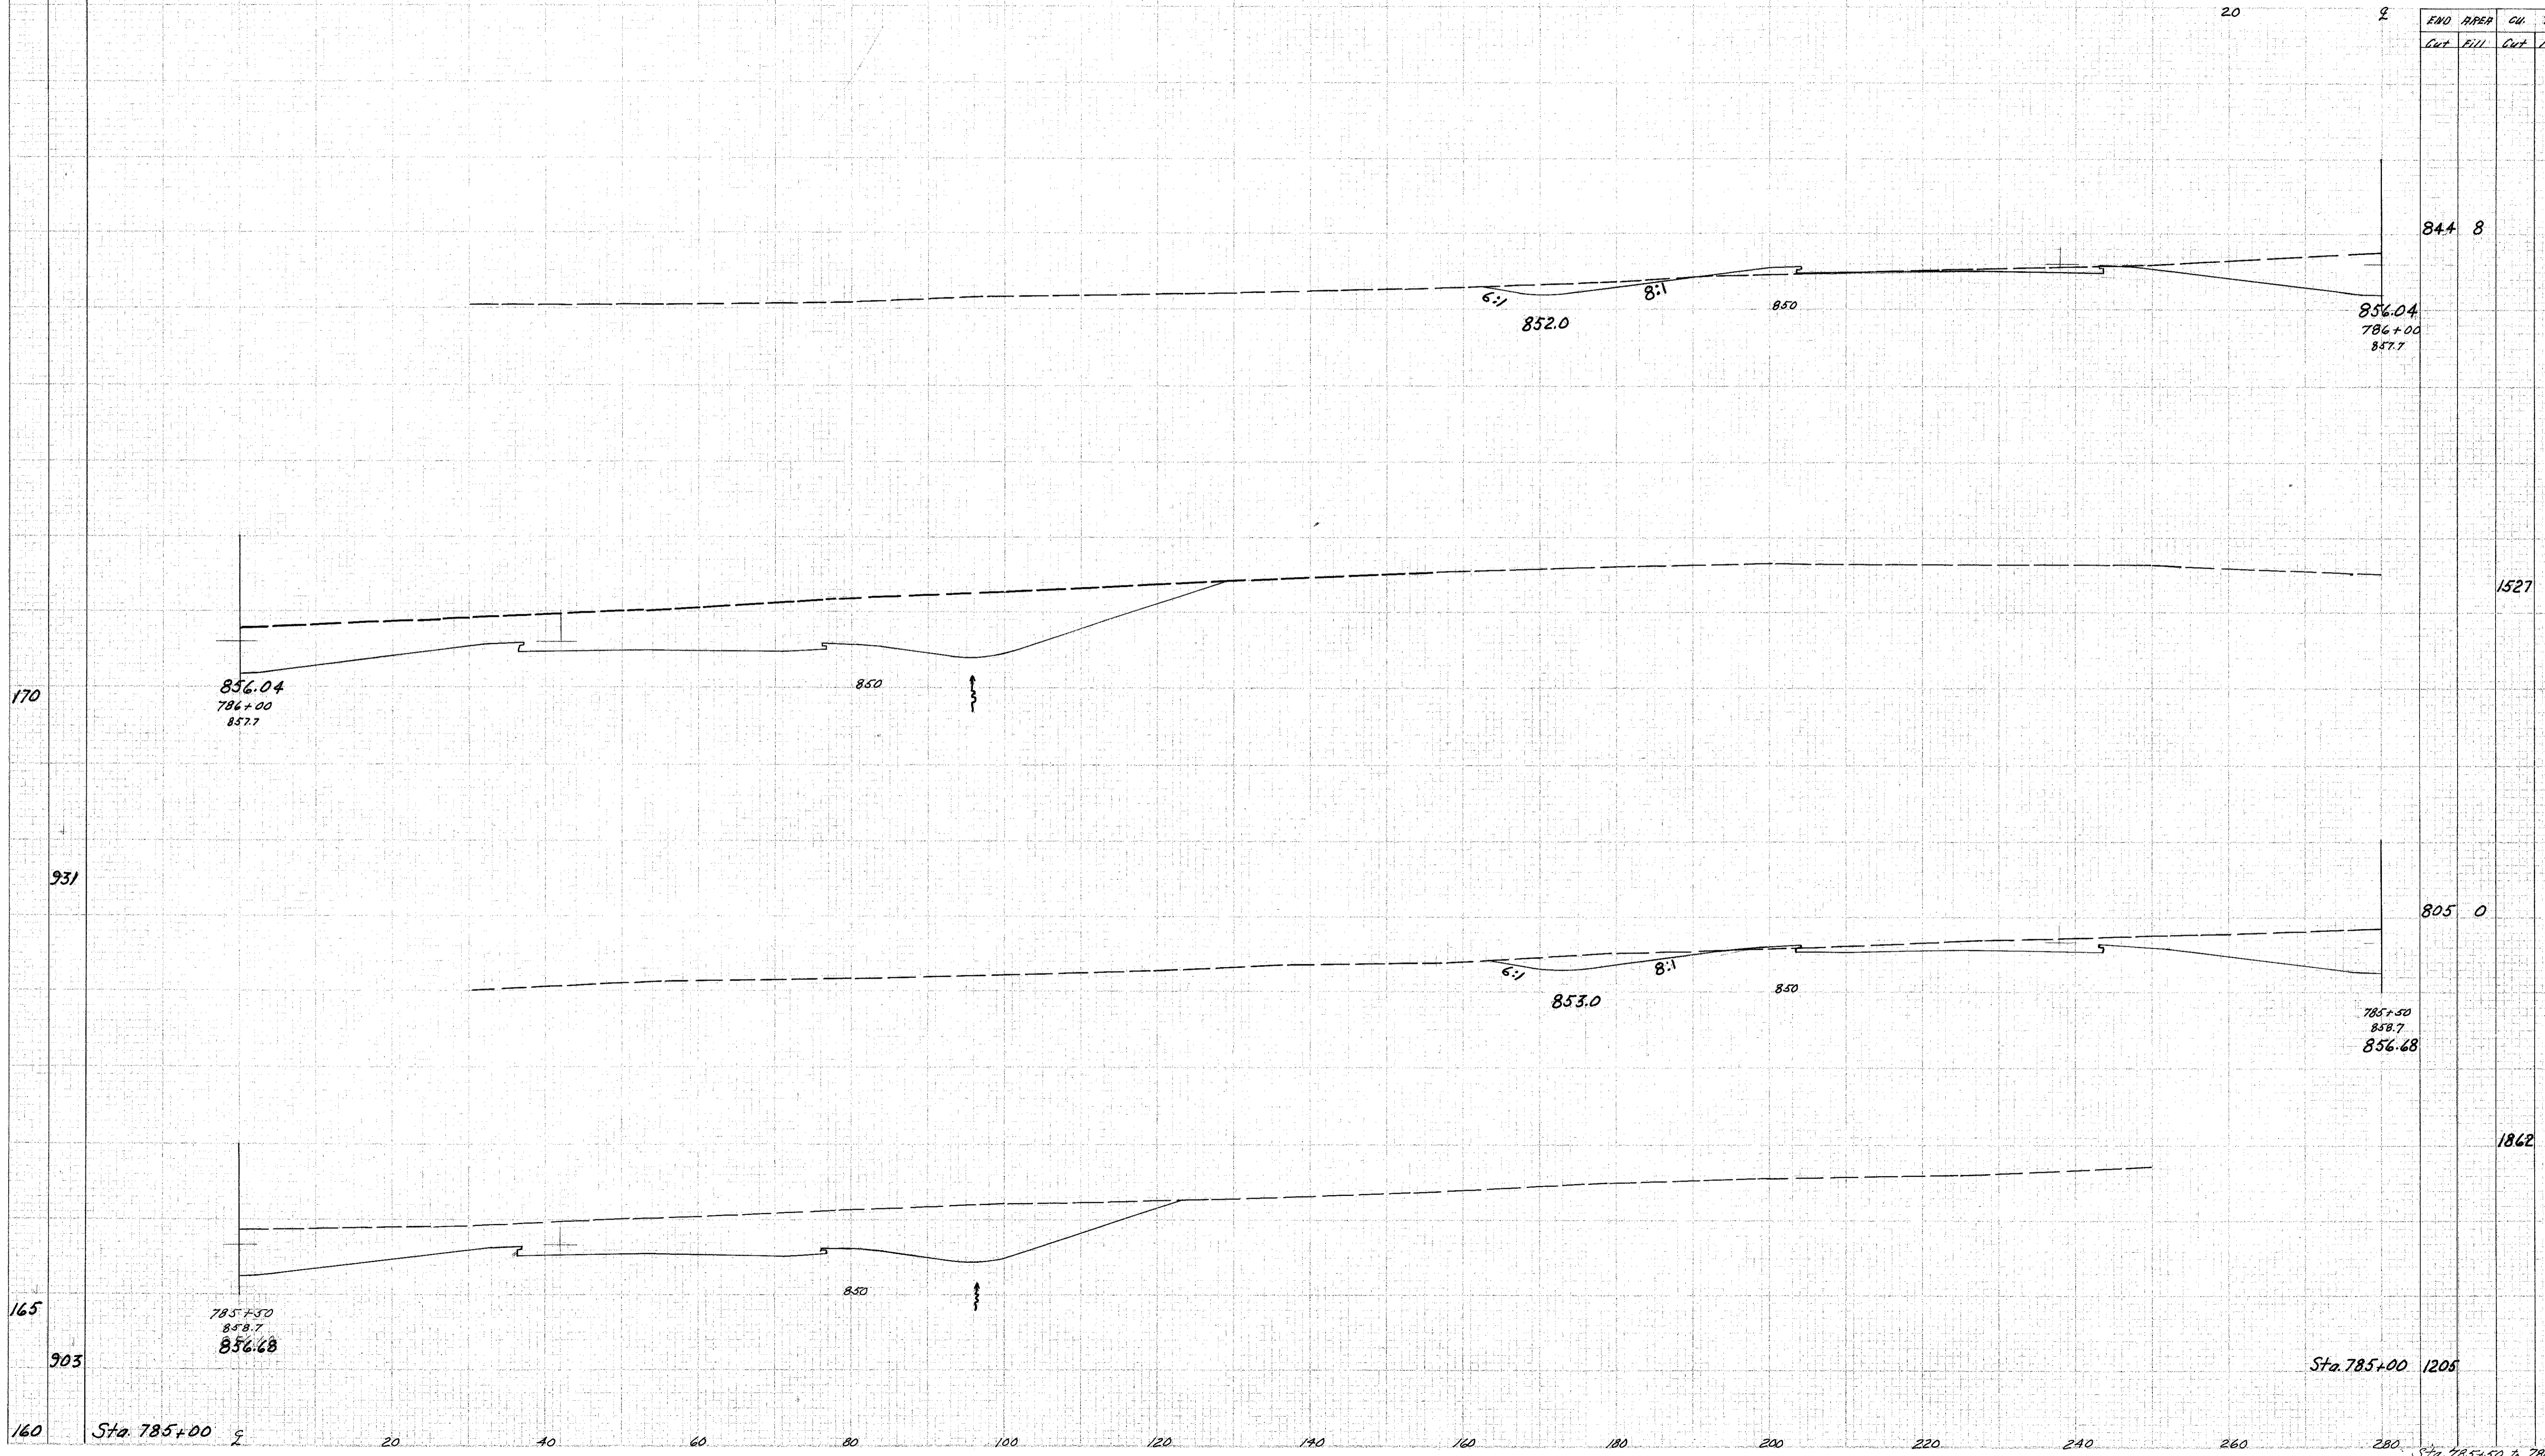

844 8

856.04
786+00
857.7

1527 8

856.04
786+00
857.7

850

805 0

785+50
858.7
856.68

1862

785+50
858.7
856.68

850

Sta. 785+00 1205

Sta. 785+00

Sta. 785+50 to 786+00

Amend 2/16/58
v. R.P. 5-5-58
Rev.
4-30-58