


SEEDING  
WIDTH  
Sq. Yds.

NO. OF SHEETS	DATE	PROJECT
2	CHIC	HCE-1103 (28)

87  
211

LAKE COUNTY  
LAK-1-20.03

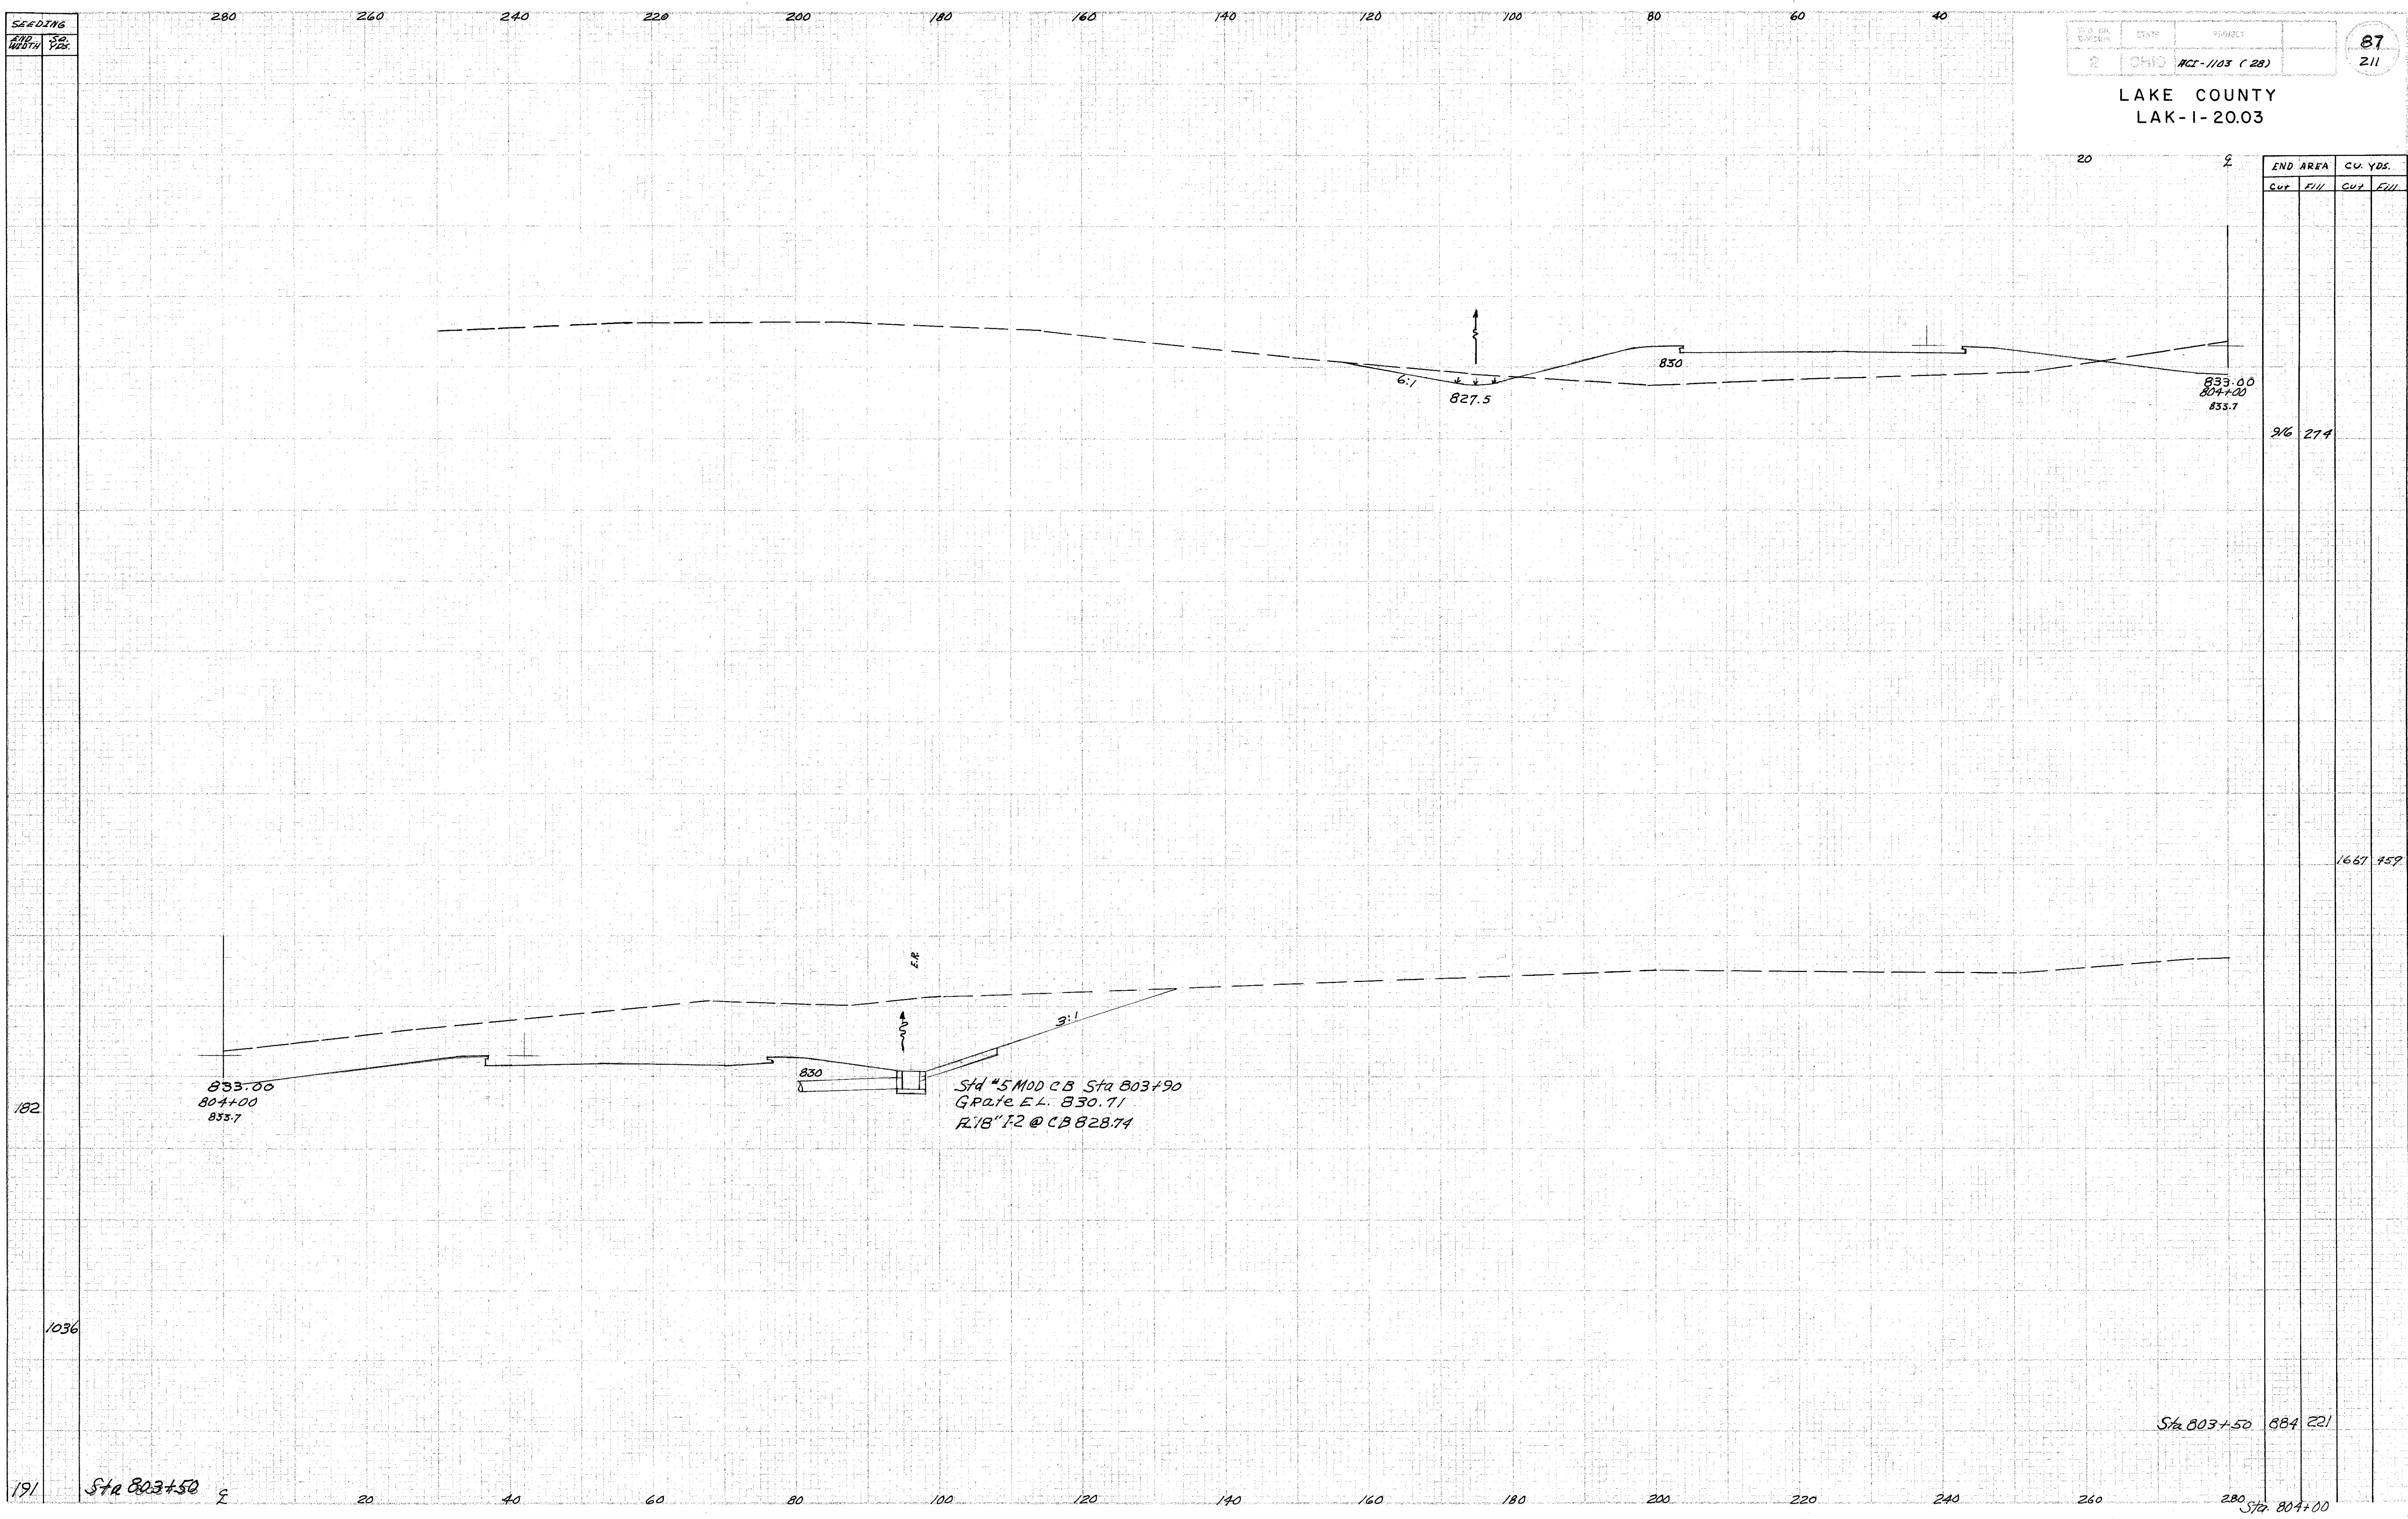

END AREA		CU. YDS.	
Cut	Fill	Cut	Fill

96 274

1667 457

Sta 803+50 884 221

Sta 804+00

Sta #5 MOD CB Sta 803+90  
Gate E.L. 830.71  
R.18" I.2 @ CB 828.74

Rev.  
4-30-58

