


SEEDING 280 260 240 220 200 180 160 140 120 100 80 60 40

FED. RD. DISTRICT	STATE	PROJECT	92 211
2	OHIO	RC-103 (28)	

LAKE COUNTY  
LAK-1-20.03

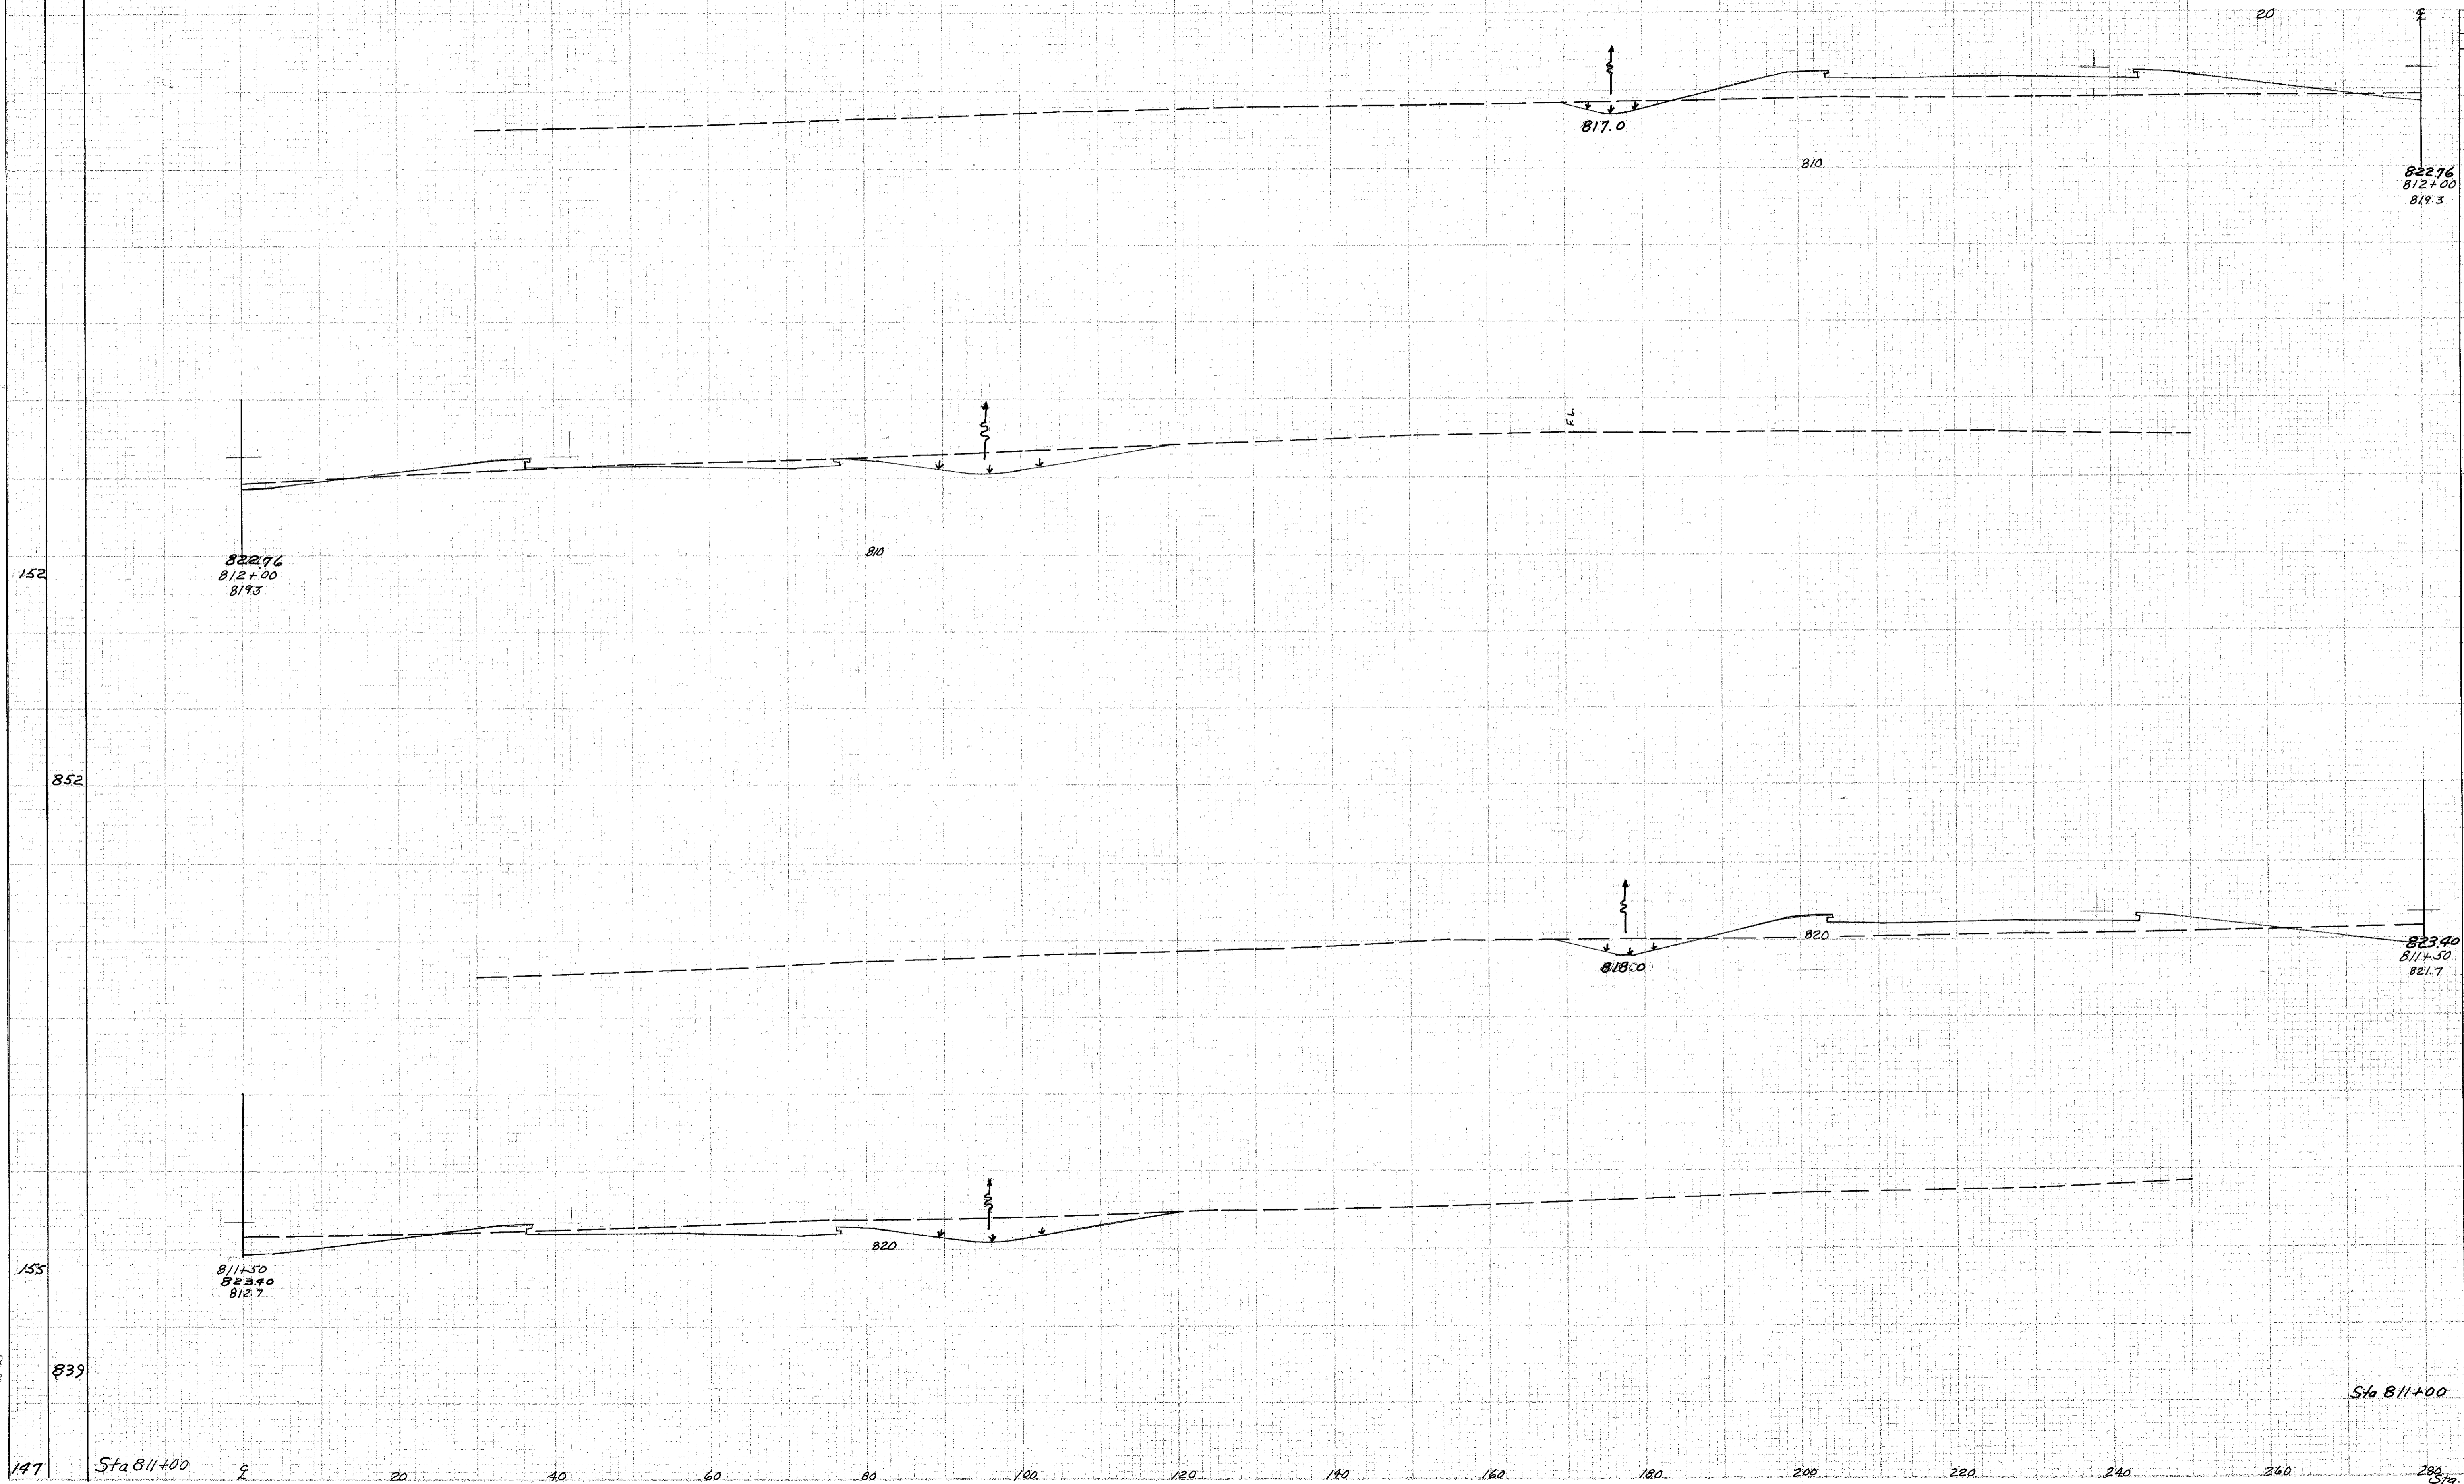

END AREA	CU. YDS.	
	Cut	Fill
100	217	
280	323	
202	131	
440	163	
Sta 811+00	273	45

Rev.  
4-30-58  
made at 5-5-58  
K.S. 5558

147 Sta 811+00 197 20 40 60 80 100 120 140 160 180 200 220 240 260 280 Sta 811+50 76 812+00