
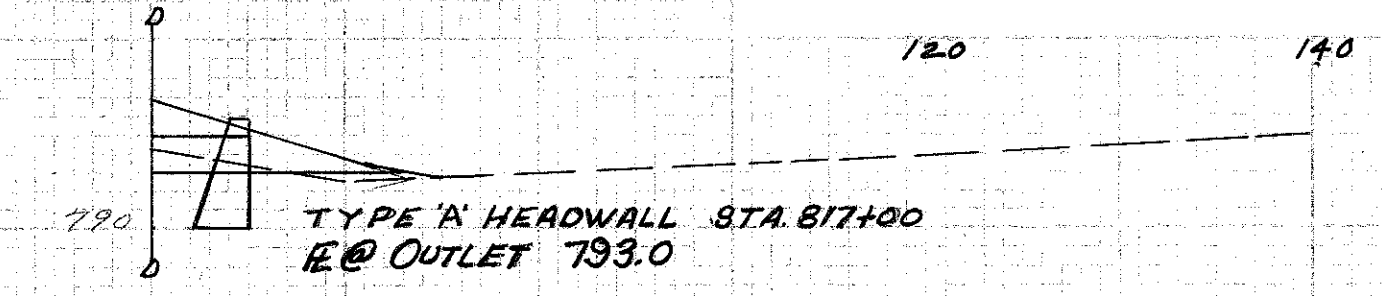


LAKE COUNTY
LAK-1-20.03

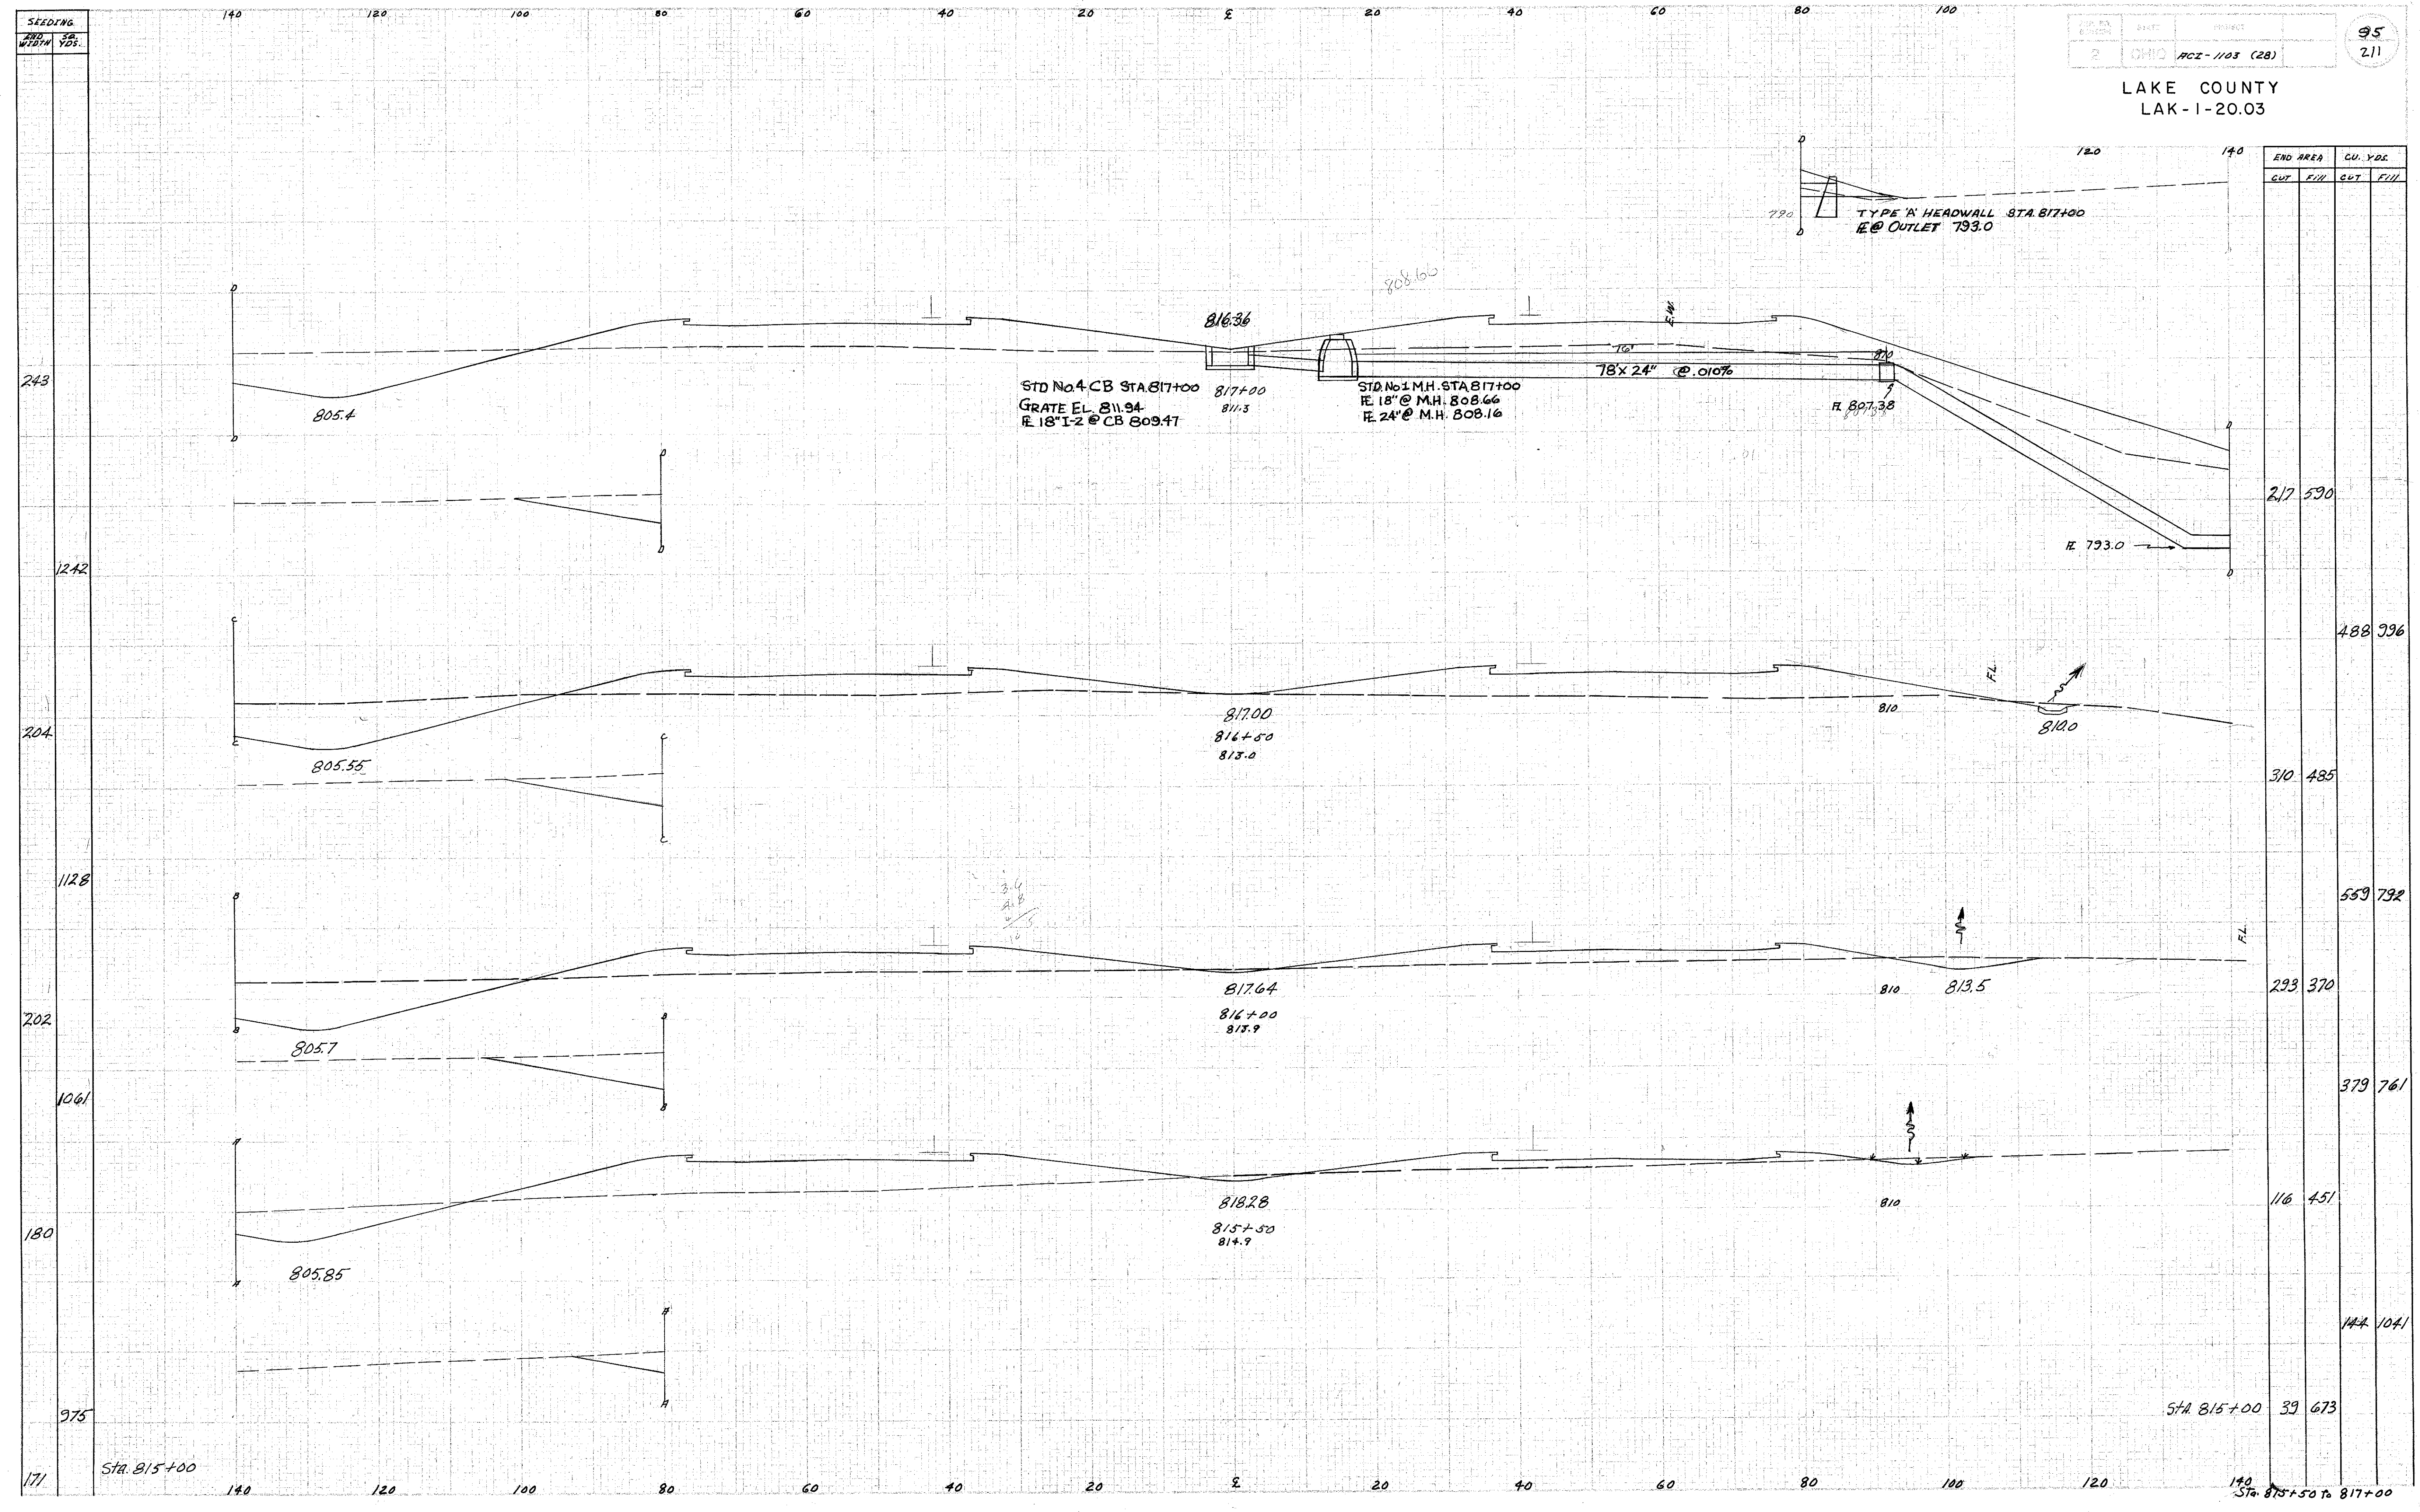

END AREA		CU. YDS.	
CUT	FILL	CUT	FILL
		217	590
		488	996
		310	485
		559	792
		293	370
		379	761
		116	451
		144	1041
		39	673

SEEDING
 AND WIDTH
 YDS.

243
 1242
 204
 1128
 202
 1061
 180
 975
 171

Rev
 4-30-58
 J.B. 5-5-58

STD No. 4 CB STA. 817+00
 GRATE EL. 811.94
 R. 18" I-2 @ CB 809.47

STD. No. 1 M.H. STA. 817+00
 R. 18" @ M.H. 808.66
 R. 24" @ M.H. 808.16

78x24" @ .010%

TYPE A HEADWALL STA. 817+00
 R @ OUTLET 793.0

3.4
2.8
10.5

Sta. 815+00

Sta. 815+00 39 673

Sta. 815+50 to 817+00