


SEEDING
END STA.
WEIGHT YDS.

PROJECT NO.	STATE	PROJECT	125
2	OHIO	WCI-1103 (2B)	211

LAKE COUNTY
LAK-1-20.03

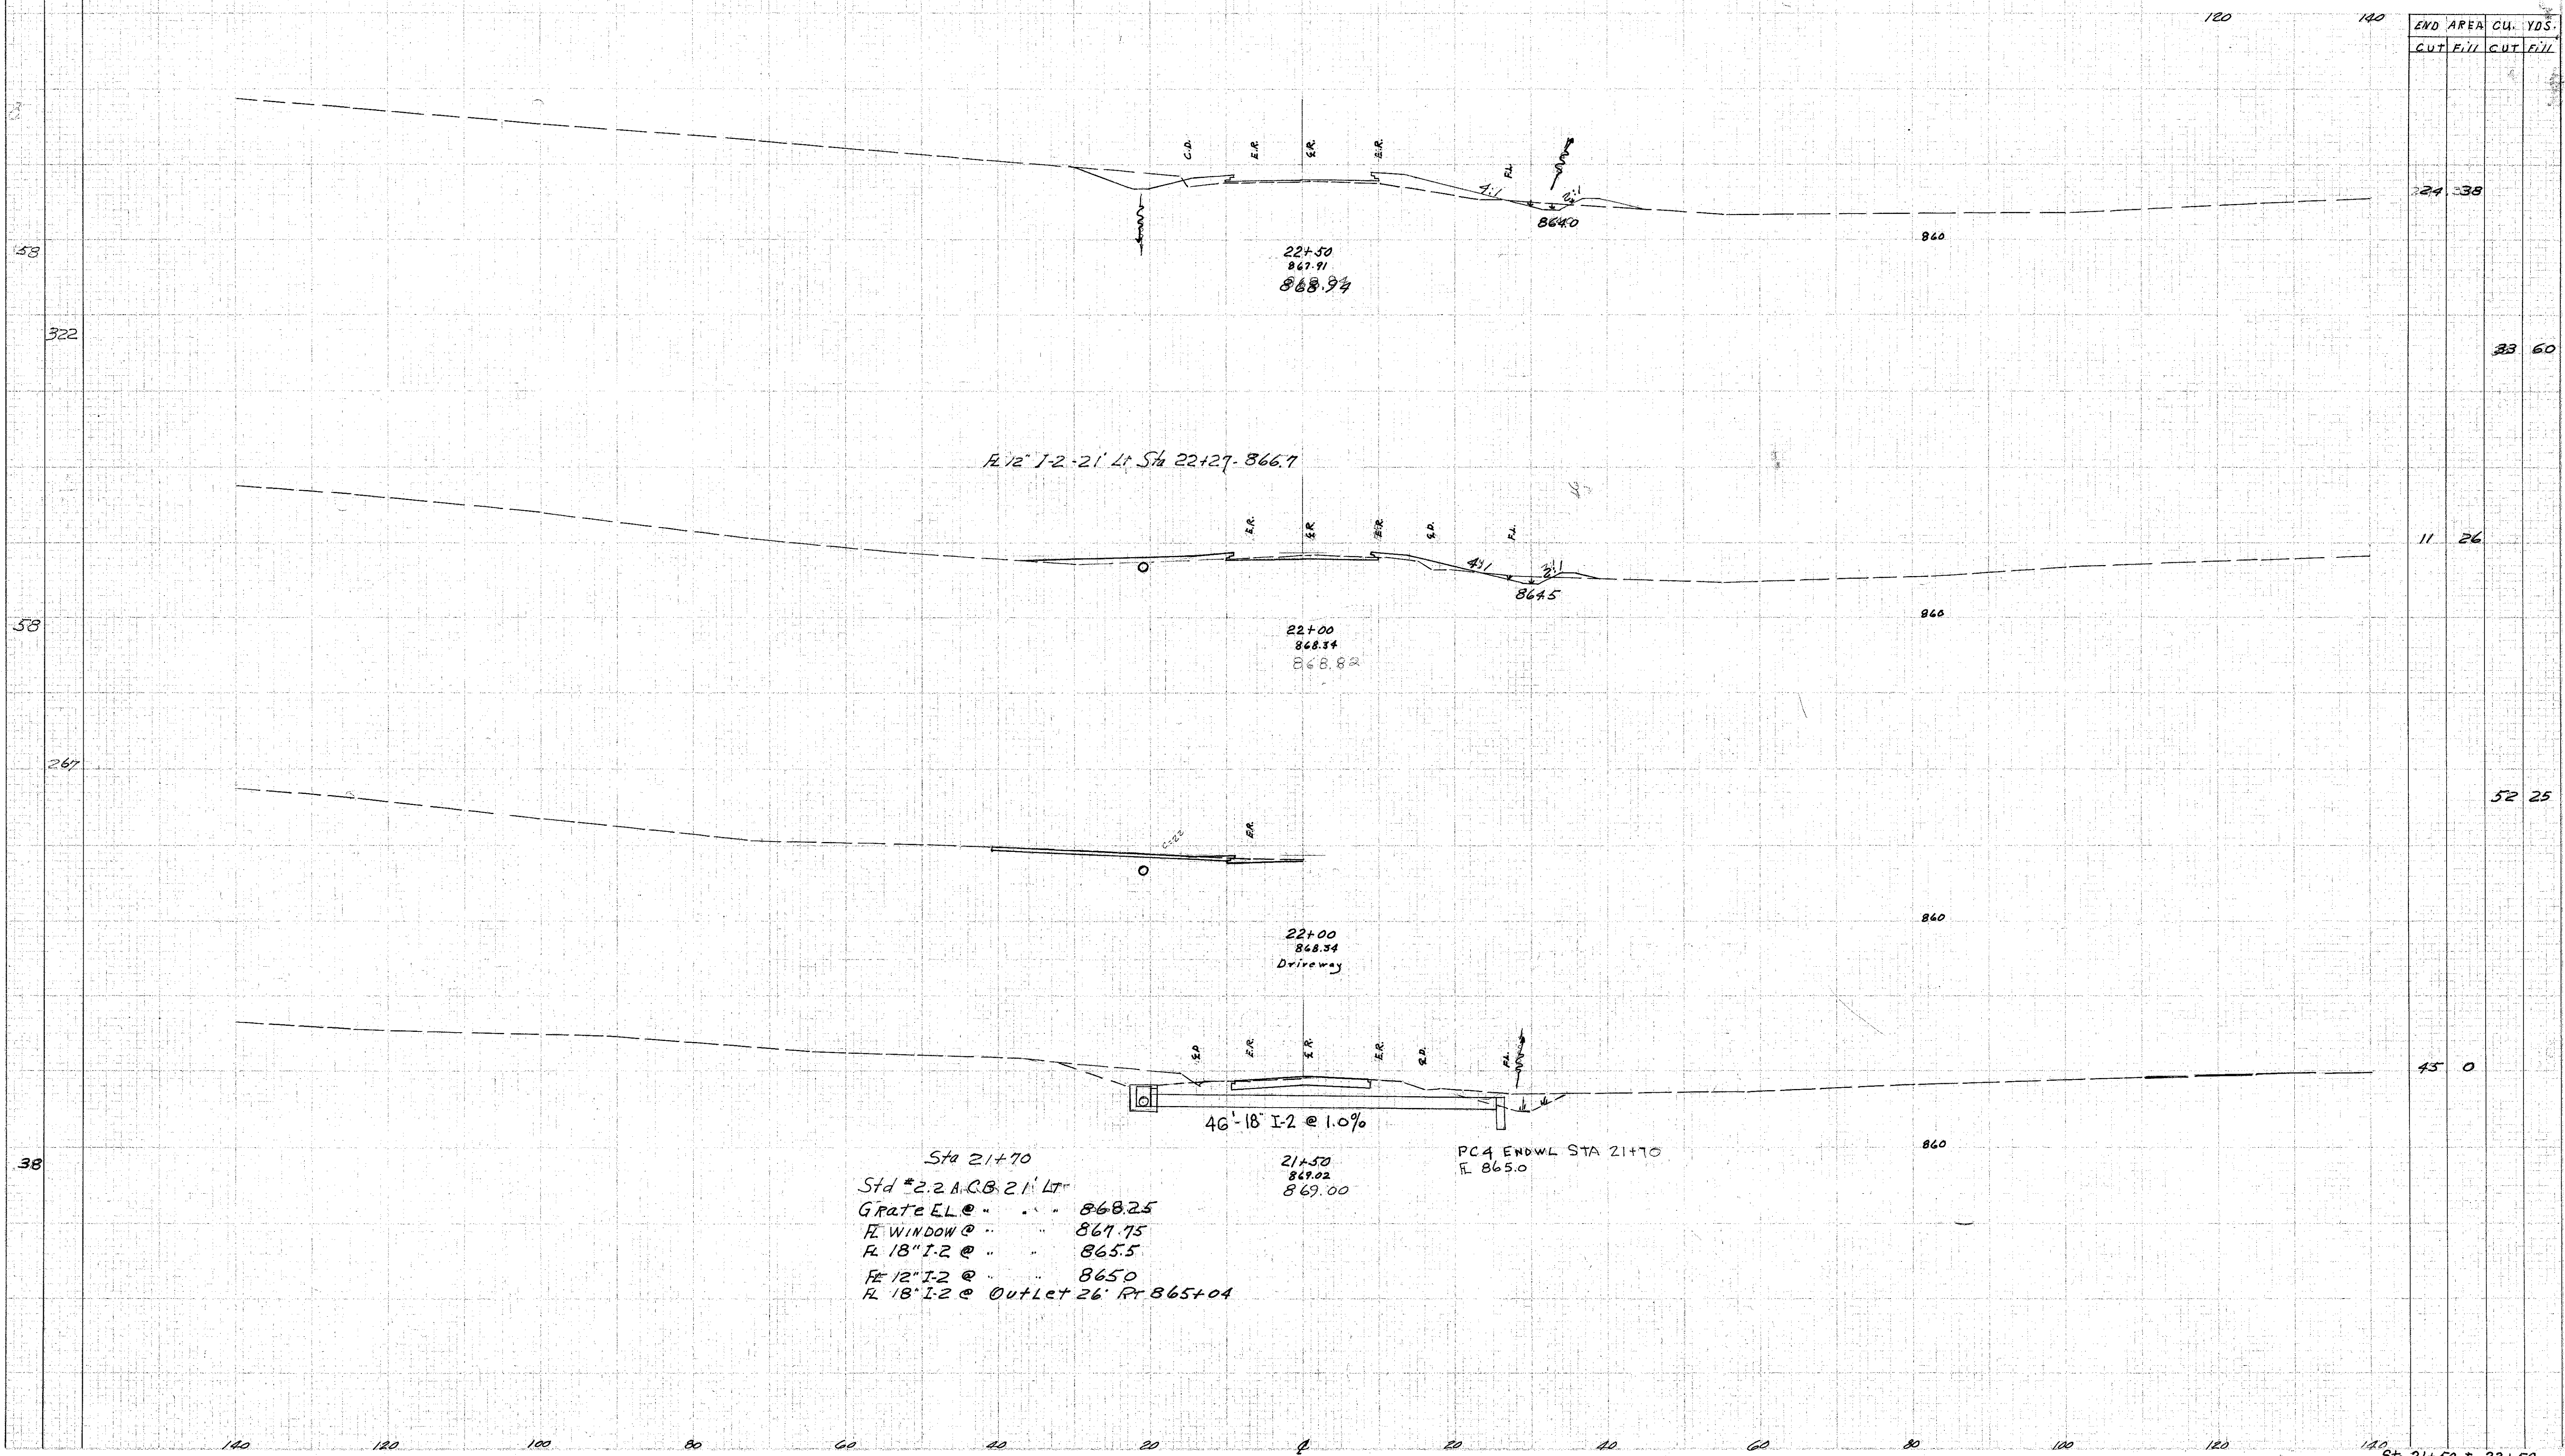

END AREA		CU. YDS.	
CUT	FILL	CUT	FILL

24 38

33 60

11 26

52 25

45 0

Sta 21+70
Std #2.2 A.C.B. 21' Lt
Grate EL @ 868.25
R WINDOW @ 867.75
R 18" I-2 @ 865.5
R 12" I-2 @ 865.0
R 18" I-2 @ Outlet 26' Rt 865+04

21+50
869.02
869.00

PCA ENDWL STA 21+70
E 865.0

Amend R/F 4-18-58
2-211 4-18-58