


FED. RD. DIVISION	STATE	PROJECT
2	OHIO	ACI-1103 (28)

144  
211

LAKE COUNTY  
LAK-1-20.03

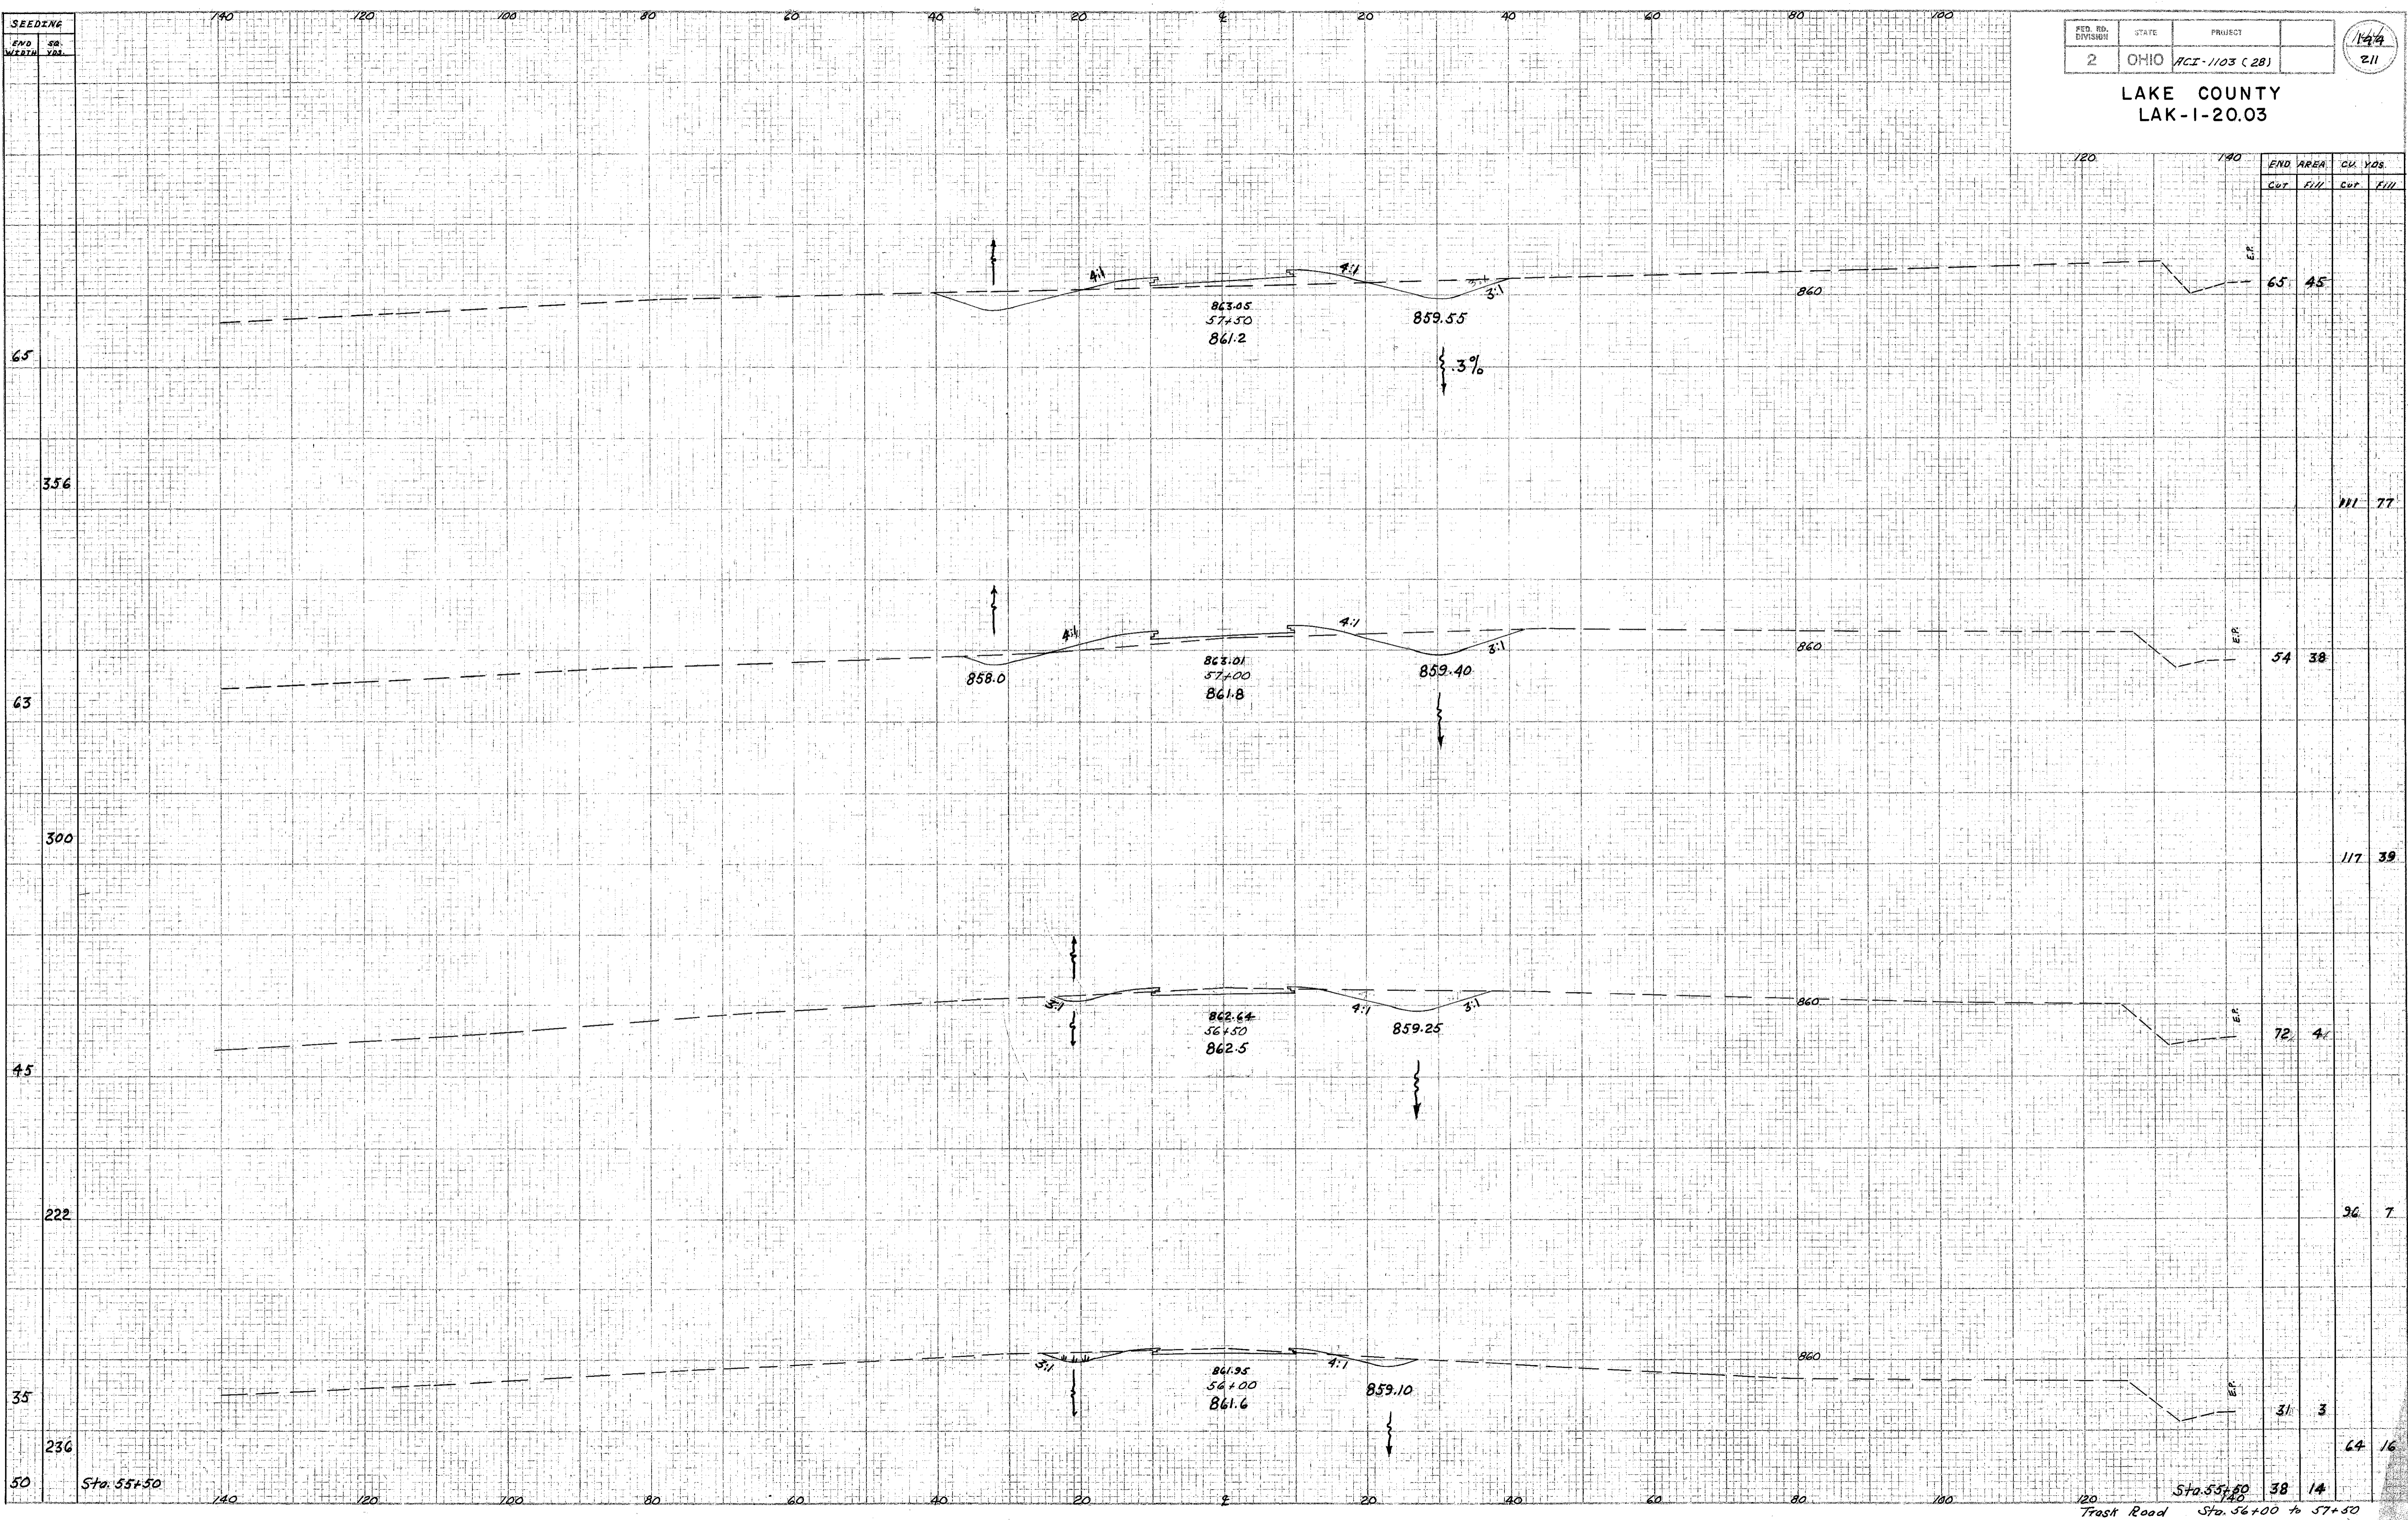

END AREA		CU. YDS.	
Cut	Fill	Cut	Fill
65	45		
356		111	77
63	38		
300		117	39
45	41		
222		96	7
35	3		
236		64	16
50	38	14	

Area 5-1-58 and  
5-2-58 FS.  
Revised etc  
5-1-58

J. FGC 5-1-58

Sta. 55+50

Sta. 56+00  
Trask Road  
Sta. 56+00 to 57+50

56 13