


LAKE COUNTY
LAK-1-20.03

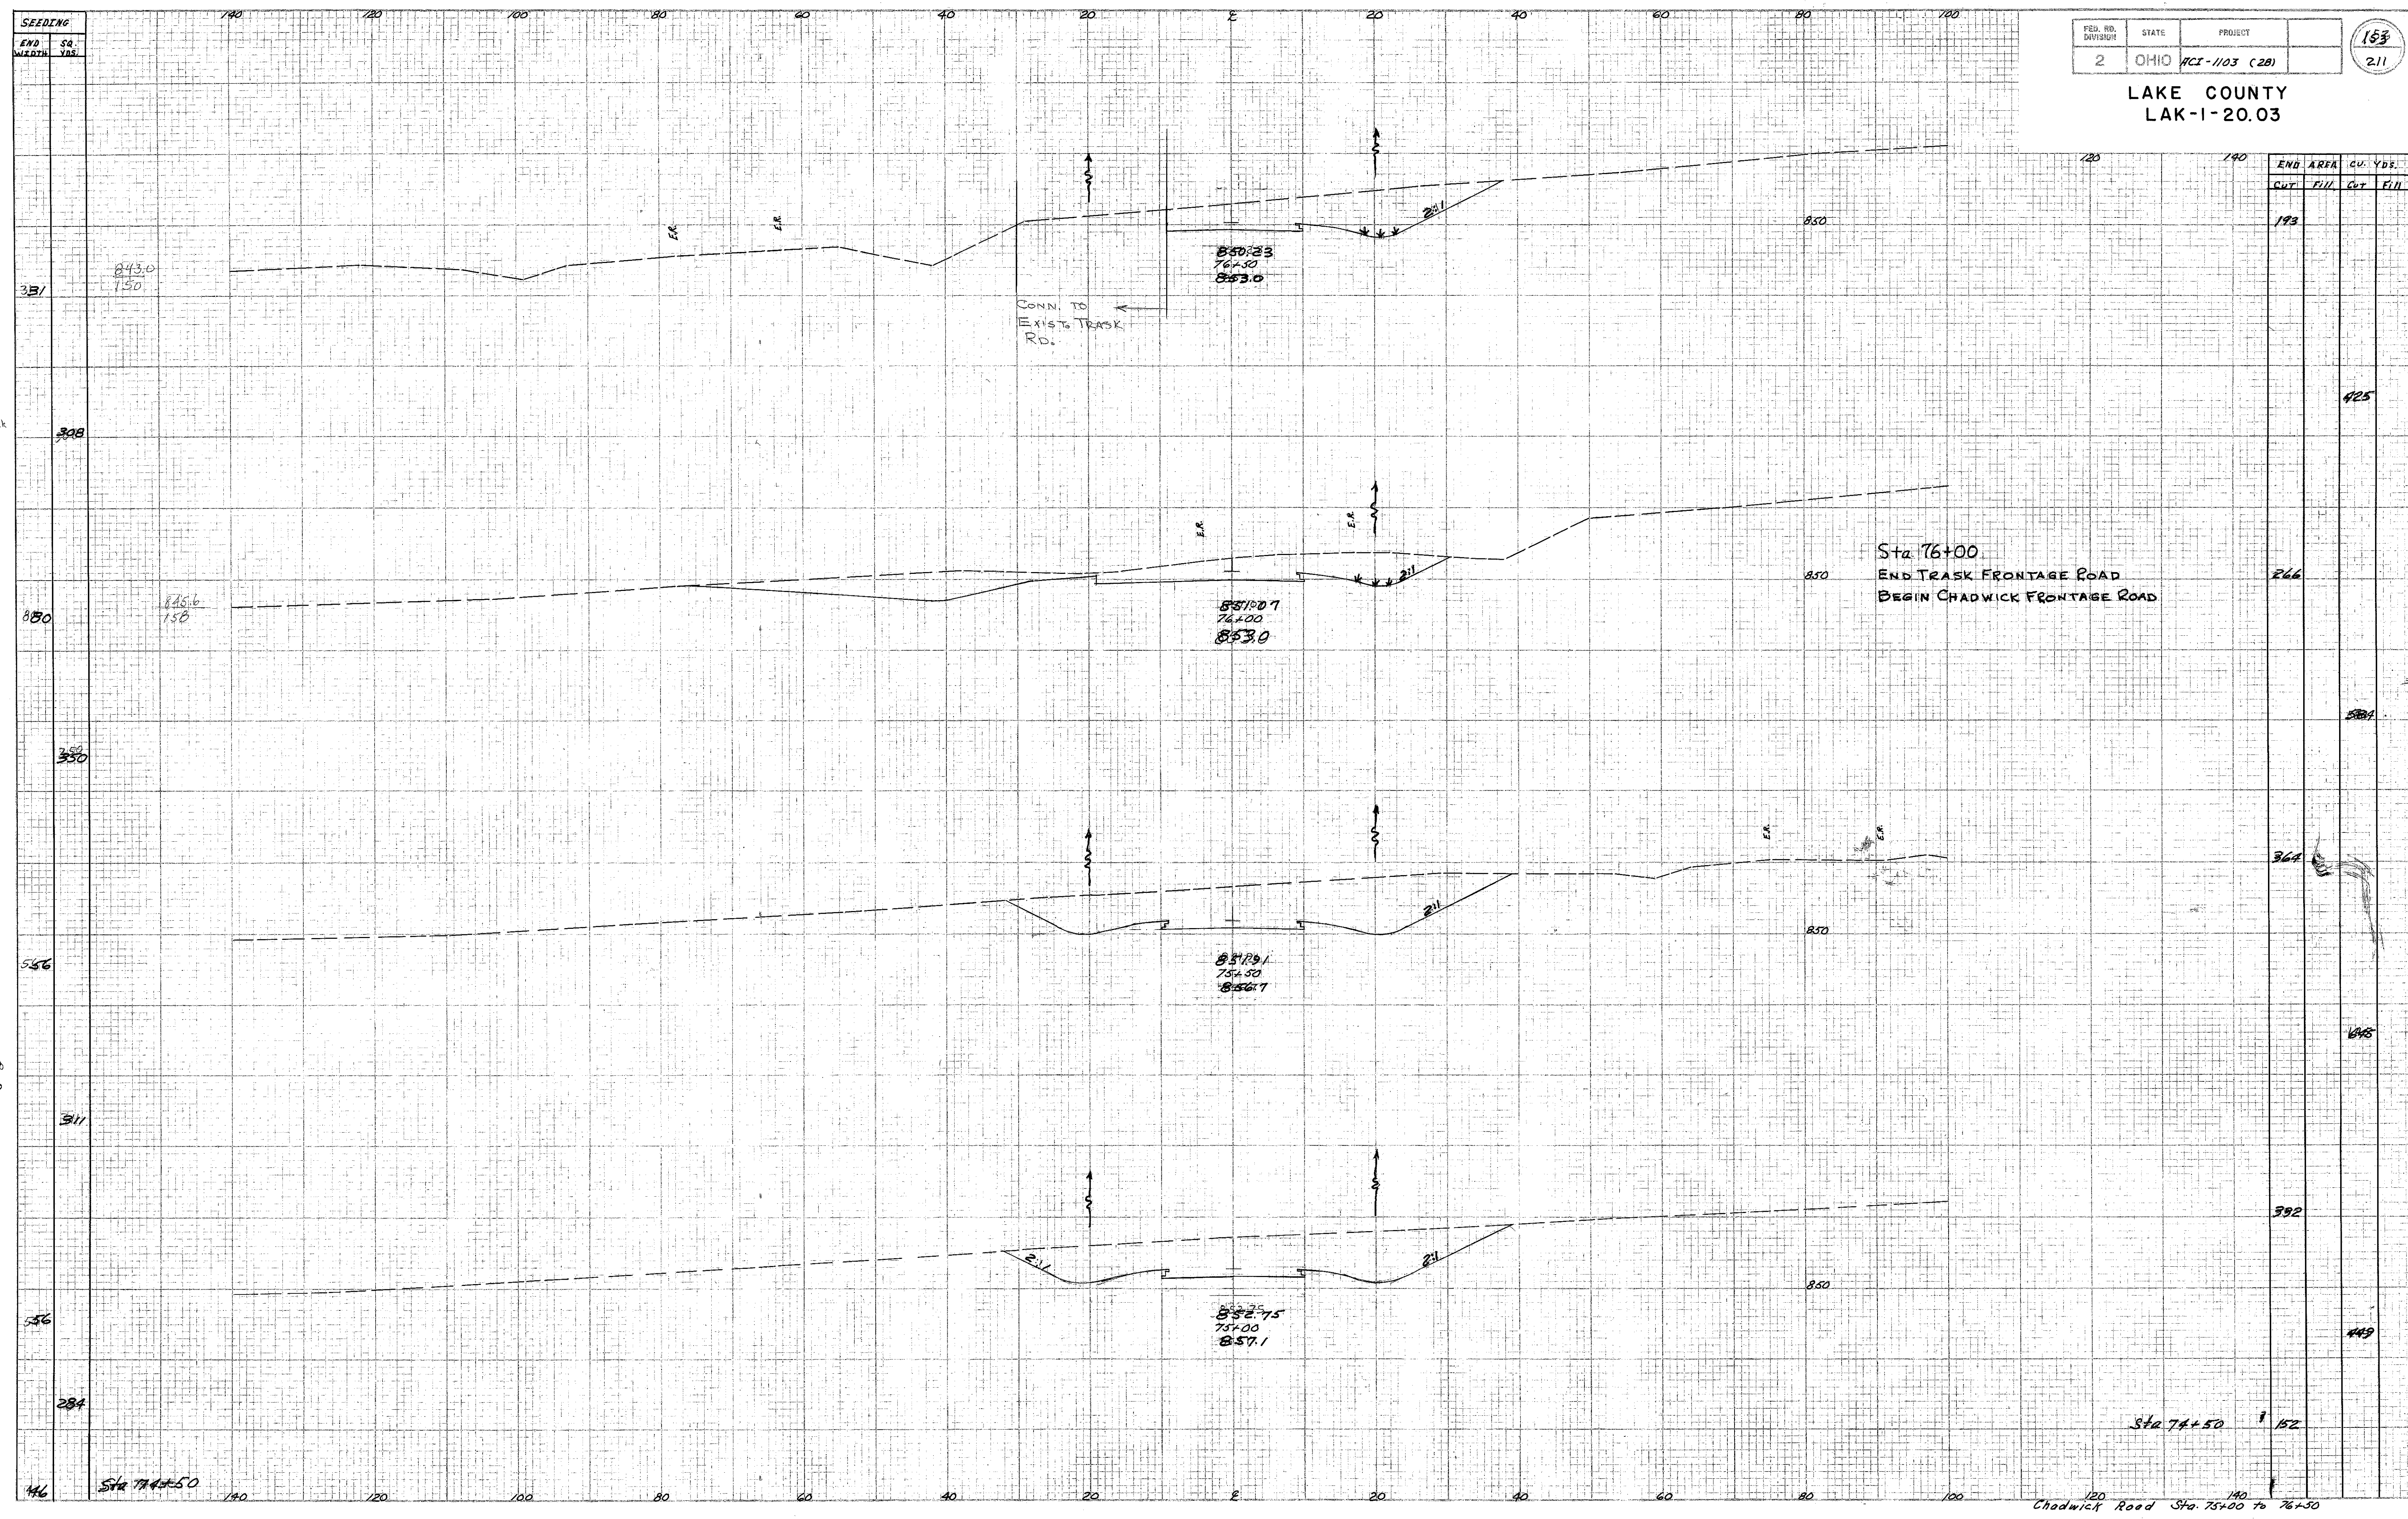

Begin Check

used MC 5-8-58
Rd 5-8-58

Revised 5-1-58
By F.G.C.
VEEC

Sta 74+50
Chadwick Road Sta. 75+00 to 76+50