


LAKE COUNTY
LAK-1-20.03

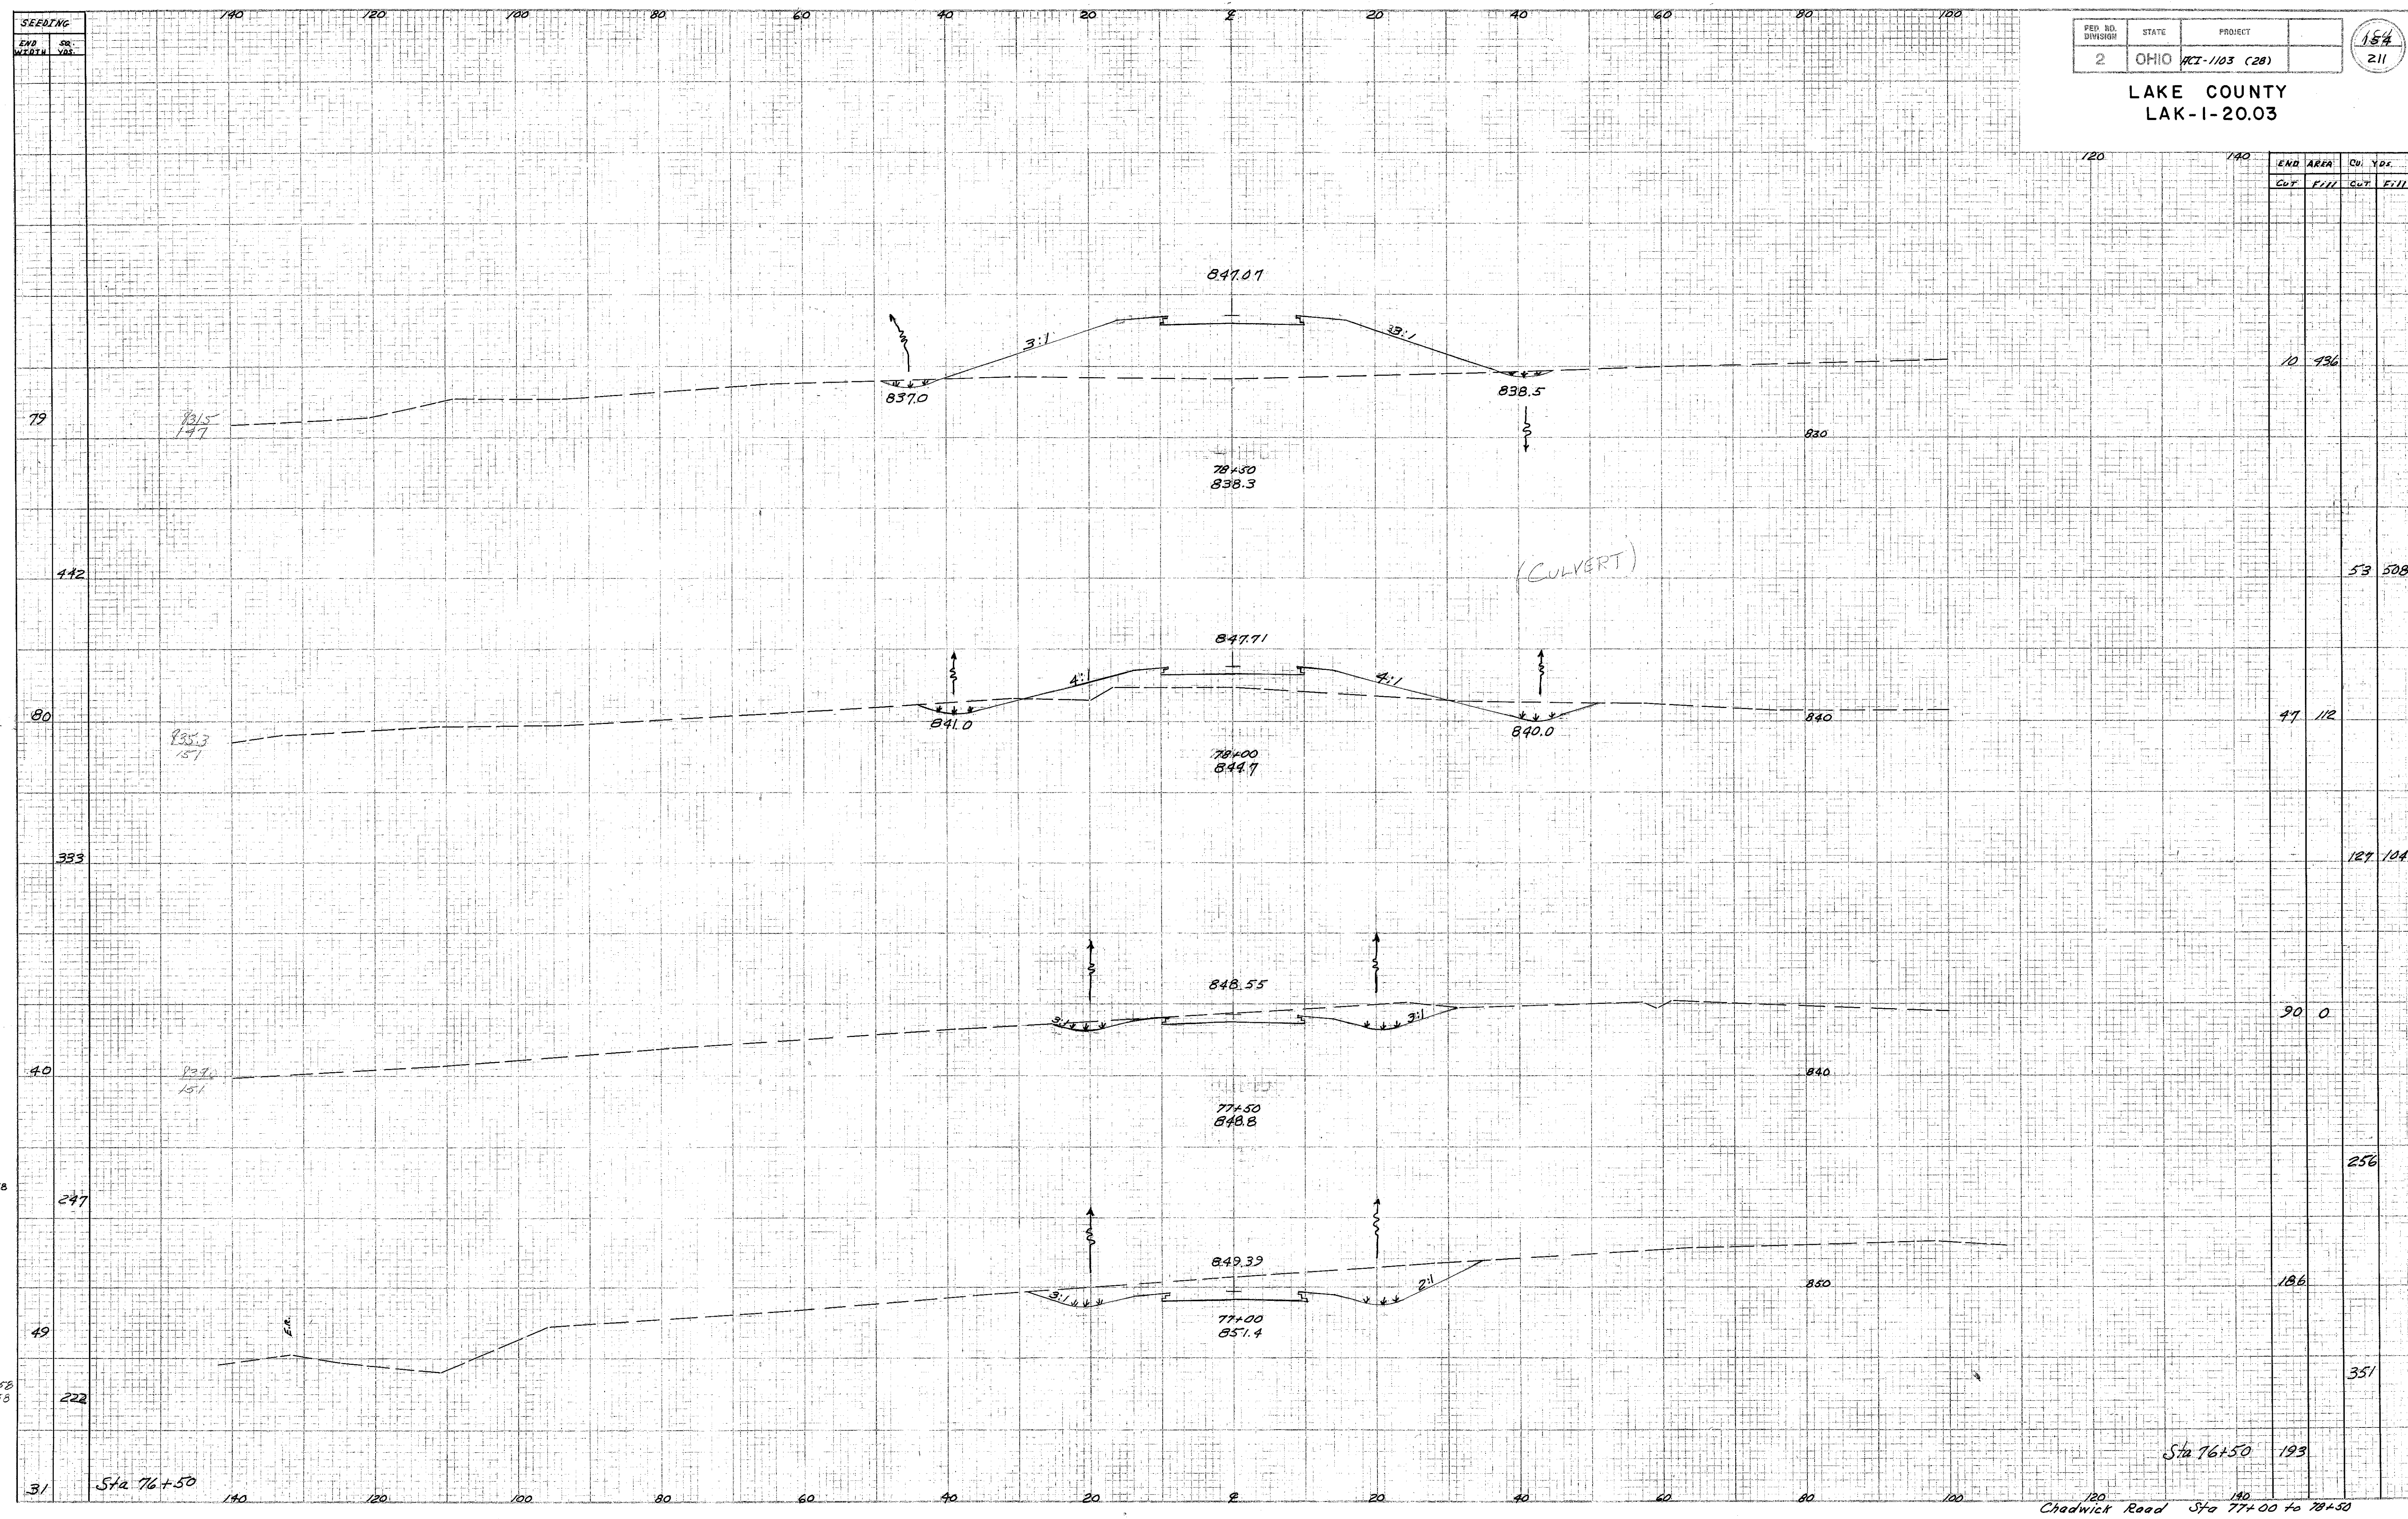

END AREA		Cu. Yds.	
Cut	Fill	Cut	Fill

10	936		
53	508		
47	112		
127	104		
90	0		
256			
186			
351			
193			

Chadwick Road Sta 77+00 to 78+50

Revised 5-1-58
By F.G.C.
ZMS 5-1-58

Area F.S. 5-8-58
V DM 5-8-58

Sta 76+50

Sta 76+50 193