


SEEDING 140 120 100 80 60 40 20 E 20 40 60 80 100

FED. RD. DIVISION	STATE	PROJECT
2	OHIO	PCI-1103 (28)

155
211

LAKE COUNTY
LAK-1-20.03

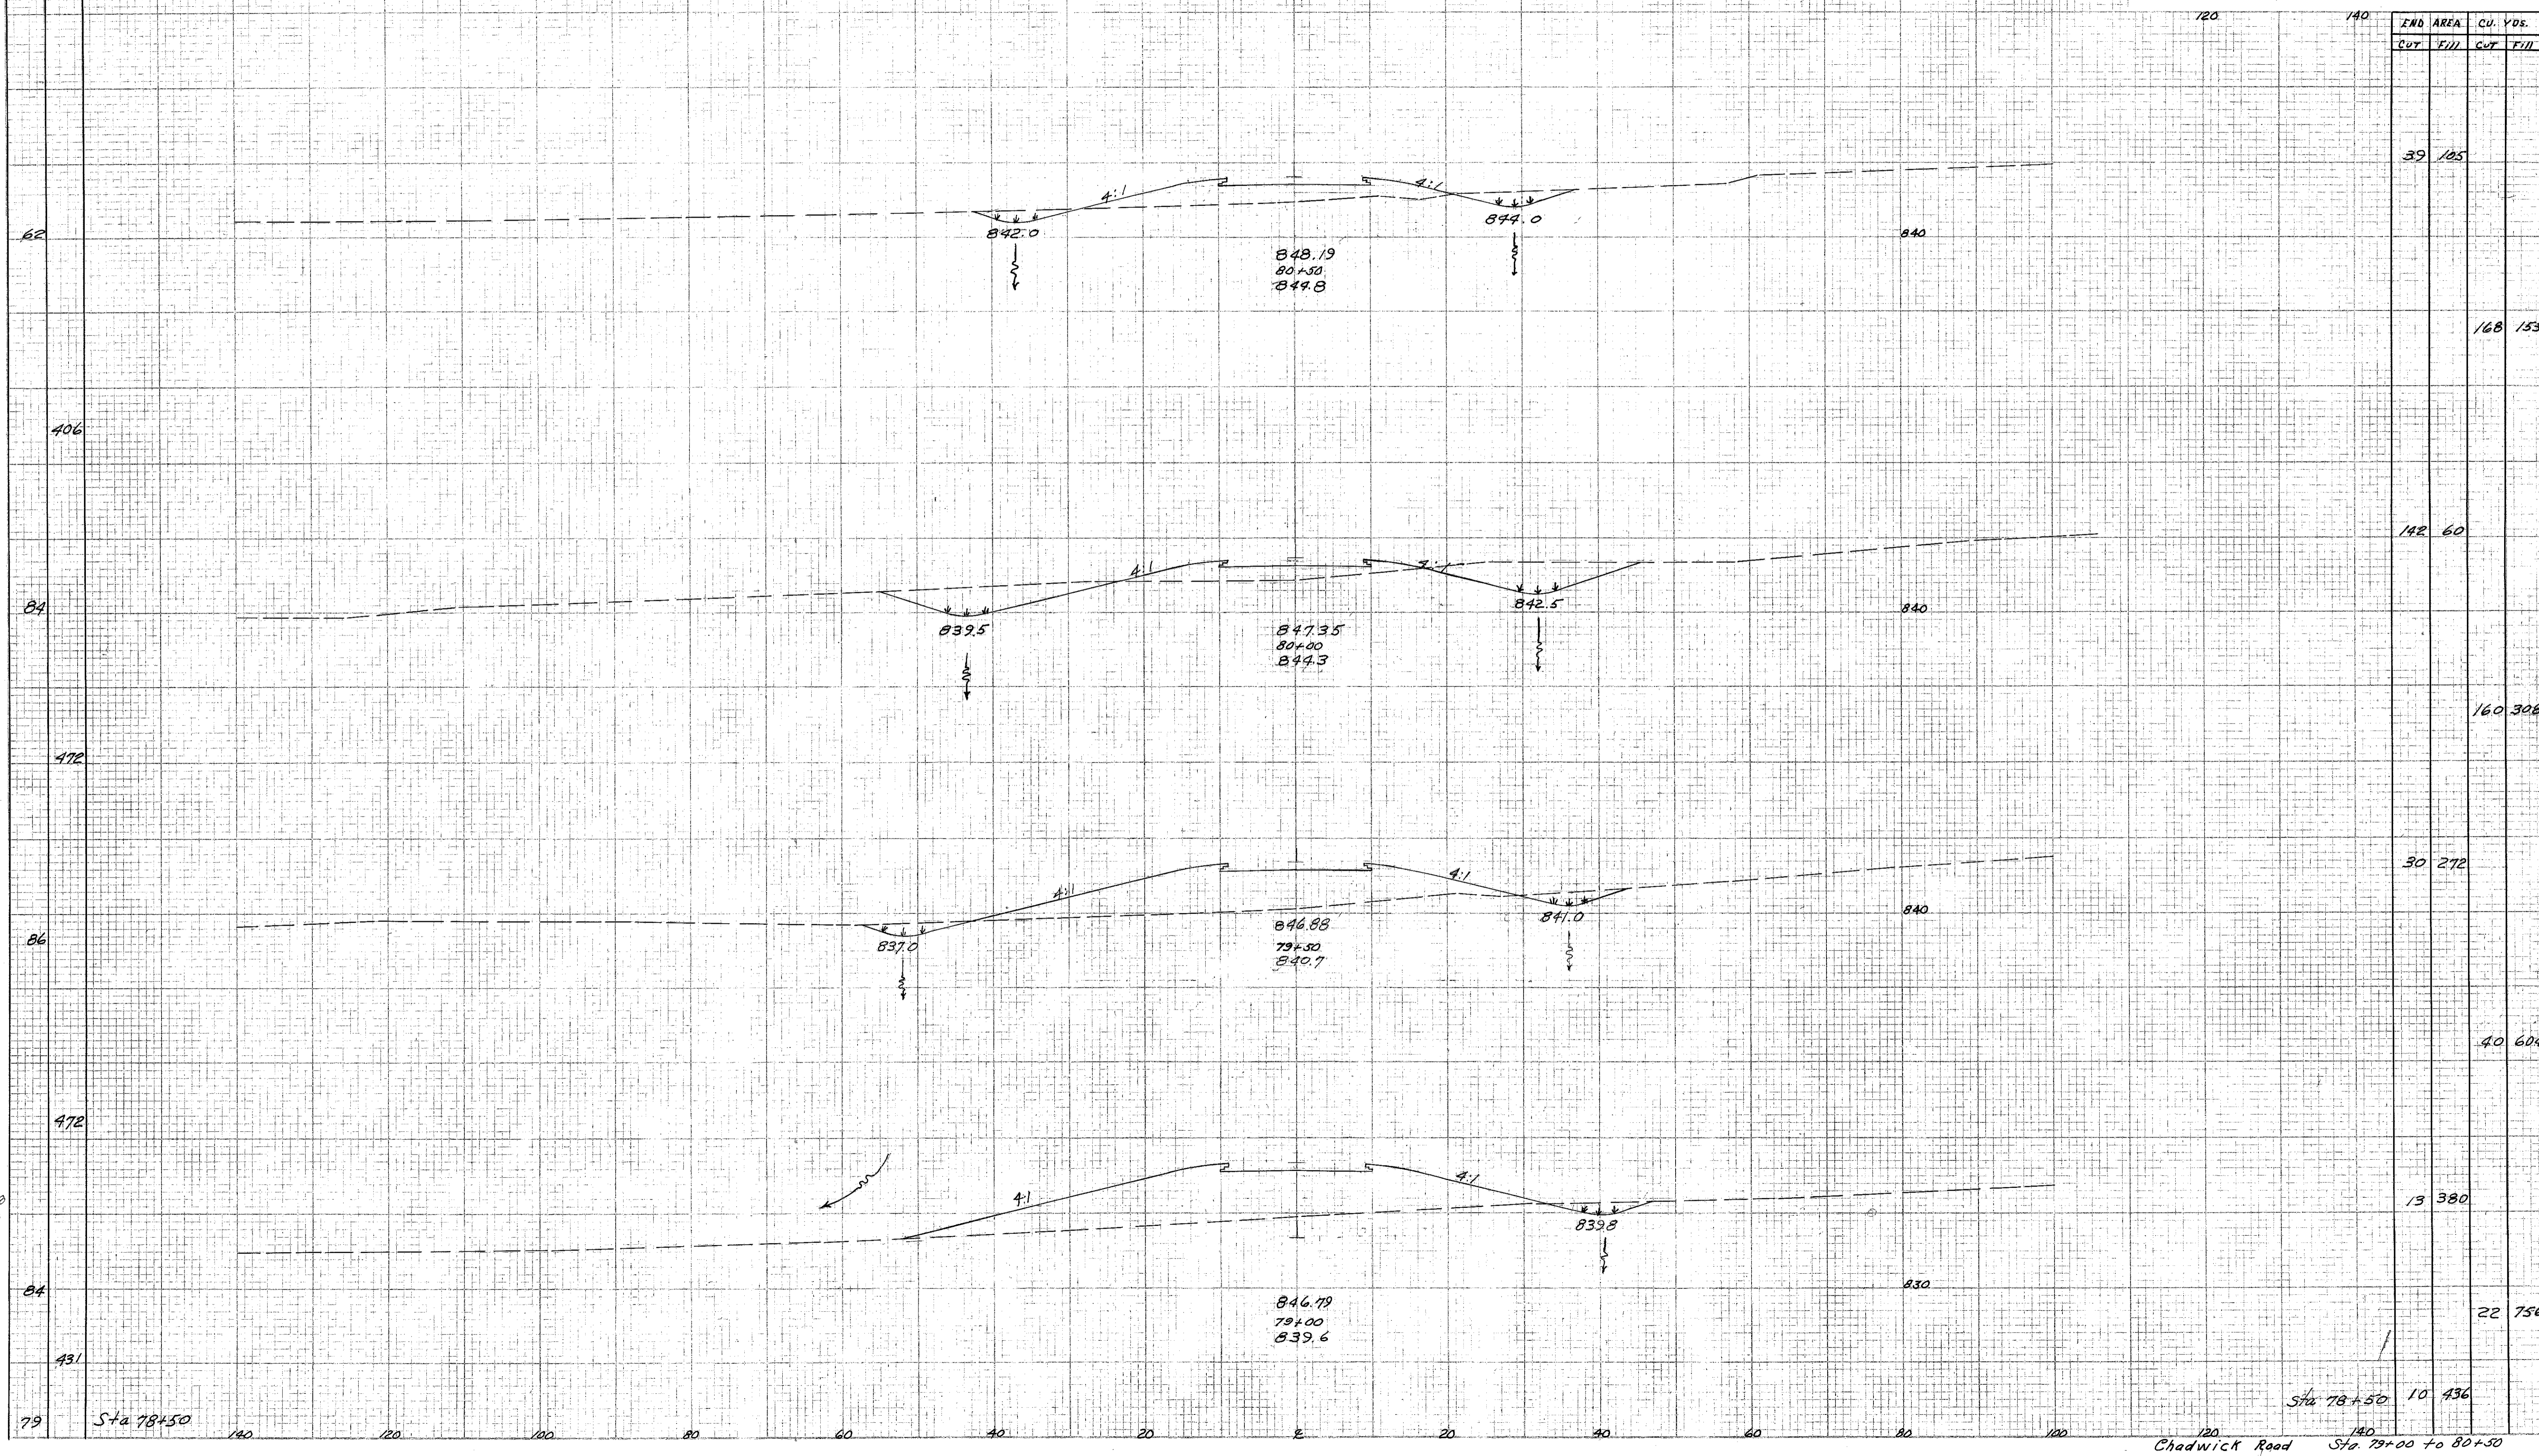

Revised EEC
5-1-58
MS-51-58