


LAKE COUNTY
LAK-1-20.03

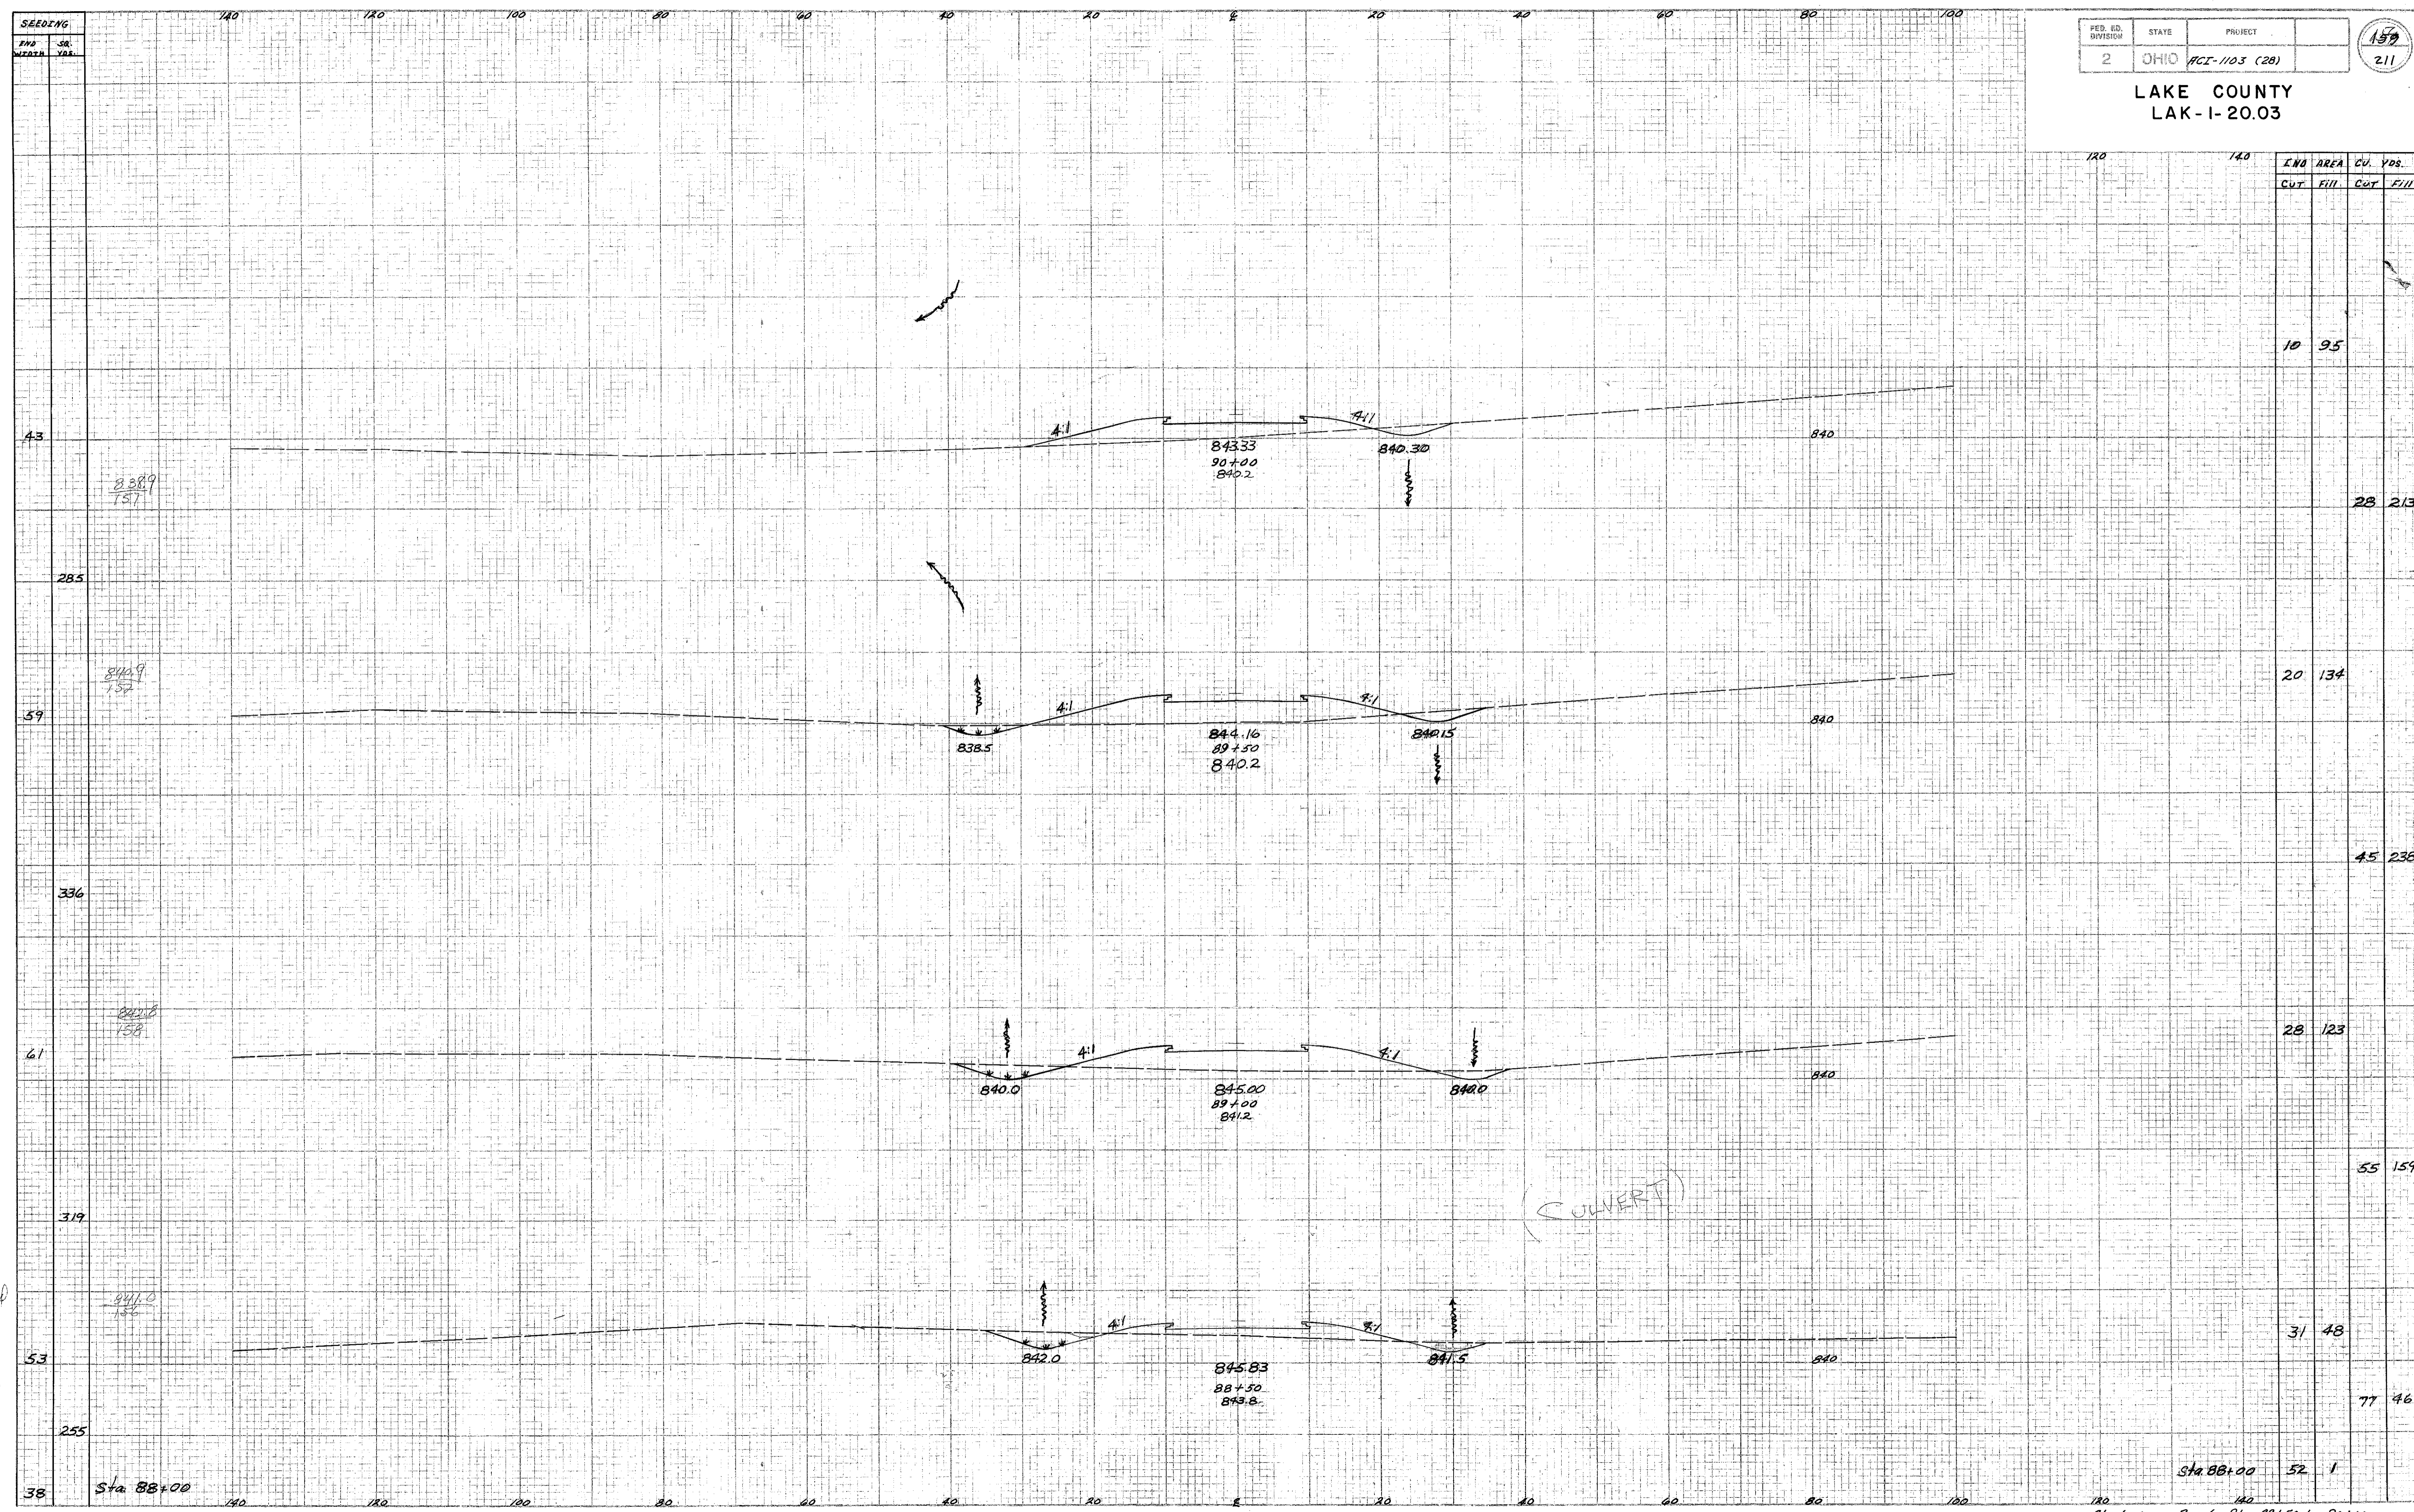

Revised
E.C.C.
4-30-58
Ckd. 5-1-58
By F.G.C.