
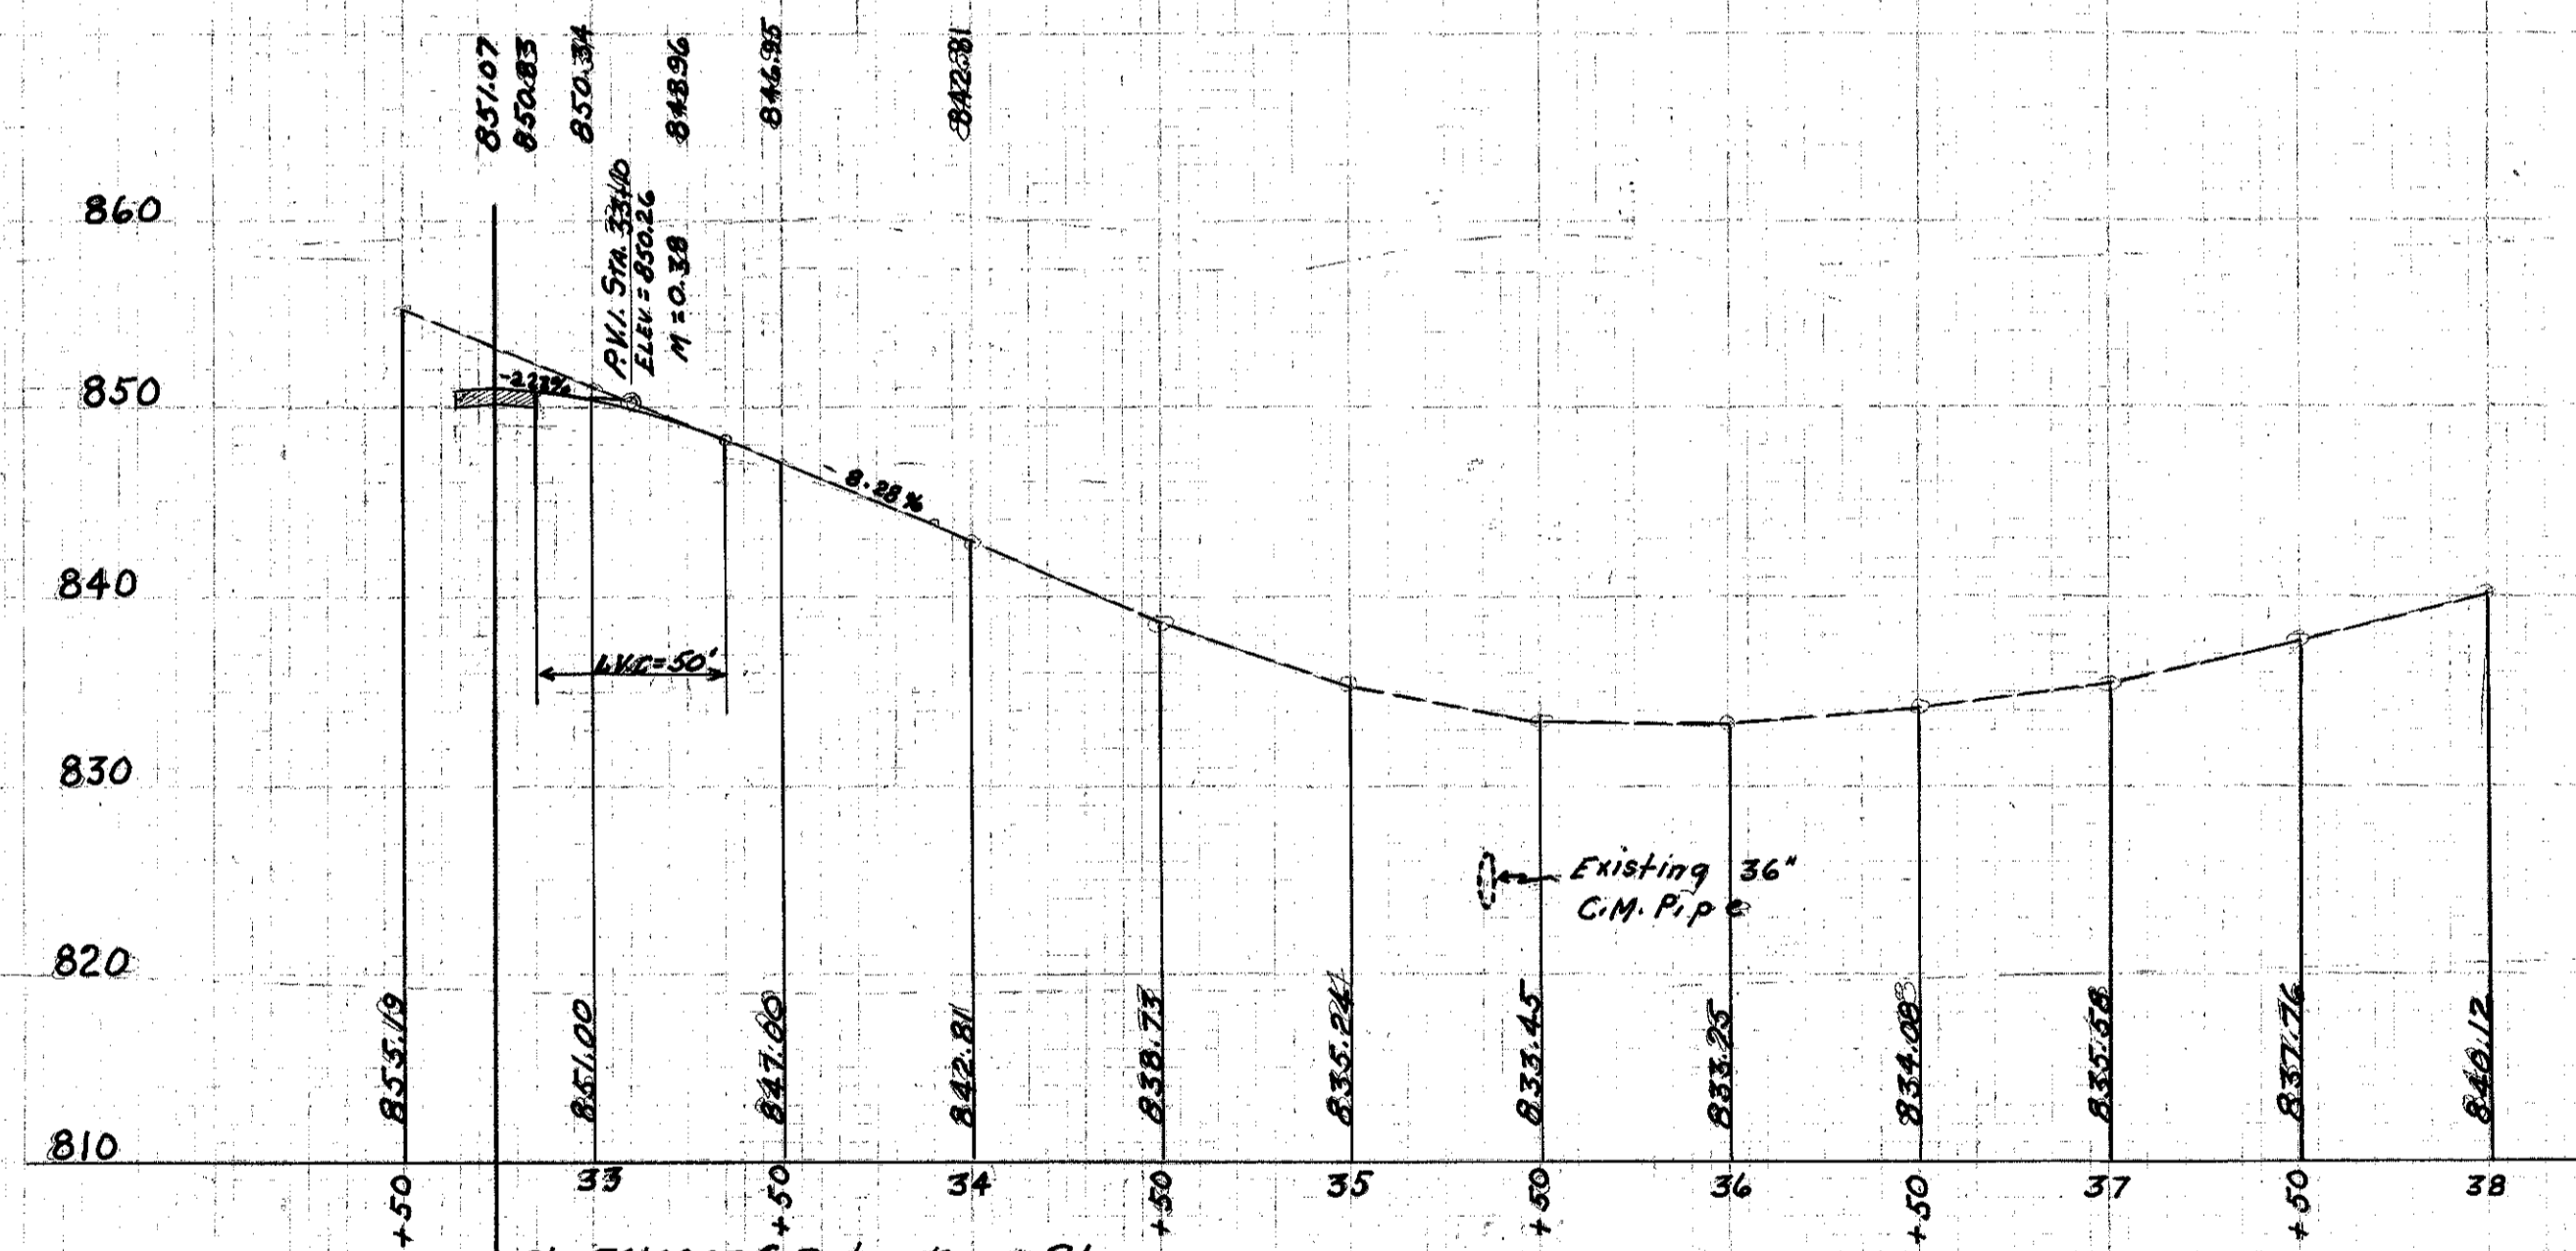


LAKE COUNTY
LAK-1-20-03

END STA.	AREA	CUT	FILL	YDS.

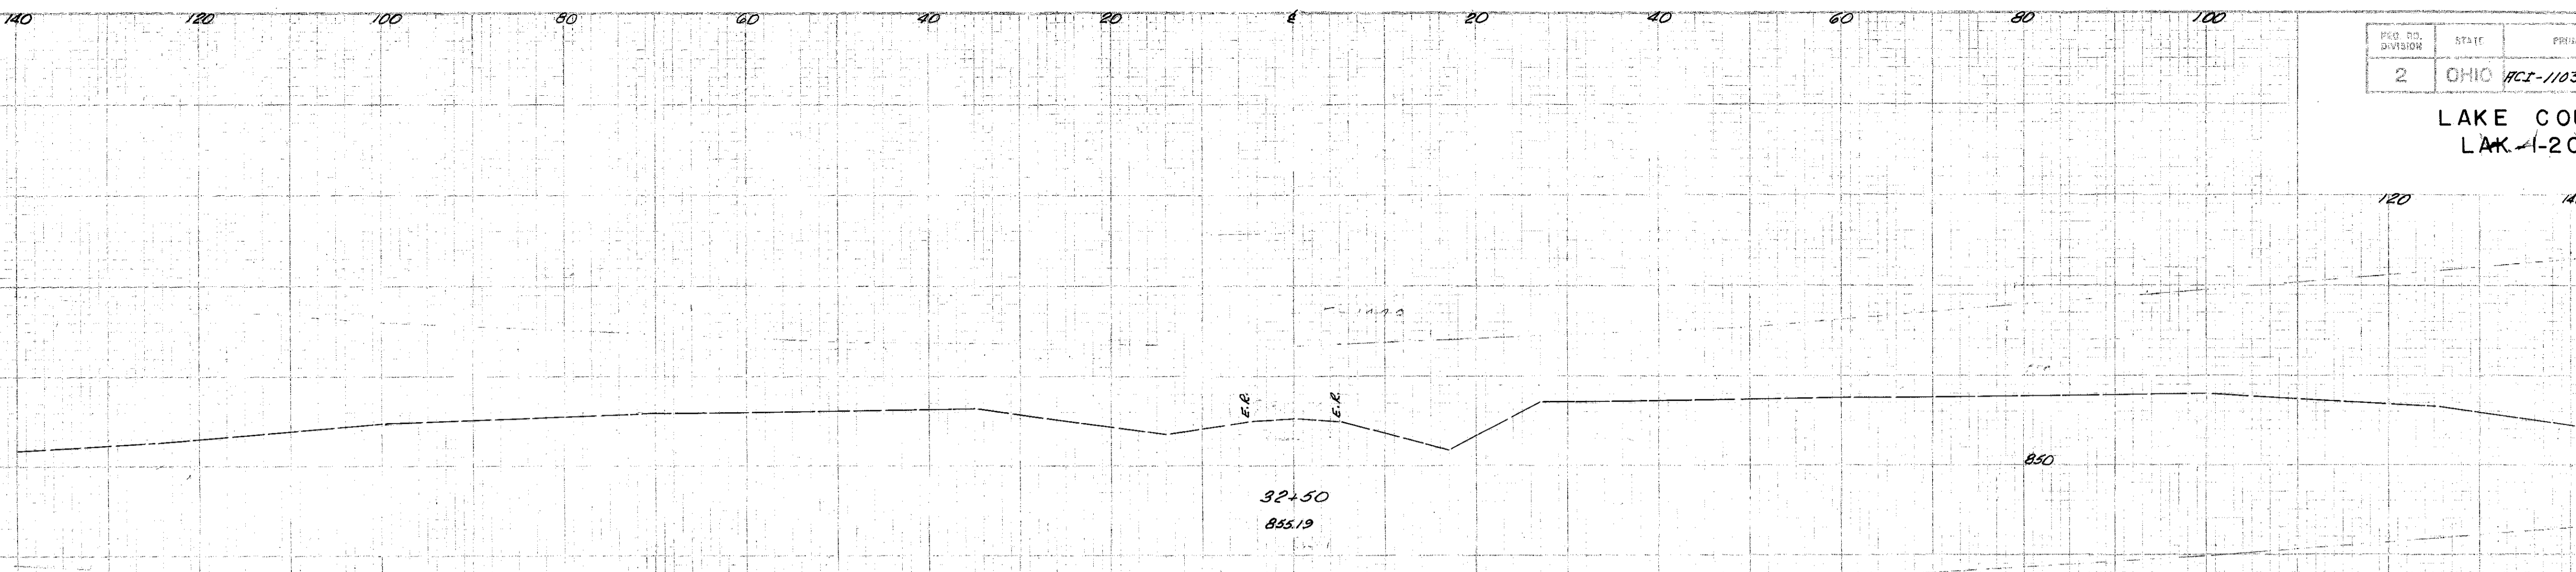

Existing TRASK ROAD
SCALE: 1" = 50' Horiz.
1" = 10' Vert.

REVISED 5/6/58 W.C.H.
5-6-58 R.D.C.

5/6/58