





PLAN - TOP LATERALS & FLOOR SYSTEM

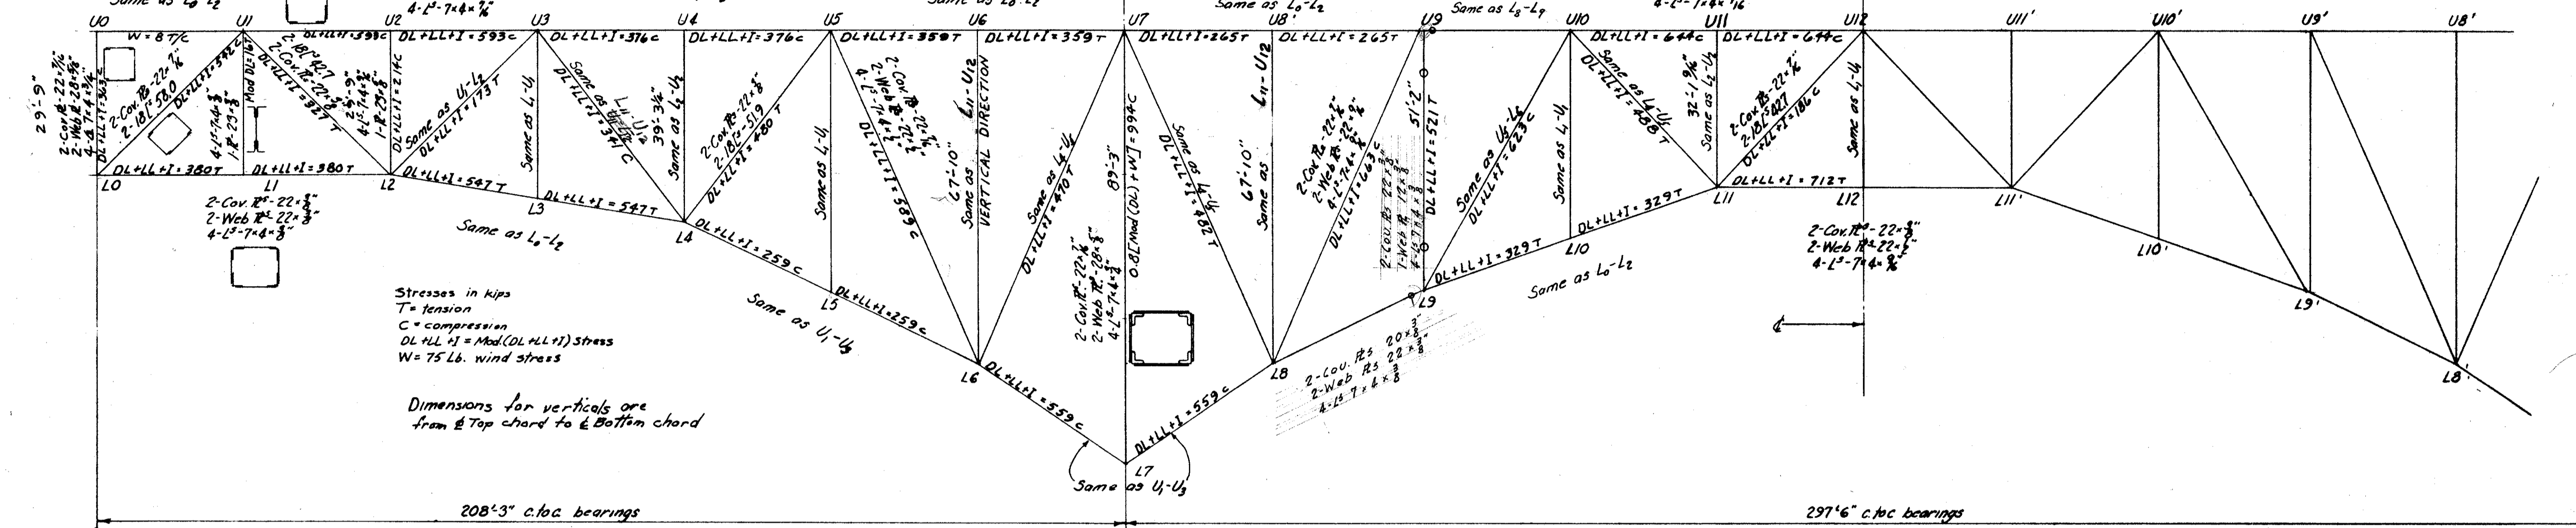

ELEVATION

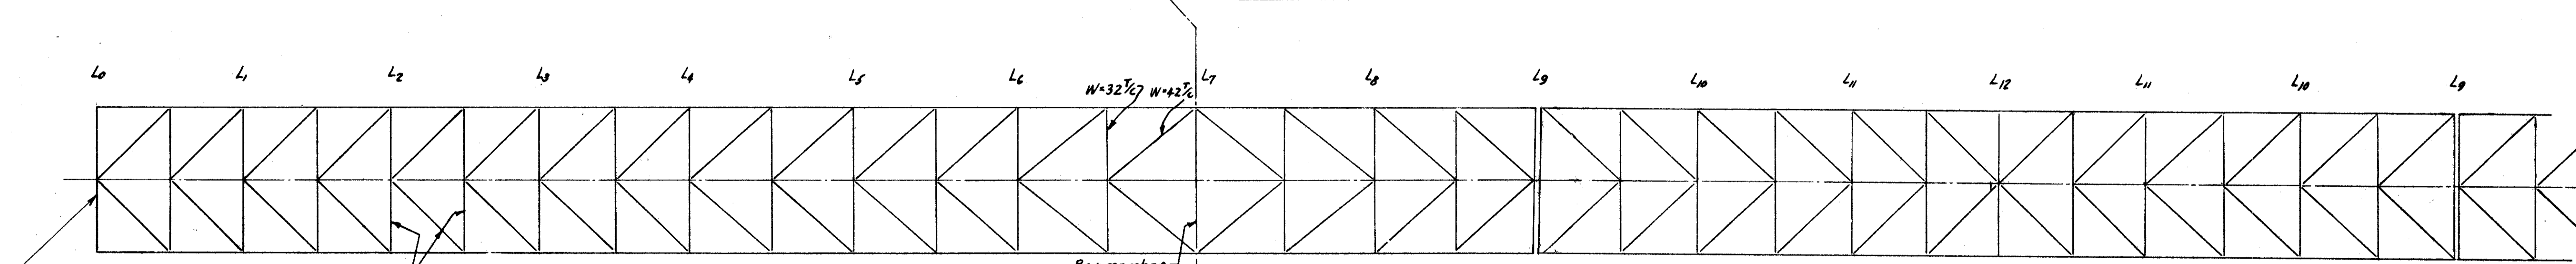

PLAN - BOTTOM LATERAL BRACING (Developed)

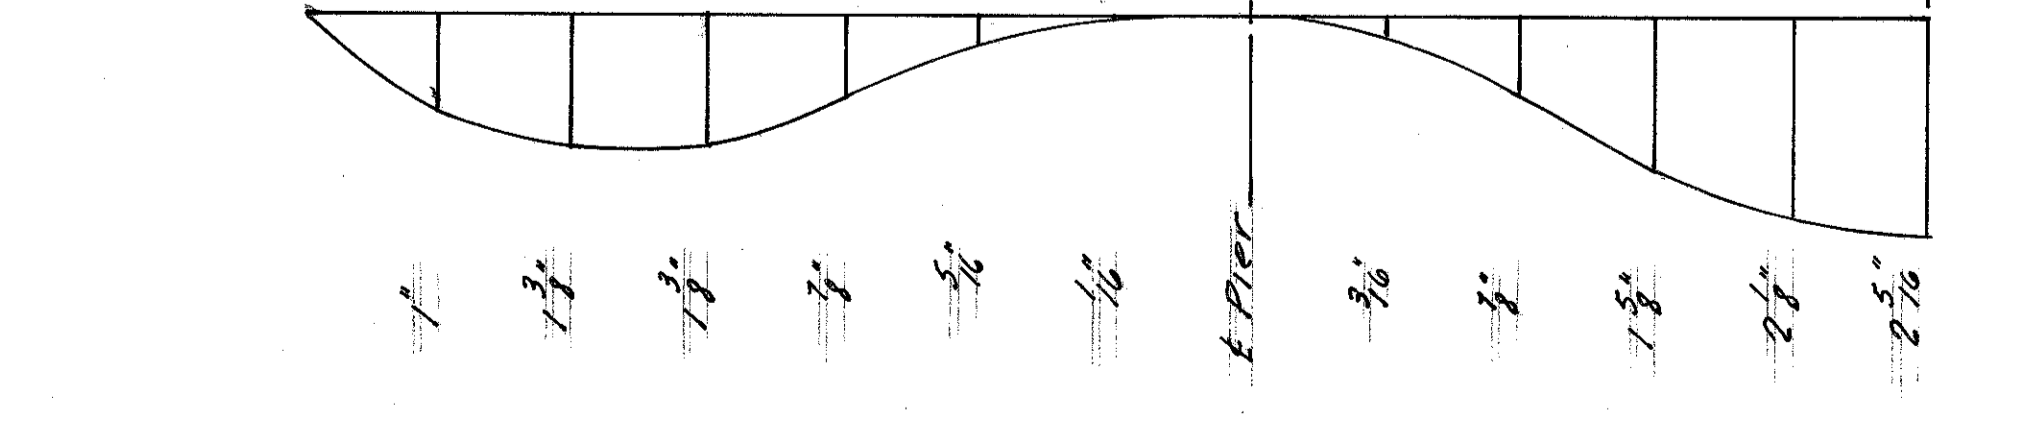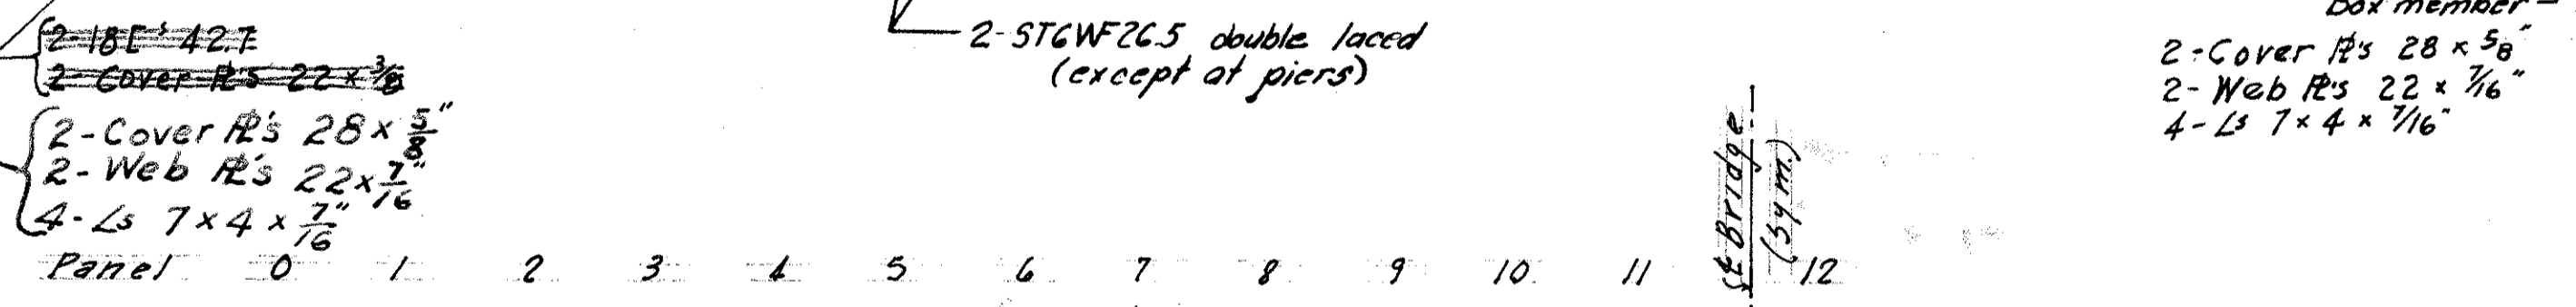

This sheet is to be used for construction and supersedes Sheet No. (44) of the Bidding Plans.

SEC. 674-B FED AID PROJ. ACI-1103(30)

PREPARED BY
 CAPITOL ENGINEERING ASSOCIATES, DILLSBURG, PA.
 FOR

STATE OF OHIO
 DEPARTMENT OF HIGHWAYS

FRAMING PLAN & STRESS SHEET
 BRIDGE NO. LAK-1-2252
 OVER GRAND RIVER
 LAKE COUNTY

DESIGNED	DRAWN	TRACED	CHECKED	REVISED DATE	REVISED
				2-2-59	9-16-59

Rev. 2-2-59

STA. 677+75.00