


SEEDING
END Sta.
VERTICAL Yds.

LAKE COUNTY
LAK - I - 22.60

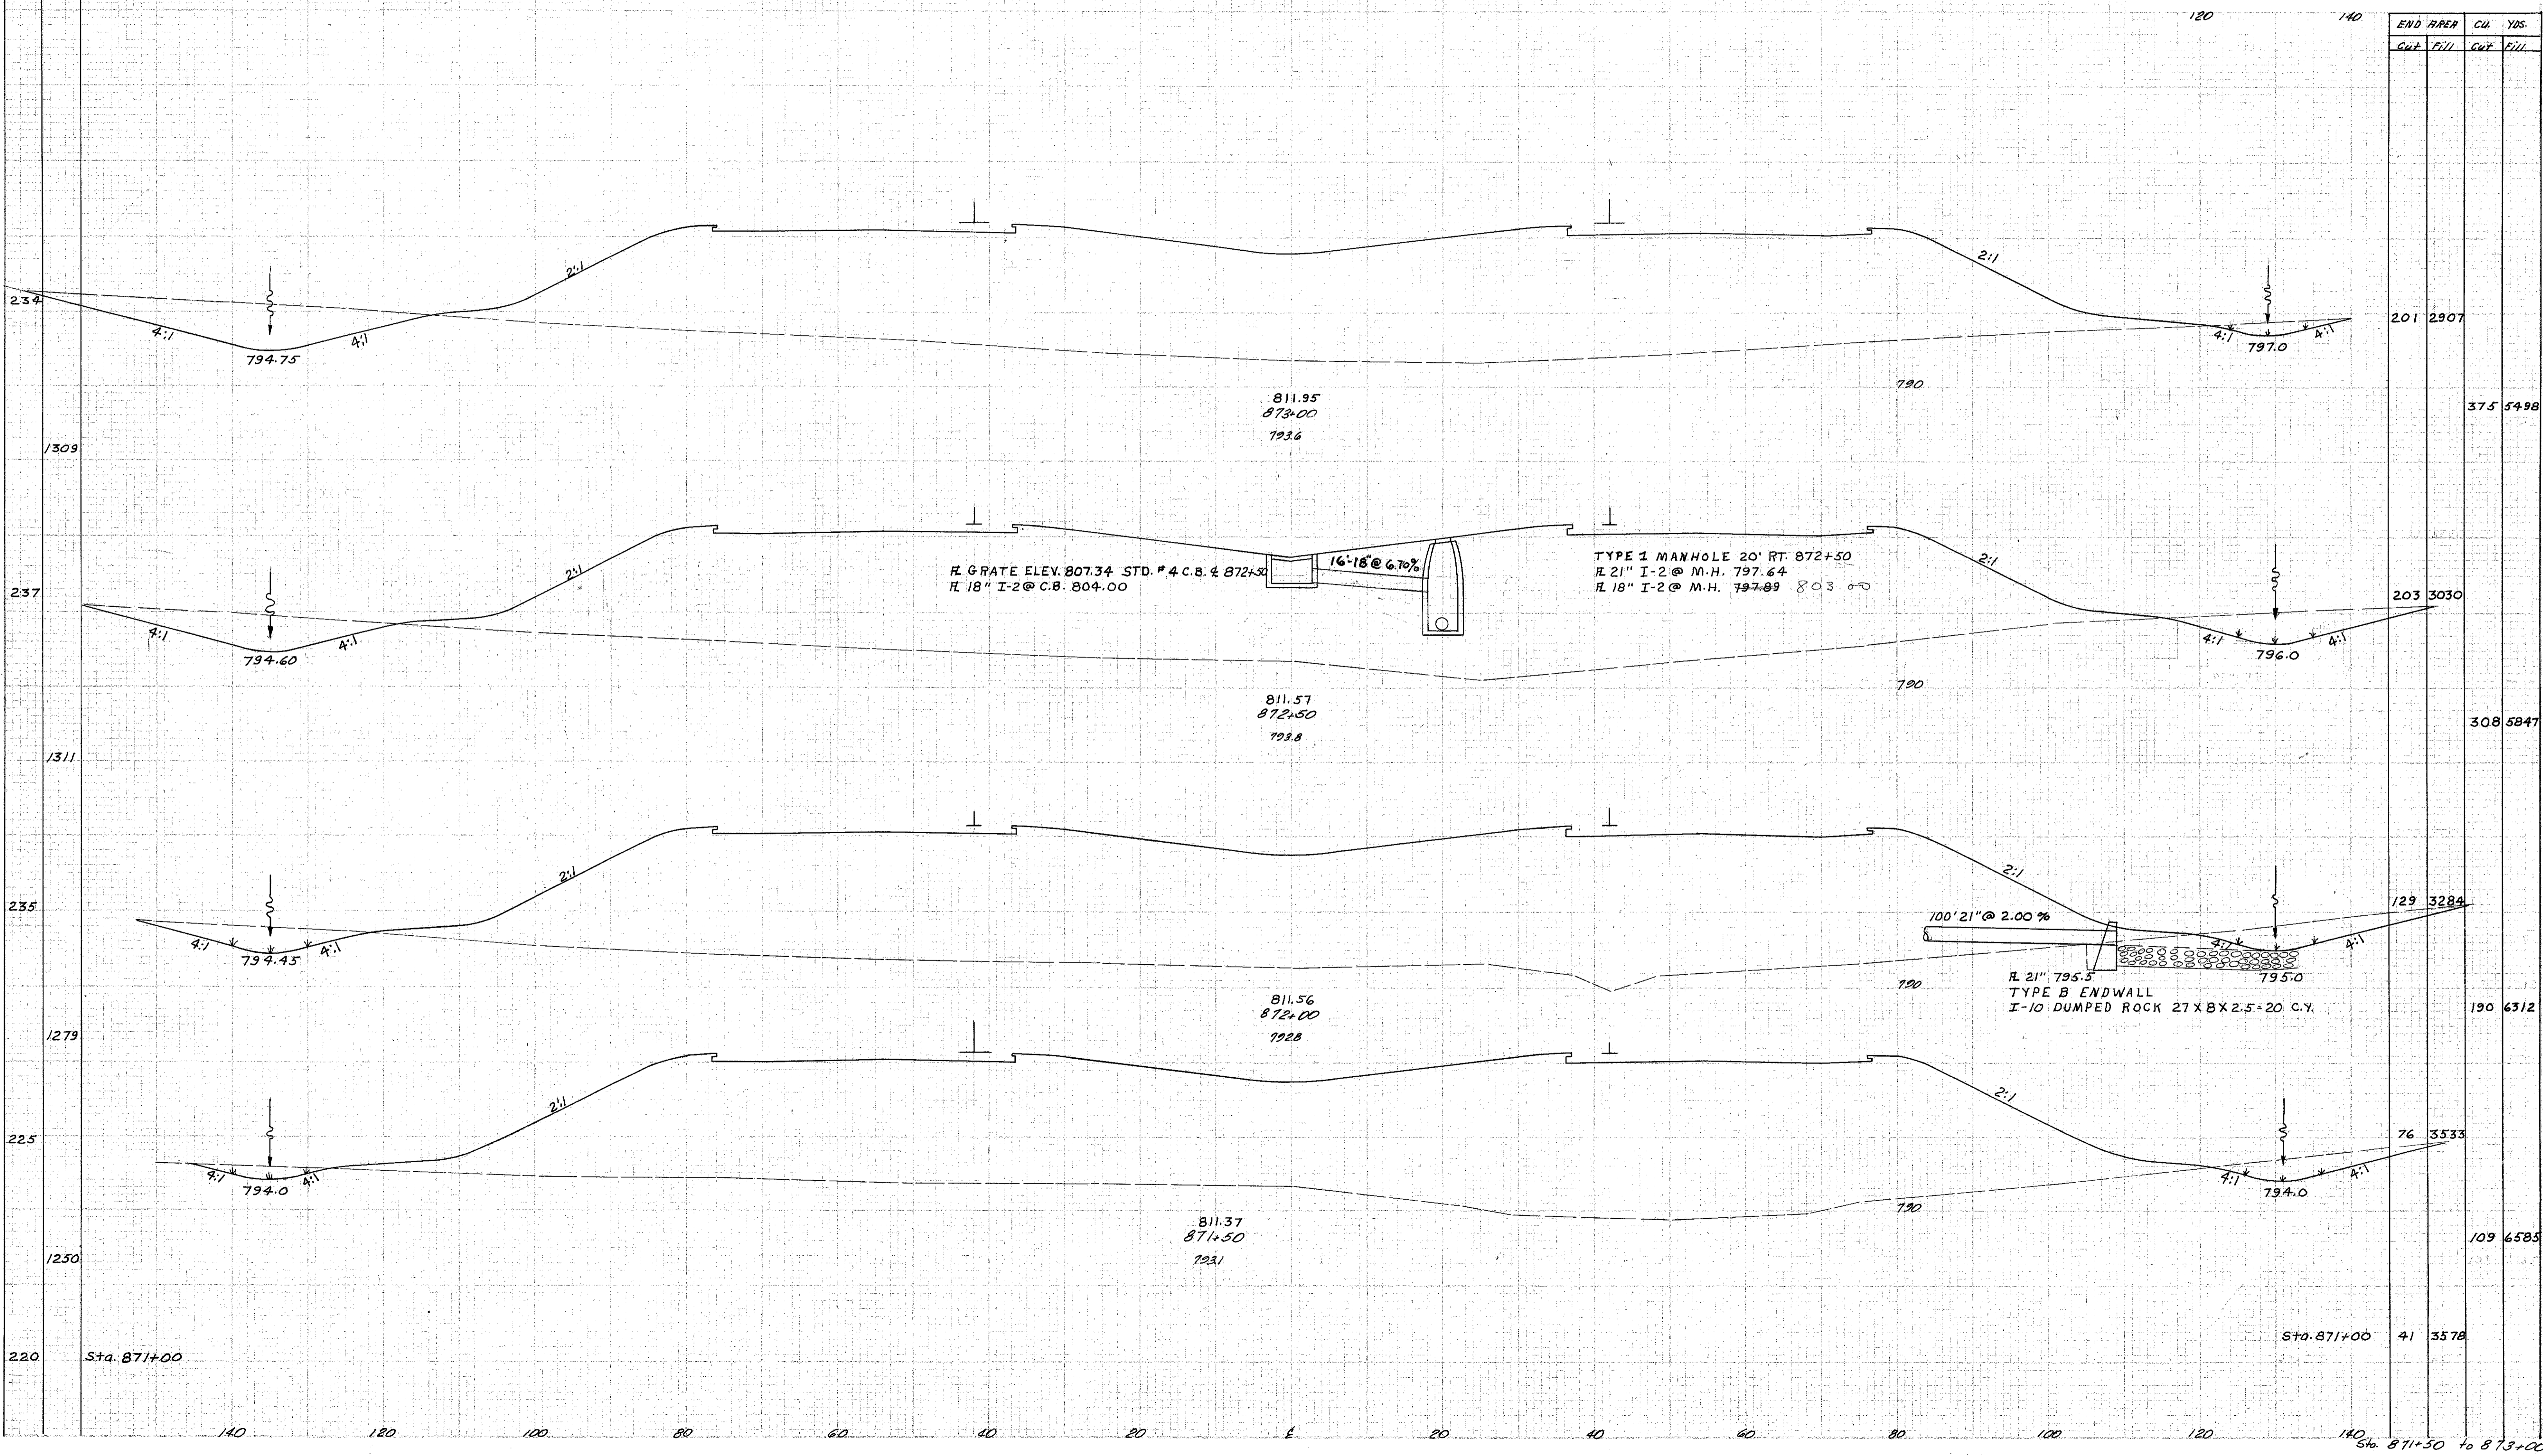

Cut	Fill	Cut	Fill
201	2907	375	5498
203	3030	308	5847
129	3284	190	6312
76	3533	109	6585
41	3578		

Rev.
4-30-58

Sta. 871+00

Sta. 871+00

Sta. 871+50 to 873+00