


SEEDING

END WIDTH SQ

PROJ. NO.	STATE	PROJECT
2	OHIO	ACT-1103.C293

173
280

LAKE COUNTY
LAK-1-2260

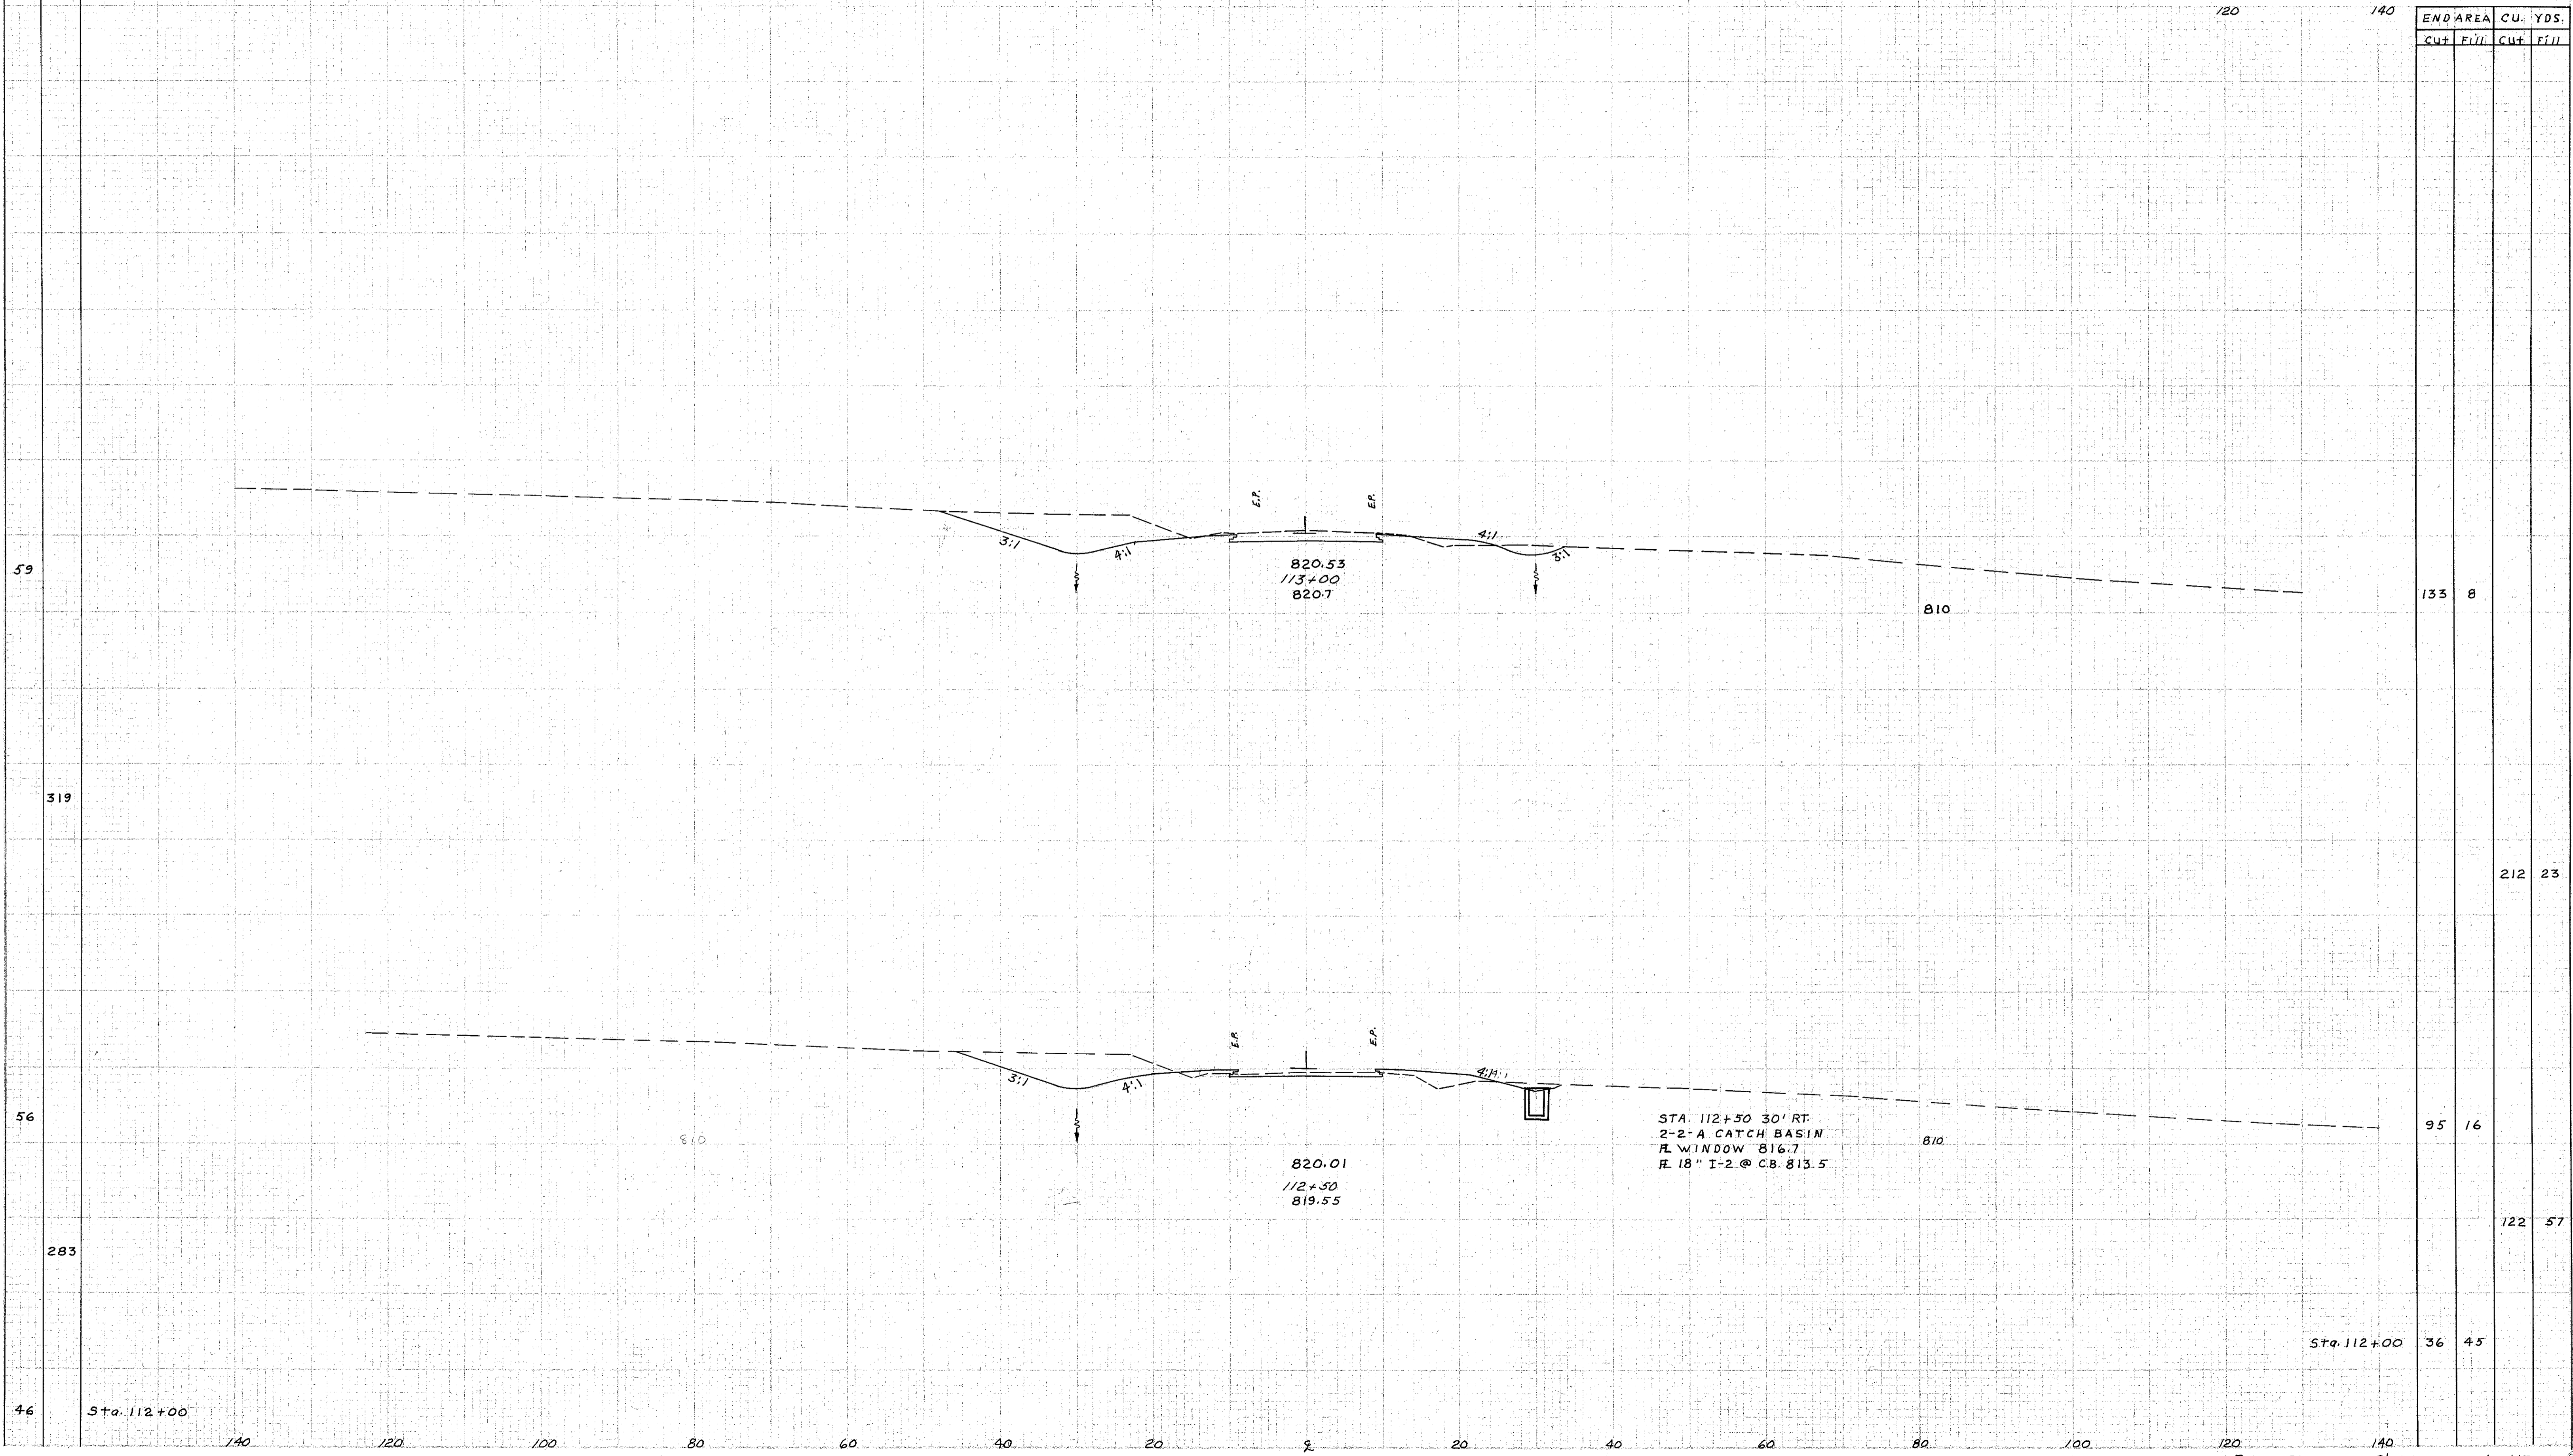

END AREA		CU. YDS.	
Cut	Fill	Cut	Fill
133	8		
		212	23
95	16		
		122	57
Sta. 112+00	36	45	

Handwritten note: Check 5'-22-58 and 5'-22-58

STA. 112+50 30' RT.
2-2-A CATCH BASIN
FL WINDOW 816.7
R. 18" I-2 @ CB 813.5

820.01
112+50
819.55

820.53
113+00
820.7