


SEEDING
END WIDTH
SQ. YDS.

FED. MP. DISTRICT	STATE	PROJECT
2	OHIO	ACI-1103 (29)

212
280

LAKE COUNTY
LAK-1-22.60

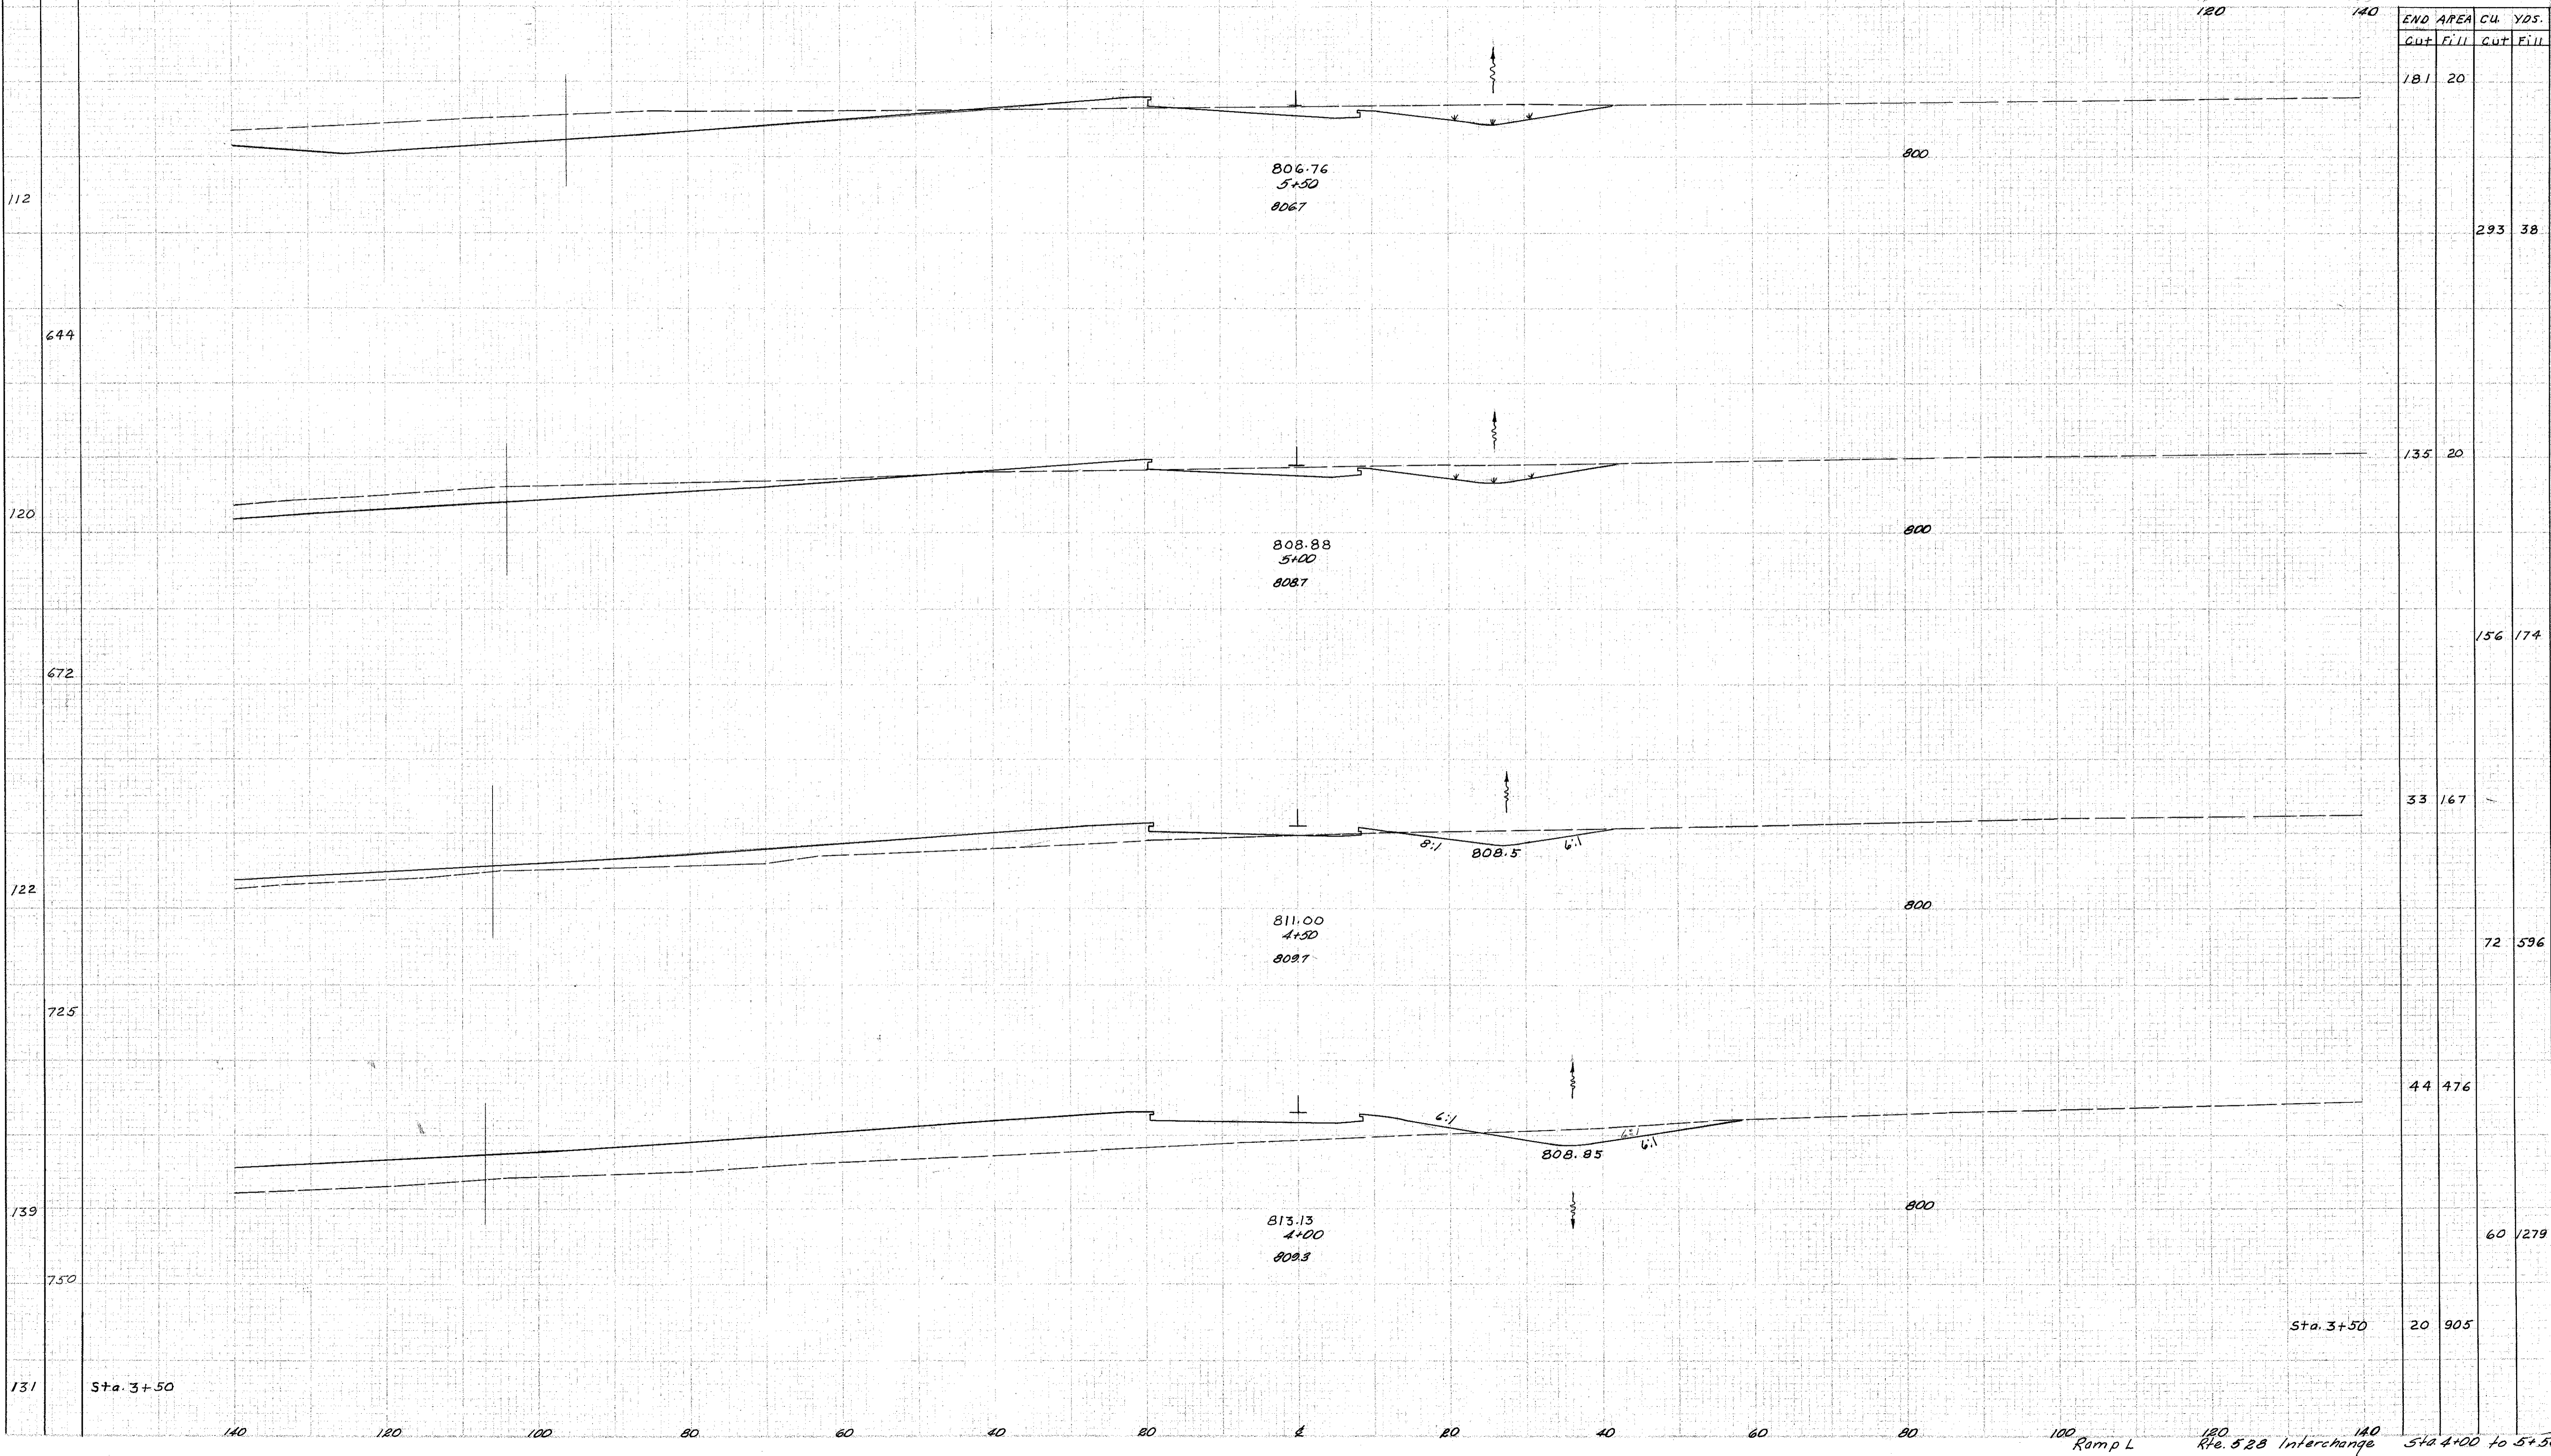

Amended DP 5-2-58
✓ P. 522-58

Proposed L1
with 125
by RR 1-31-58
checked by RR
2-3-58

100 Ramp L
120 Rte. 528 Interchange
140 Sta. 4+00 to 5+50