



LAKE COUNTY
LAK - 1-26-51
ASHTABULA COUNTY
ATB - 1-0.00

This sheet supersedes skm. 124 of the original plan.

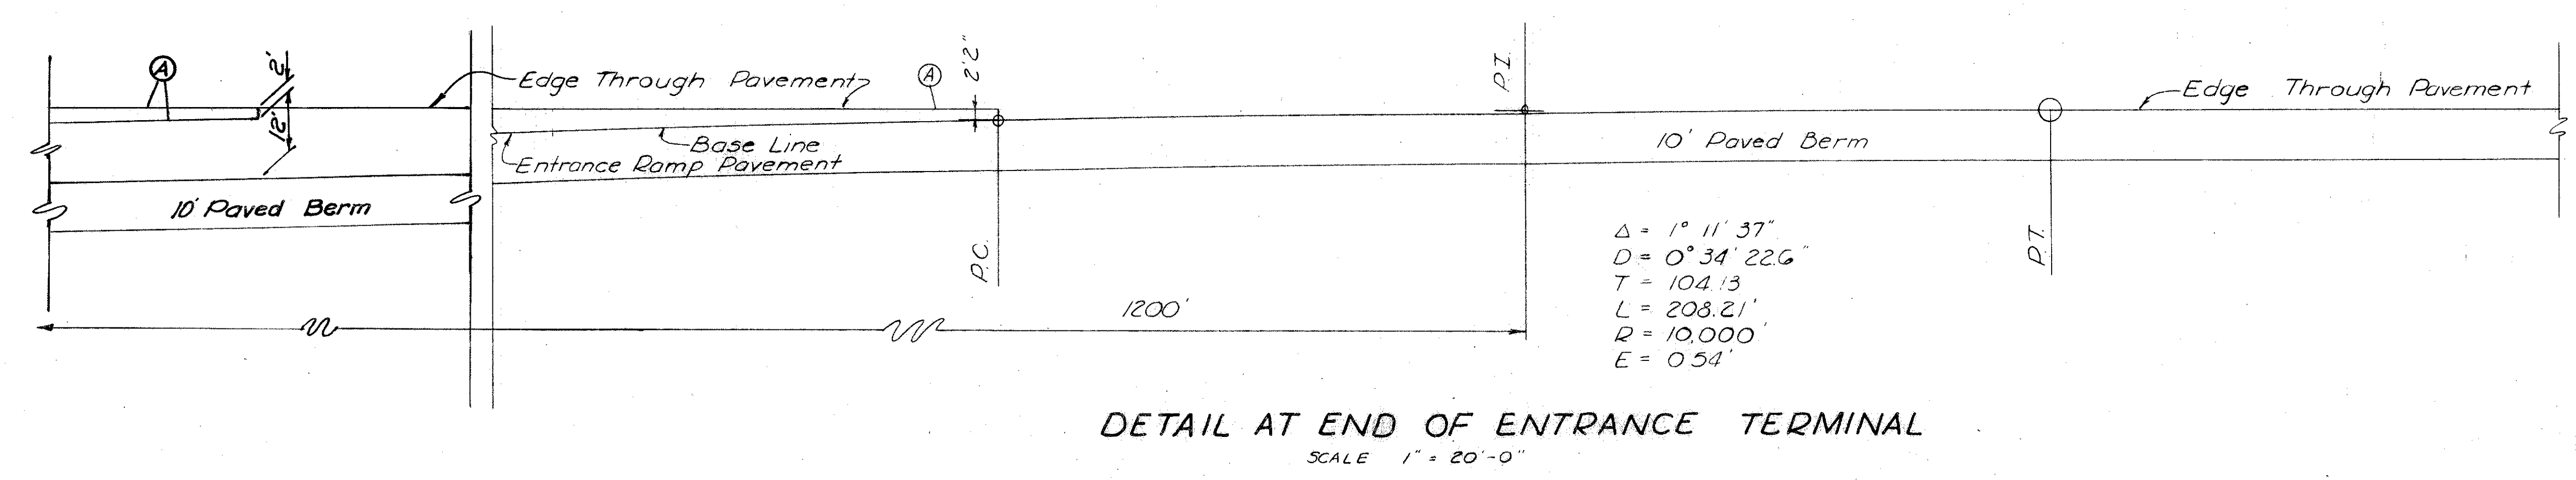

- Ⓐ Standard Longitudinal Joint
- Ⓑ Standard Key Joint Without Tie Bars
- Ⓒ Expansion Joint Without Dowels
- Ⓓ Standard Expansion Joint
- Ⓔ Standard Contraction Joint

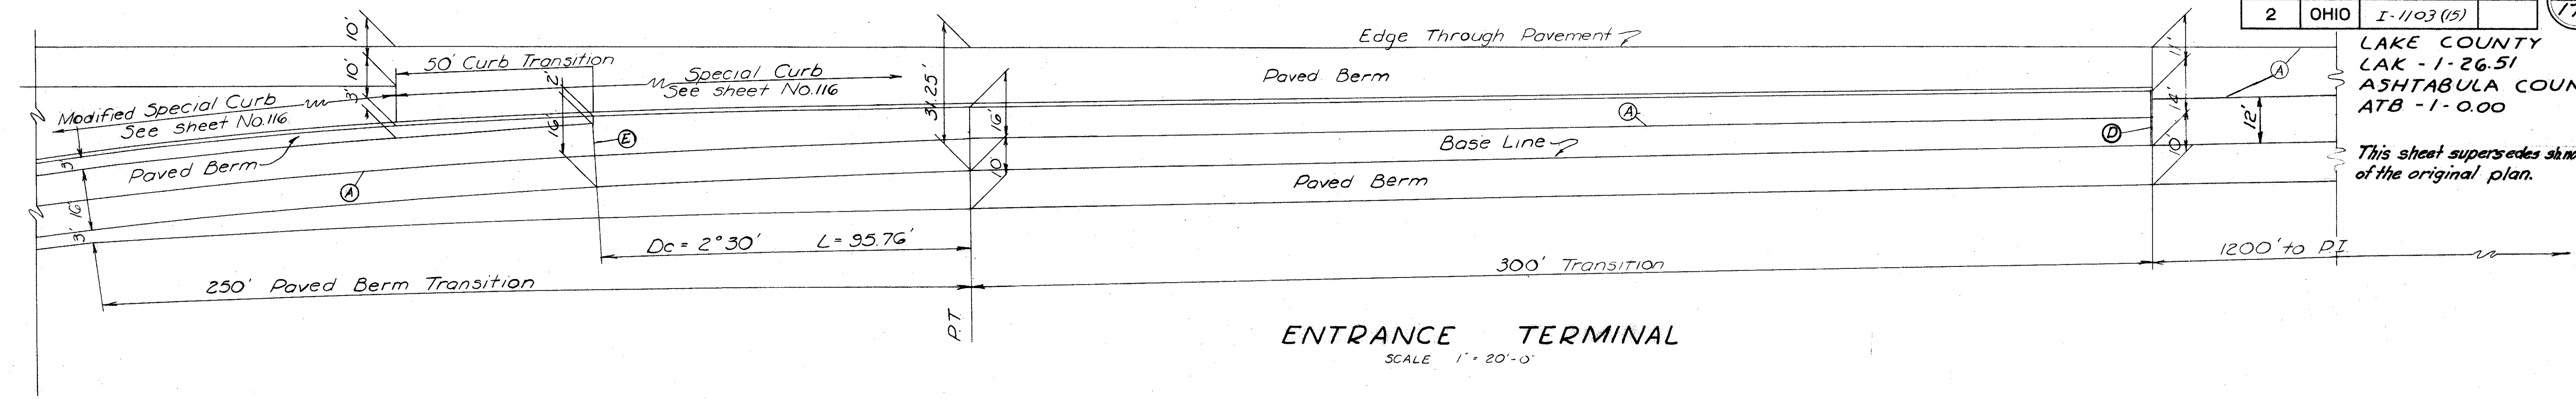